


48-59 W

COUNTY SURVEYORS FILE DATA  
DO NOT REMOVE FROM OFFICE

FILED  
RECEIVED WRS  
JUN 14 1977  
COUNTY SURVEYOR  
DOUGLAS COUNTY, ORE.  
MC

MAP FILE M 65-24

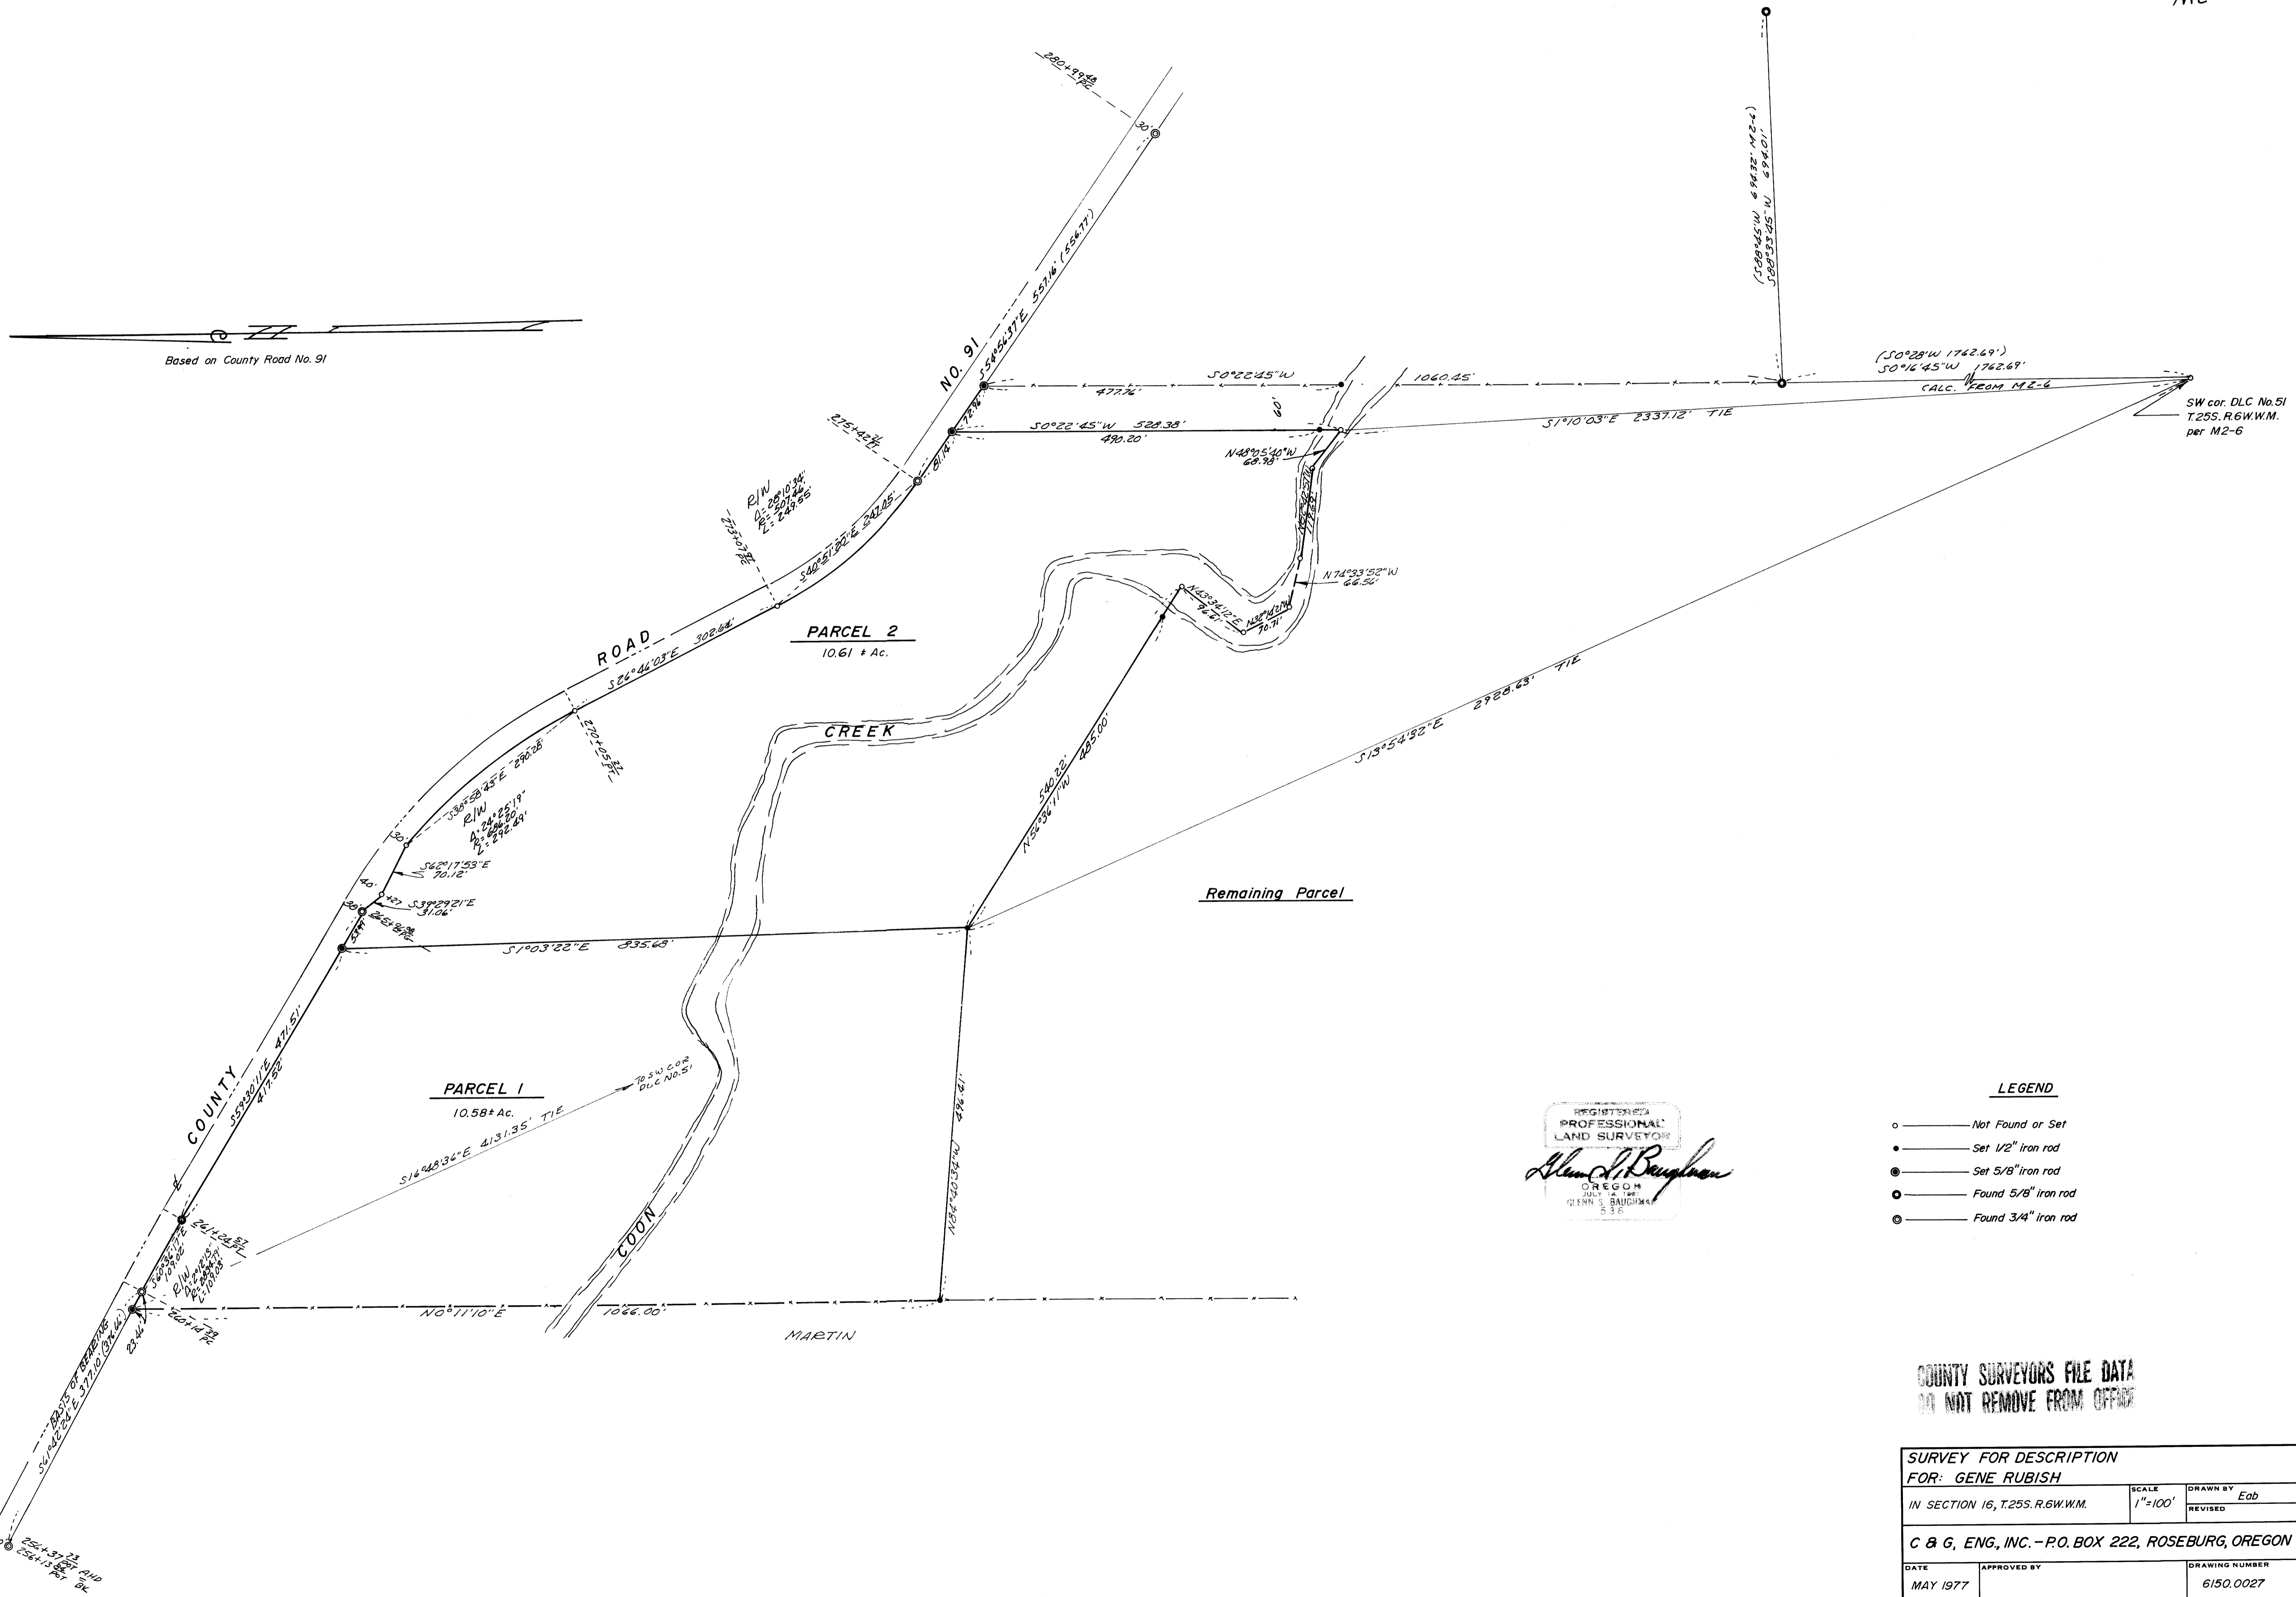

COUNTY SURVEYORS FILE DATA  
DO NOT REMOVE FROM OFFICE

SURVEY FOR DESCRIPTION FOR: GENE RUBISH		
IN SECTION 16, T.25S. R.6W.W.M.	SCALE 1"=100'	DRAWN BY Eob
C & G, ENG., INC. - P.O. BOX 222, ROSEBURG, OREGON		
DATE MAY 1977	APPROVED BY	DRAWING NUMBER 6150.0027

MAP FILE M 65-24

MADE IN U.S.A.

MAP FILE M 65-24