


COUNTY SURVEYORS FILE DATA
DO NOT REMOVE FROM OFFICE

FILED ✓
RECEIVED ✓h
JUN 29 1977
COUNTY SURVEYOR
DOUGLAS COUNTY, ORE.
✓

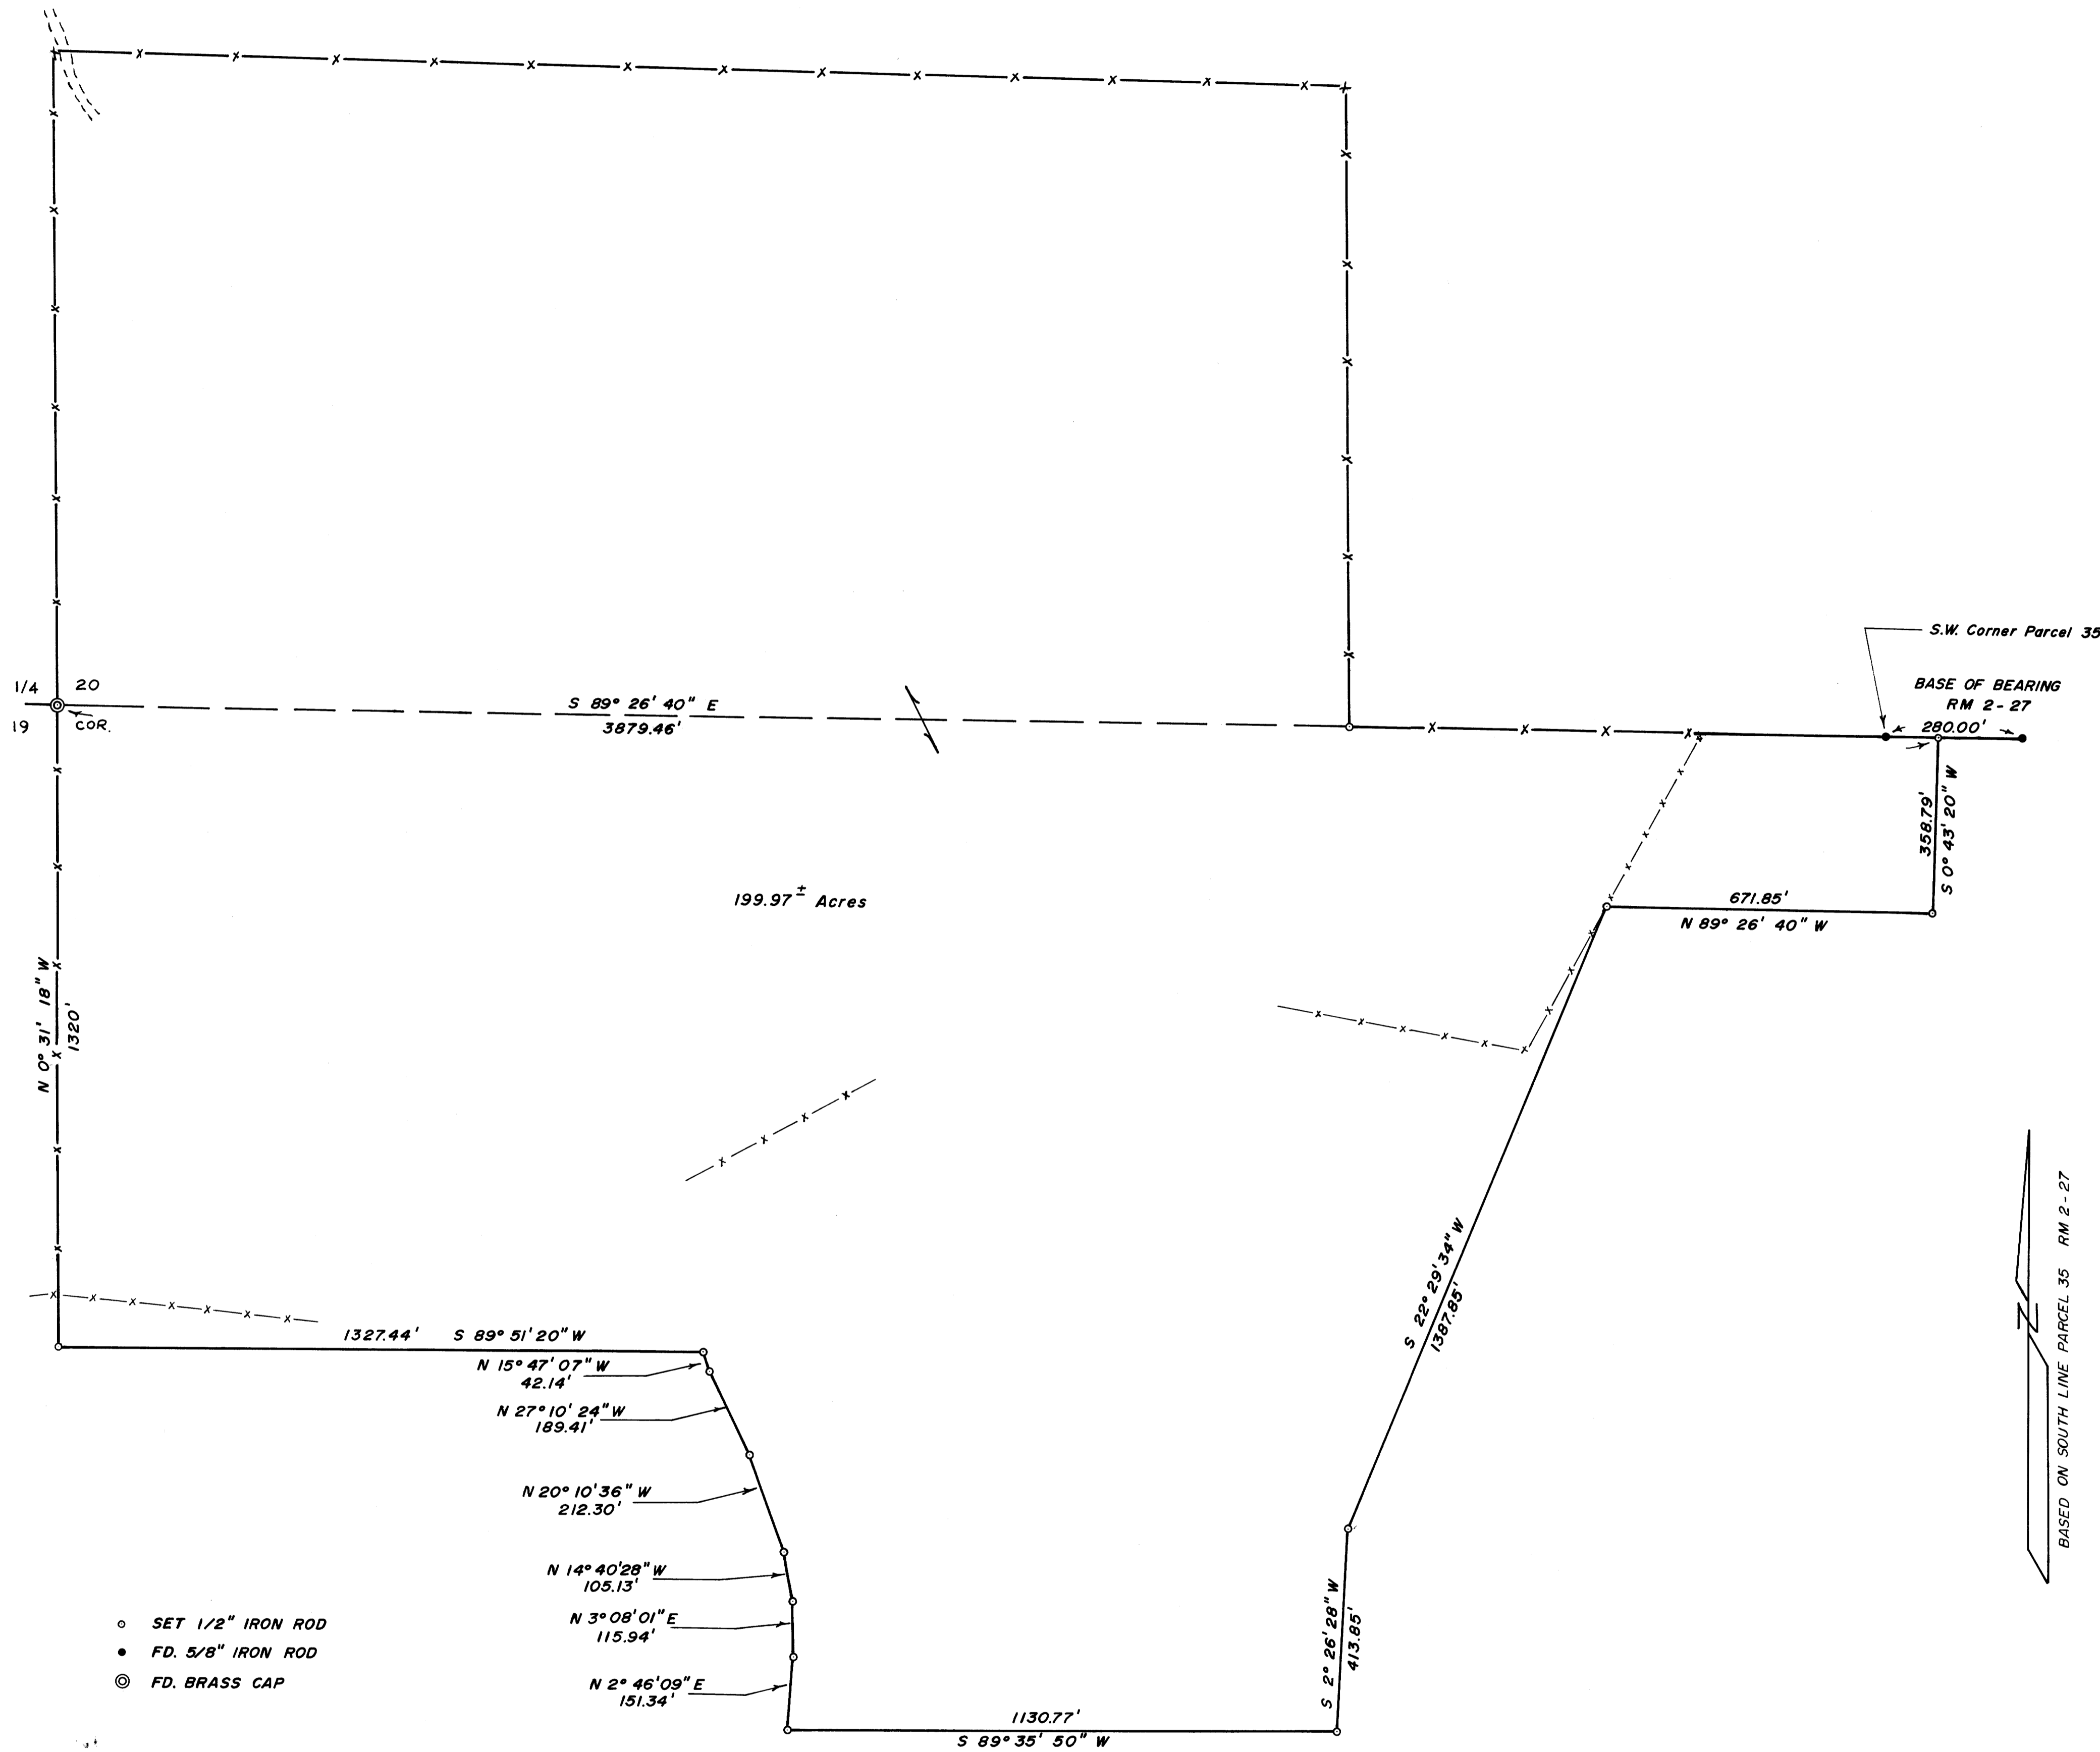

- SET 1/2" IRON ROD
- FD. 5/8" IRON ROD
- ◎ FD. BRASS CAP

REGISTERED
PROFESSIONAL
LAND SURVEYOR

Glenn S. Baughman

OREGON
JULY 14 1961
GLENN S. BAUGHMAN
536

COUNTY SURVEYORS FILE DATA
DO NOT REMOVE FROM OFFICE

SURVEY FOR DESCRIPTION FOR: FRANCIS LIVINGSTON		
IN SEC. 20, T. 26 S. R. 3 W., W.M.	SCALE 1" = 200'	DRAWN BY GIB REVISED
C & G ENG., INC. - P.O. BOX 222, ROSEBURG, OR		
DATE JUNE, 1977	APPROVED BY	DRAWING NUMBER 6150.0040