


Based on ME4-58

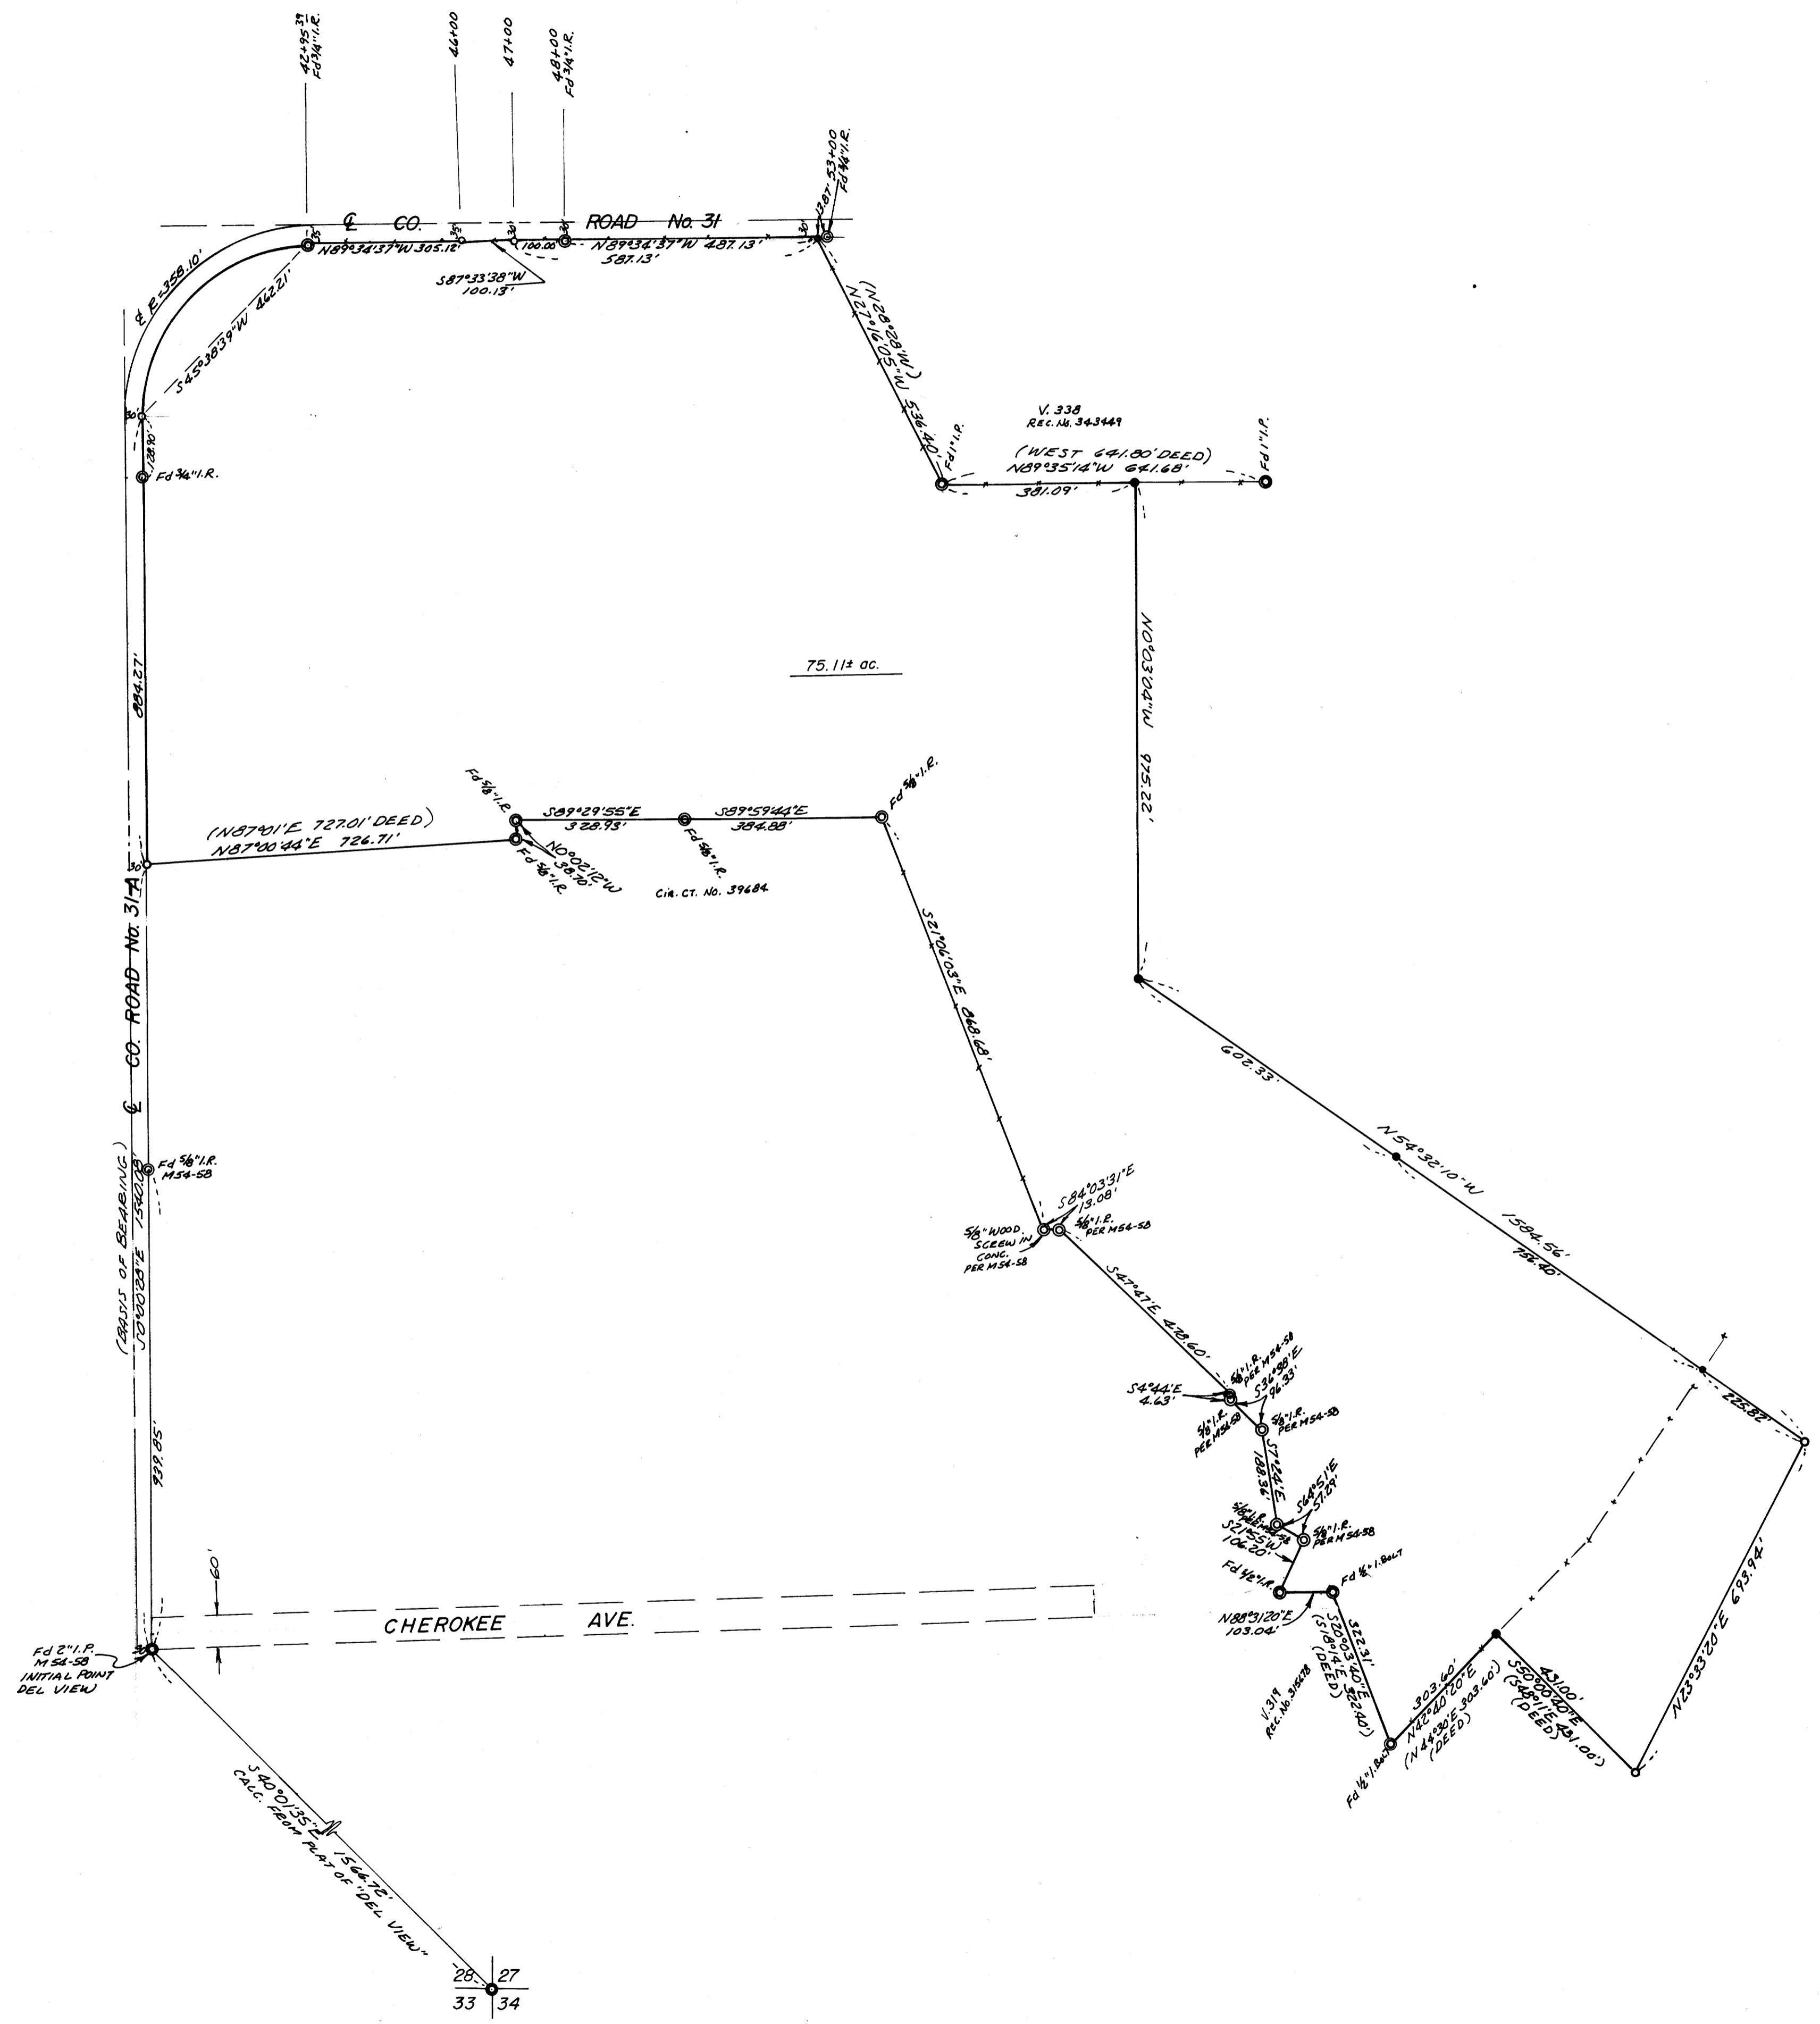

LEGEND

- — Set 5/8" iron rod
- — Point not set or found
- ⊙ — Point found—as noted

REGISTERED
PROFESSIONAL
LAND SURVEYOR
Glenn S. Baughman
OREGON
JULY 18, 1961
GLENN S. BAUGHMAN
D.P.S. 36

COUNTY SURVEYORS FILE DATA
DO NOT REMOVE FROM OFFICE

SURVEY FOR DESCRIPTION IN SECTIONS 27 & 28, T.26S. R.6W. W.M.		
FOR: NAZARENE CHURCH	SCALE 1"=200'	DRAWN BY Eab
C & G ENGINEERING INC.—ROSEBURG, OREGON		REVISED
DATE JULY 1977	APPROVED BY	DRAWING NUMBER 6150.0037