


MAP FILE 11 65-52

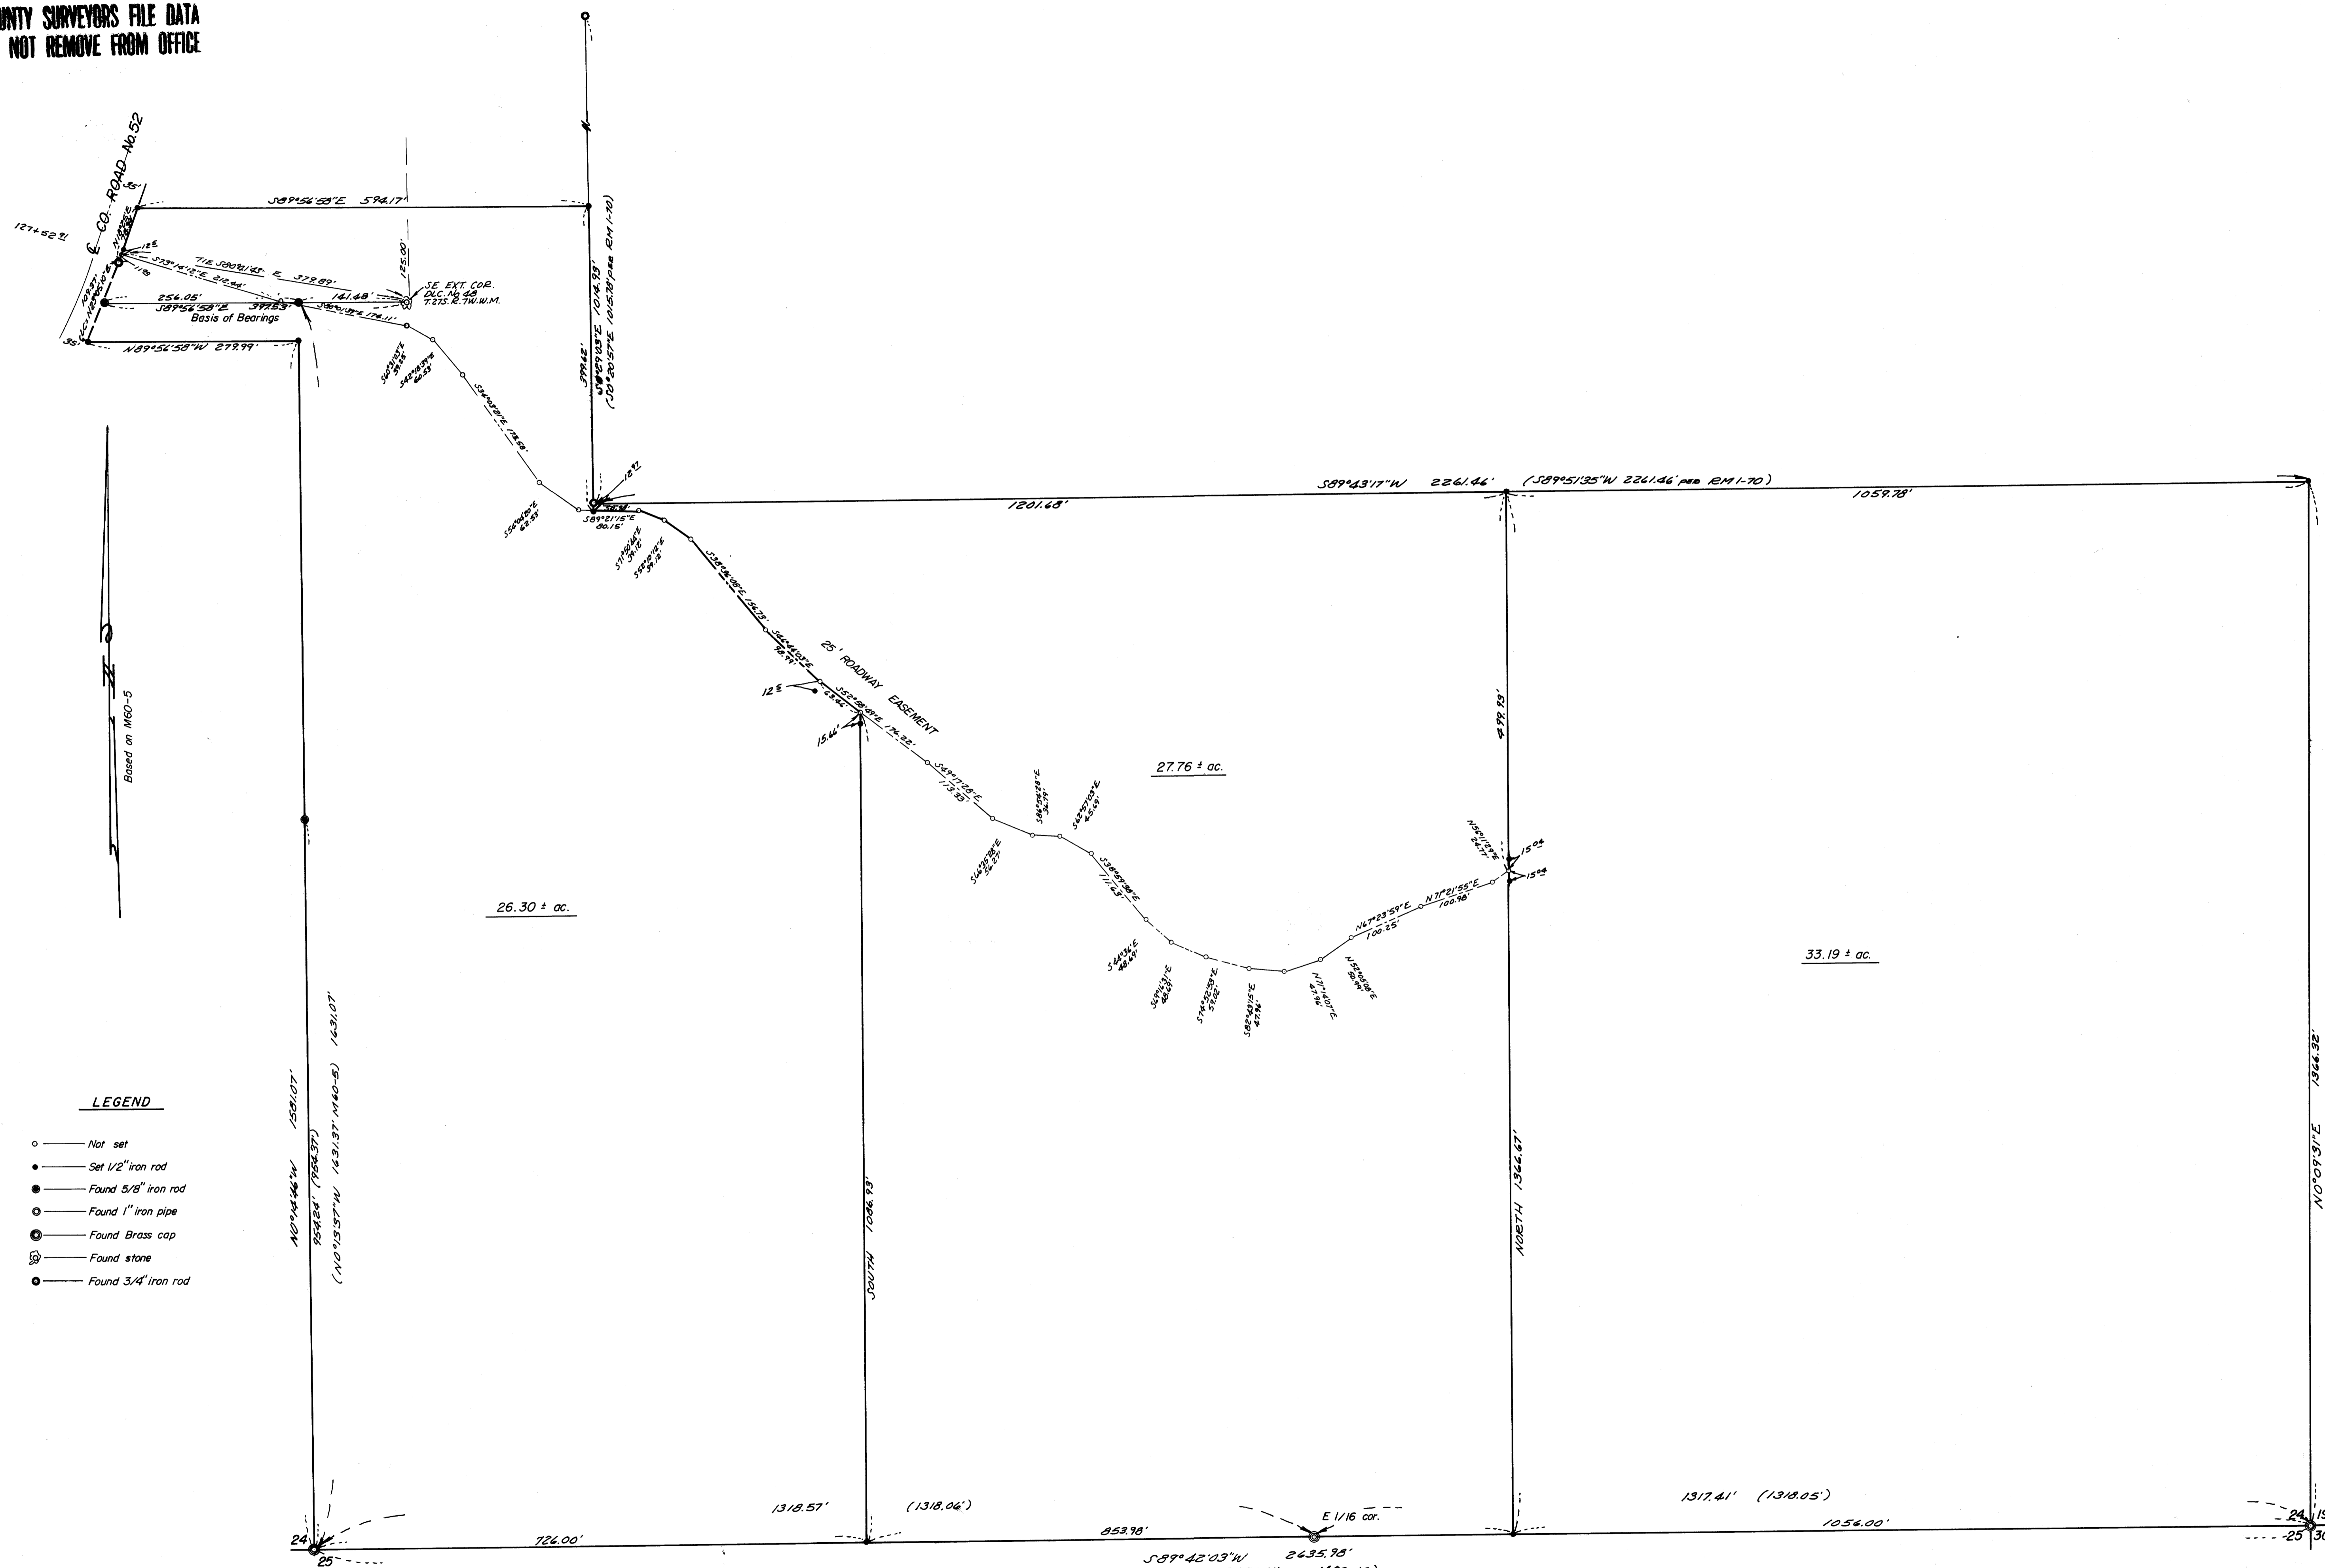

LEGEND

- — Not set
- — Set 1/2" iron rod
- — Found 5/8" iron rod
- — Found 1" iron pipe
- — Found Brass cap
- ⊗ — Found stone
- — Found 3/4" iron rod

REGISTERED
PROFESSIONAL
LAND SURVEYOR
Allen S. Baughman
OREGON
JULY 12 1961
GLENN S. BAUGHMAN
536

COUNTY SURVEYORS FILE DATA
DO NOT REMOVE FROM OFFICE

SURVEY FOR DESCRIPTION IN SECTION 24, T.27S. R.7W.W.M.		
FOR: BOB COMPTON	SCALE 1"=100'	DRAWN BY Eab
BAUGHMAN TECHNICAL INC.		
DATE 12/15/77	APPROVED BY	DRAWING NUMBER