

SURVEY FOR U.S. FOREST SERVICE

IN SECTION 7, T.31S., R.1W., DOUGLAS COUNTY, OREGON

BY: UMPQUA SURVEYING COMPANY, MYRTLE CREEK, OREGON
DECEMBER 1977

SCALE: 1"=500'

I, WILLIAM J. RUPPERT, a registered professional land surveyor in the State of Oregon hereby certify that this plat and the notes hereon, or attached, are a correct representation of a survey I performed during September 1977 thru December 1977, for the U.S. Forest Service, in accordance with statutes of the State of Oregon and with the Articles of the contract.

REGISTERED
OREGON
LAND SURVEYOR
William J. Ruppert
JULY 12, 1968
WILLIAM J. RUPPERT
866



William J. Ruppert
WILLIAM J. RUPPERT

LEGEND



- FOUND BRASS CAP
- ⊕ SET BRASS CAP
- TRUE LINE POSTED WITH STEEL FENCE POSTS AND GOVERNMENT PROPERTY SIGNS
- [] RECORD CALLS—COUNTY SURVEYOR'S FILE M34-23 1967
- [] RECORD CALLS—COUNTY SURVEYOR'S FILE M42-80 1972
- () RECORD CALLS—GLO PLAT 1868

NOTE:


- ALL MONUMENTS SET ON THIS SURVEY ARE SET ON 2"x30" GALV. IRON PIPE WITH 2 1/2" BRASS CAP.
- ALL BEARING TREE DIMENSIONS INDICATE THE DIAMETER OF THE TREE AT SCRIBED AREA.
- ALL BEARING TREE DISTANCES AND BEARING ARE FROM THE CENTER OF THE MONUMENT TO THE CENTER OF THE TREE.
- SCRIBED BEARING TREES HAVE A BRASS WASHER STAMPED LS 866 NAILED IN LOWER BLAZE.

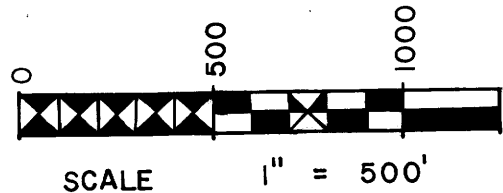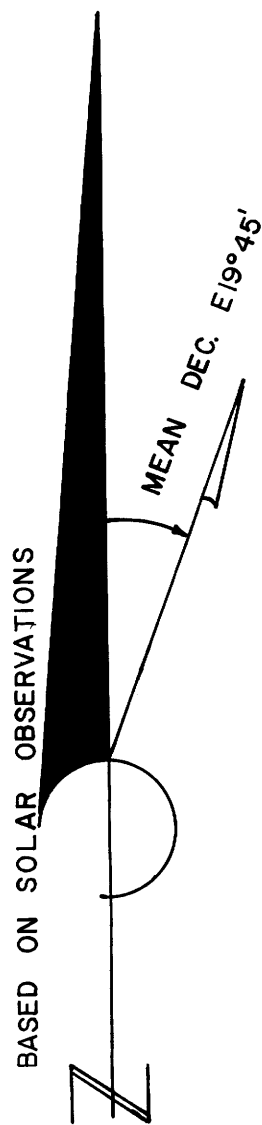


NOTE
DISTANCES SHOWN ARE NOT REDUCED TO SEA LEVEL.

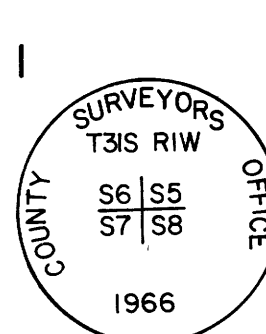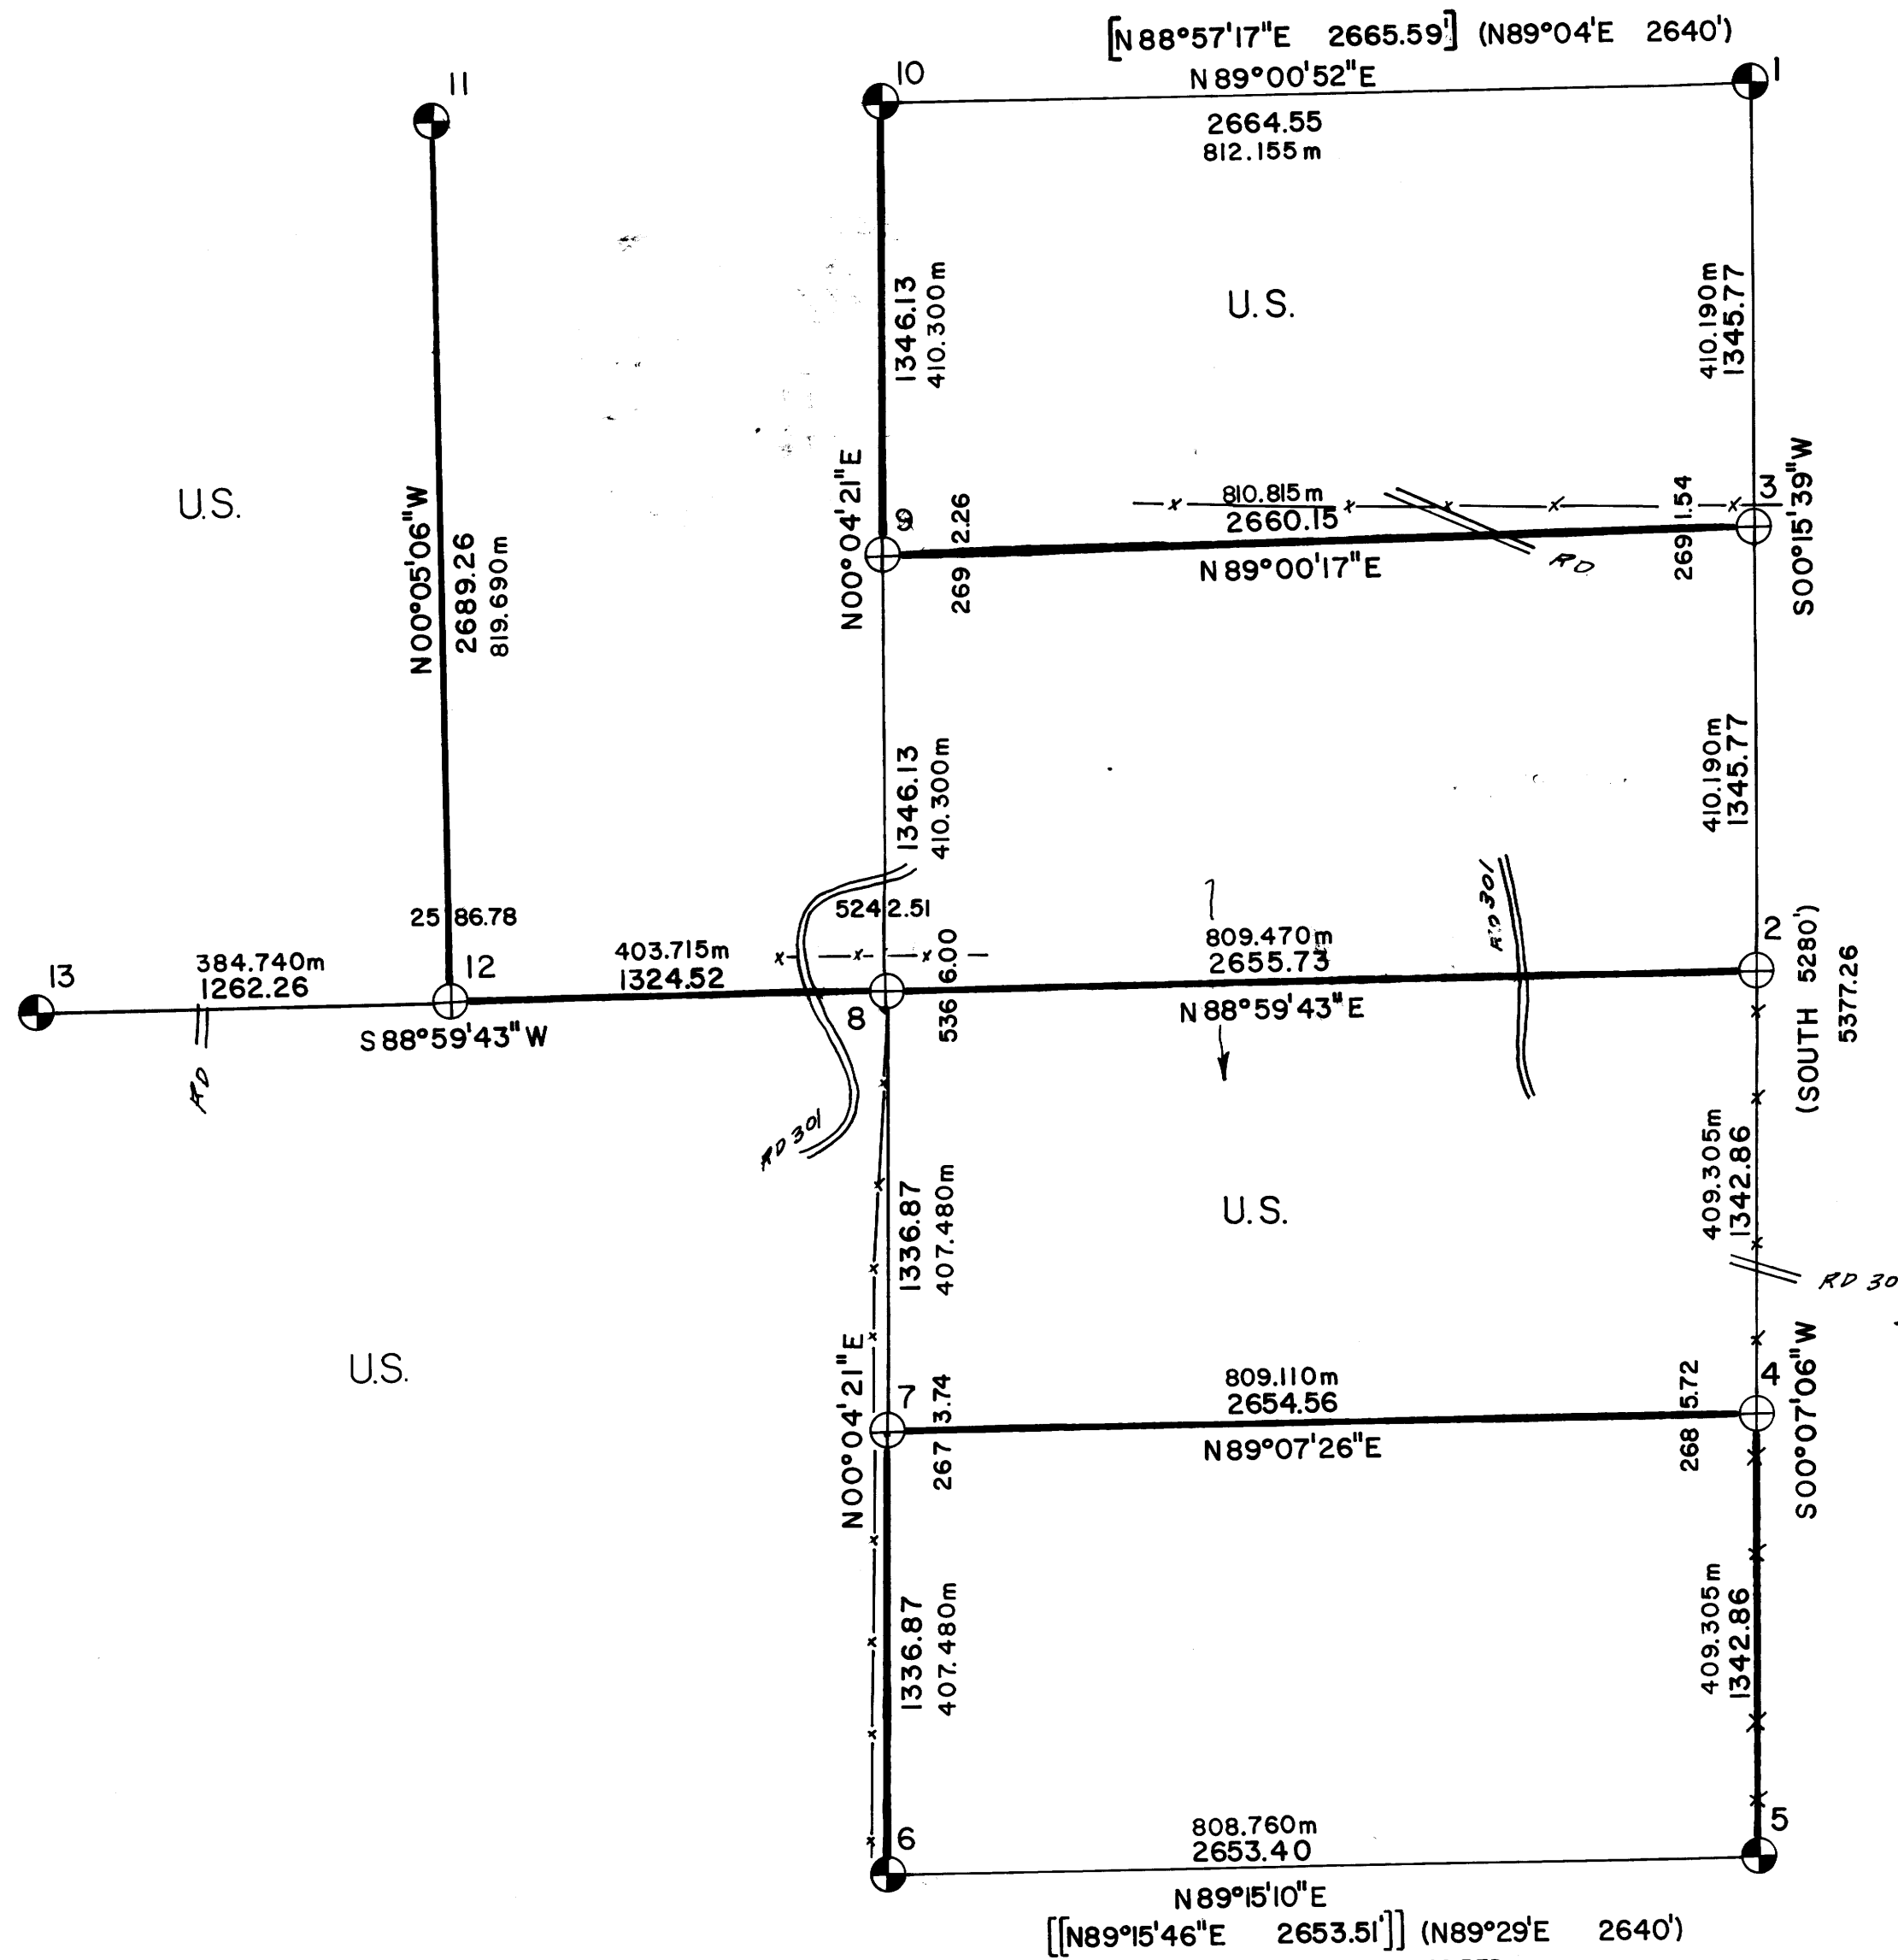


FOUND
23" D.FIR STUMP N70°39'W, 27.7 SCRIBE VIS.
4" D.FIR STUMP S71°W, 40.4 GOOD SCAR
ROTTED STUMP S59°E, 17.1 NO SCRIBE VIS.
14" MAPLE S17°W, 61.7 SCRIBE VIS.
12" HEMLOCK S83°E, 105.9 SCRIBE VIS.
8" FALLEN HEMLOCK N03°E, 106.2 SCRIBE VIS.
10" MAPLE SNAG N84°W, 67.6 SCRIBE VIS.
1" IRON PIPE WITH 2 1/2" BRASS CAP MARKED AS SHOWN
SCRIBED
12" HEMLOCK N31°11'E, 187.2 "T31S RIW S5 BT."
26" D.FIR N09°34'W, 155.5 "T31S RIW S6 BT."

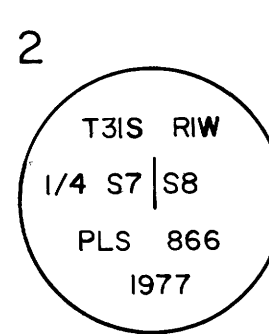


FOUND
BURNED SNAG N34°42'E, 39.0 SCRIBE VIS.
30" POND PINE S43°53'E, 46.7 SCRIBE VIS.
15" D.FIR S55°28'W, 21.5 GOOD SCAR
18" D.FIR N87°33'W, 32.9 GOOD SCAR
12" B.OAK N07°09'W, 71.3 GOOD SCAR
SET
2"x30" STEEL PIPE WITH 2 1/2" BRASS CAP MARKED AS SHOWN ALONGSIDE A 1 1/2" SHAFT FOUND PER C.S. 5/1/42

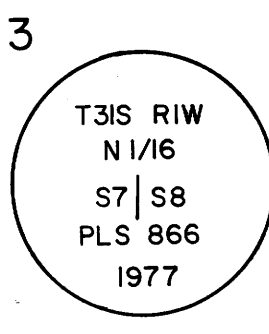


SCRIBED
14" D.FIR S39°32'W, 23.3 "N1/16 S7 BT."
15" W.FIR N37°59'E, 2.4 "N1/16 S8 BT."

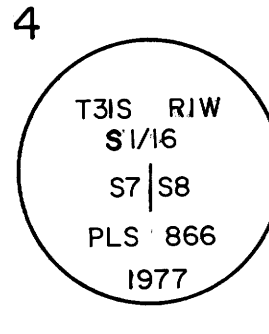


SCRIBED
24" D.FIR N24°36'W, 18.3 "S1/16 S7 BT."
10" D.FIR N56°31'E, 11.8 "S1/16 S8 BT."

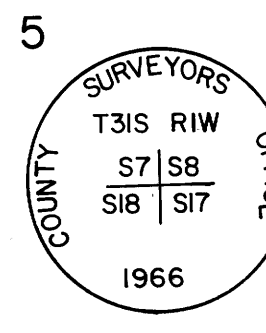


FOUND
24" OAK WINDFALL N42°07'E, 58.0 NO SCRIBE VIS.
16" FIR N46°30'E, 25.3 GOOD SCAR
16" FIR S50°01'E, 51.5 GOOD SCAR
14" FIR S38°13'W, 30.1 GOOD SCAR
24" OAK S55°12'W, 65.4 NO SCRIBE VIS.
18" MADRONE N6°16'W, 16.8 VIS. SCRIBE
18" OAK WINDFALL N10°33'W, 74.0 NO SCRIBE VIS.
1" IRON PIPE WITH 2 1/2" BRASS CAP MARKED AS SHOWN

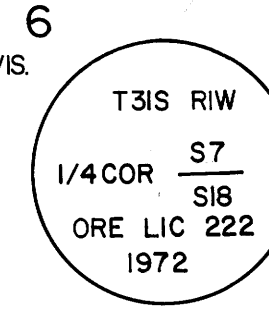


FOUND
10" D.FIR S34°W, 37.5 GOOD SCAR
10" D.FIR N49°W, 39.3 GOOD SCAR
2" GALVANIZED IRON PIPE WITH 3" BRASS CAP IN A STONE MOUND

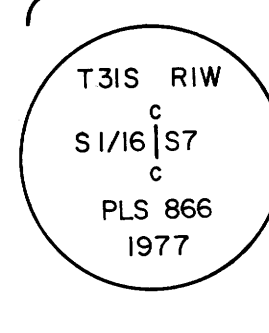


SCRIBED
9" D.FIR N78°30'W, 4.5 "CS1/16 S7 BT."
14" D.FIR S25°50'E, 12.6 "CS1/16 S7 BT."
17" D.FIR S59°20'W, 60.7 "CS1/16 S7 BT."

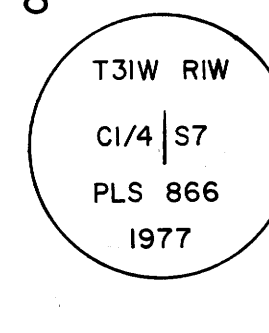


SCRIBED
24" CEDAR S85°00'W, 94.0 "C1/4 S7 BT."
12" FIR S01°45'E, 43.4 "C1/4 S7 BT."

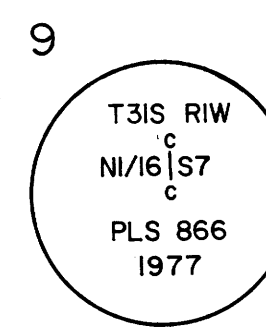


SCRIBED
14" D.FIR N24°57'W, 18.6 "CN1/16 S7 BT."
18" D.FIR N61°33'E, 20.7 "CN1/16 S7 BT."

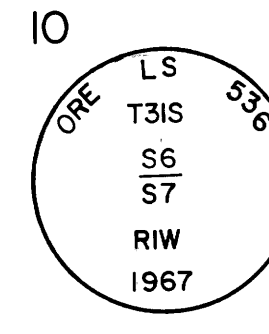


FOUND
21" D.FIR N23°45'E, 22.5 SCRIBE VIS.
17" D.FIR S45°15'E, 19.3 SCRIBE VIS.
2" GALVANIZED PIPE WITH 2 1/2" BRASS CAP

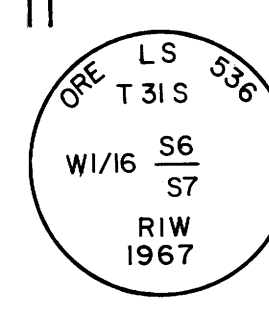

FOUND
2"x36" PIPE WITH BRASS CAP LYING ON TOP OF GROUND
14" D.FIR SCRIBING VISIBLE
28" B.OAK SCRIBING VISIBLE
RESET PIPE AND BRASS CAP FOUND LAYING ON GROUND AT RECORD DISTANCES FROM BEARING TREES.
14" D.FIR N59°40'E, 52.5
28" B.OAK S25°10'E, 71.0
BEARINGS ARE PER THIS SURVEY

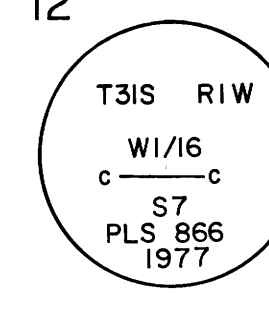

SCRIBED
16" D.FIR N49°W, 24.4 "CW1/16 S7 BT."
12" PINE S18°W, 31.2 "CW1/16 S7 BT."

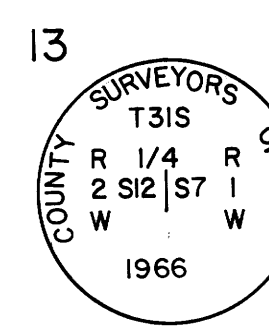

FOUND
12" D.FIR N49°30'E, 13.9 GOOD SCAR
5" MAPLE N48°40'W, 11.9 GOOD SCAR
23" D.FIR N02°45'W, 26.1 GOOD SCAR
6" MAPLE CORNER TREE WITH A 2 1/2" BRASS CAP ON A 1" IRON PIPE SET ALONG SIDE

DRAWN BY: V. CHURCH

07-59W