


FILE #  
DATE  
COUNTY SURVEYOR  
BRUCE A. SHANER



**LEGEND**

- Corner found (1/2" iron pipe unless noted) ○
- Corner set (5/8" iron rod with aluminum cap) ●
- Corner computed, not set •

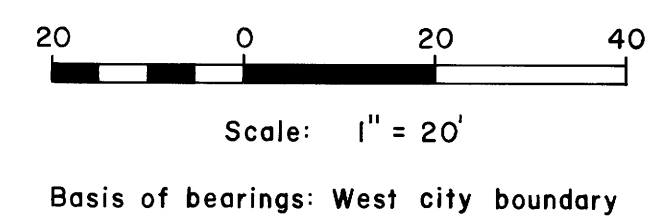

Reference Survey by George Wenderoth for the City of Glendale, November, 1963. CS Map File M22-50.

REGISTERED PROFESSIONAL LAND SURVEYOR  
 BA Shaner  
 OREGON  
 OCT 4, 1967  
 BRUCE A. SHANER  
 430

**PROPERTY BOUNDARY SURVEY  
 OF BLOCK 37  
 IN THE CITY OF GLENDALE, OREGON  
 & IN THE SW 1/4 NE 1/4 OF SECTION 5,  
 T. 33 S., R. 6 W., W.M.**

For: James W. & Joyce A. Apperson  
 By: Shaner Engineering, Inc.  
 February 27, 1978