

# SURVEY FOR PROPERTY CORNERS

IN LOT 1 BLOCK 41, AMENDED PLAT OF THE TOWNSITE OF SUTHERLIN—SECTION 20, T.25S. R.5W.W.M.

FOR: HARRINGTON & HAGBERG  
BY: C & G ENGINEERING INC.  
DATE: JULY 1977 SCALE: 1" = 100'

COUNTY SURVEYORS FILE DATA  
DO NOT REMOVE FROM OFFICE


FILED *BS*  
RECEIVED

JUL 21 1977

COUNTY SURVEYOR  
DOUGLAS COUNTY, ORE.

JUL 21 1977

COUNTY SURVEYOR  
DOUGLAS COUNTY, ORE.

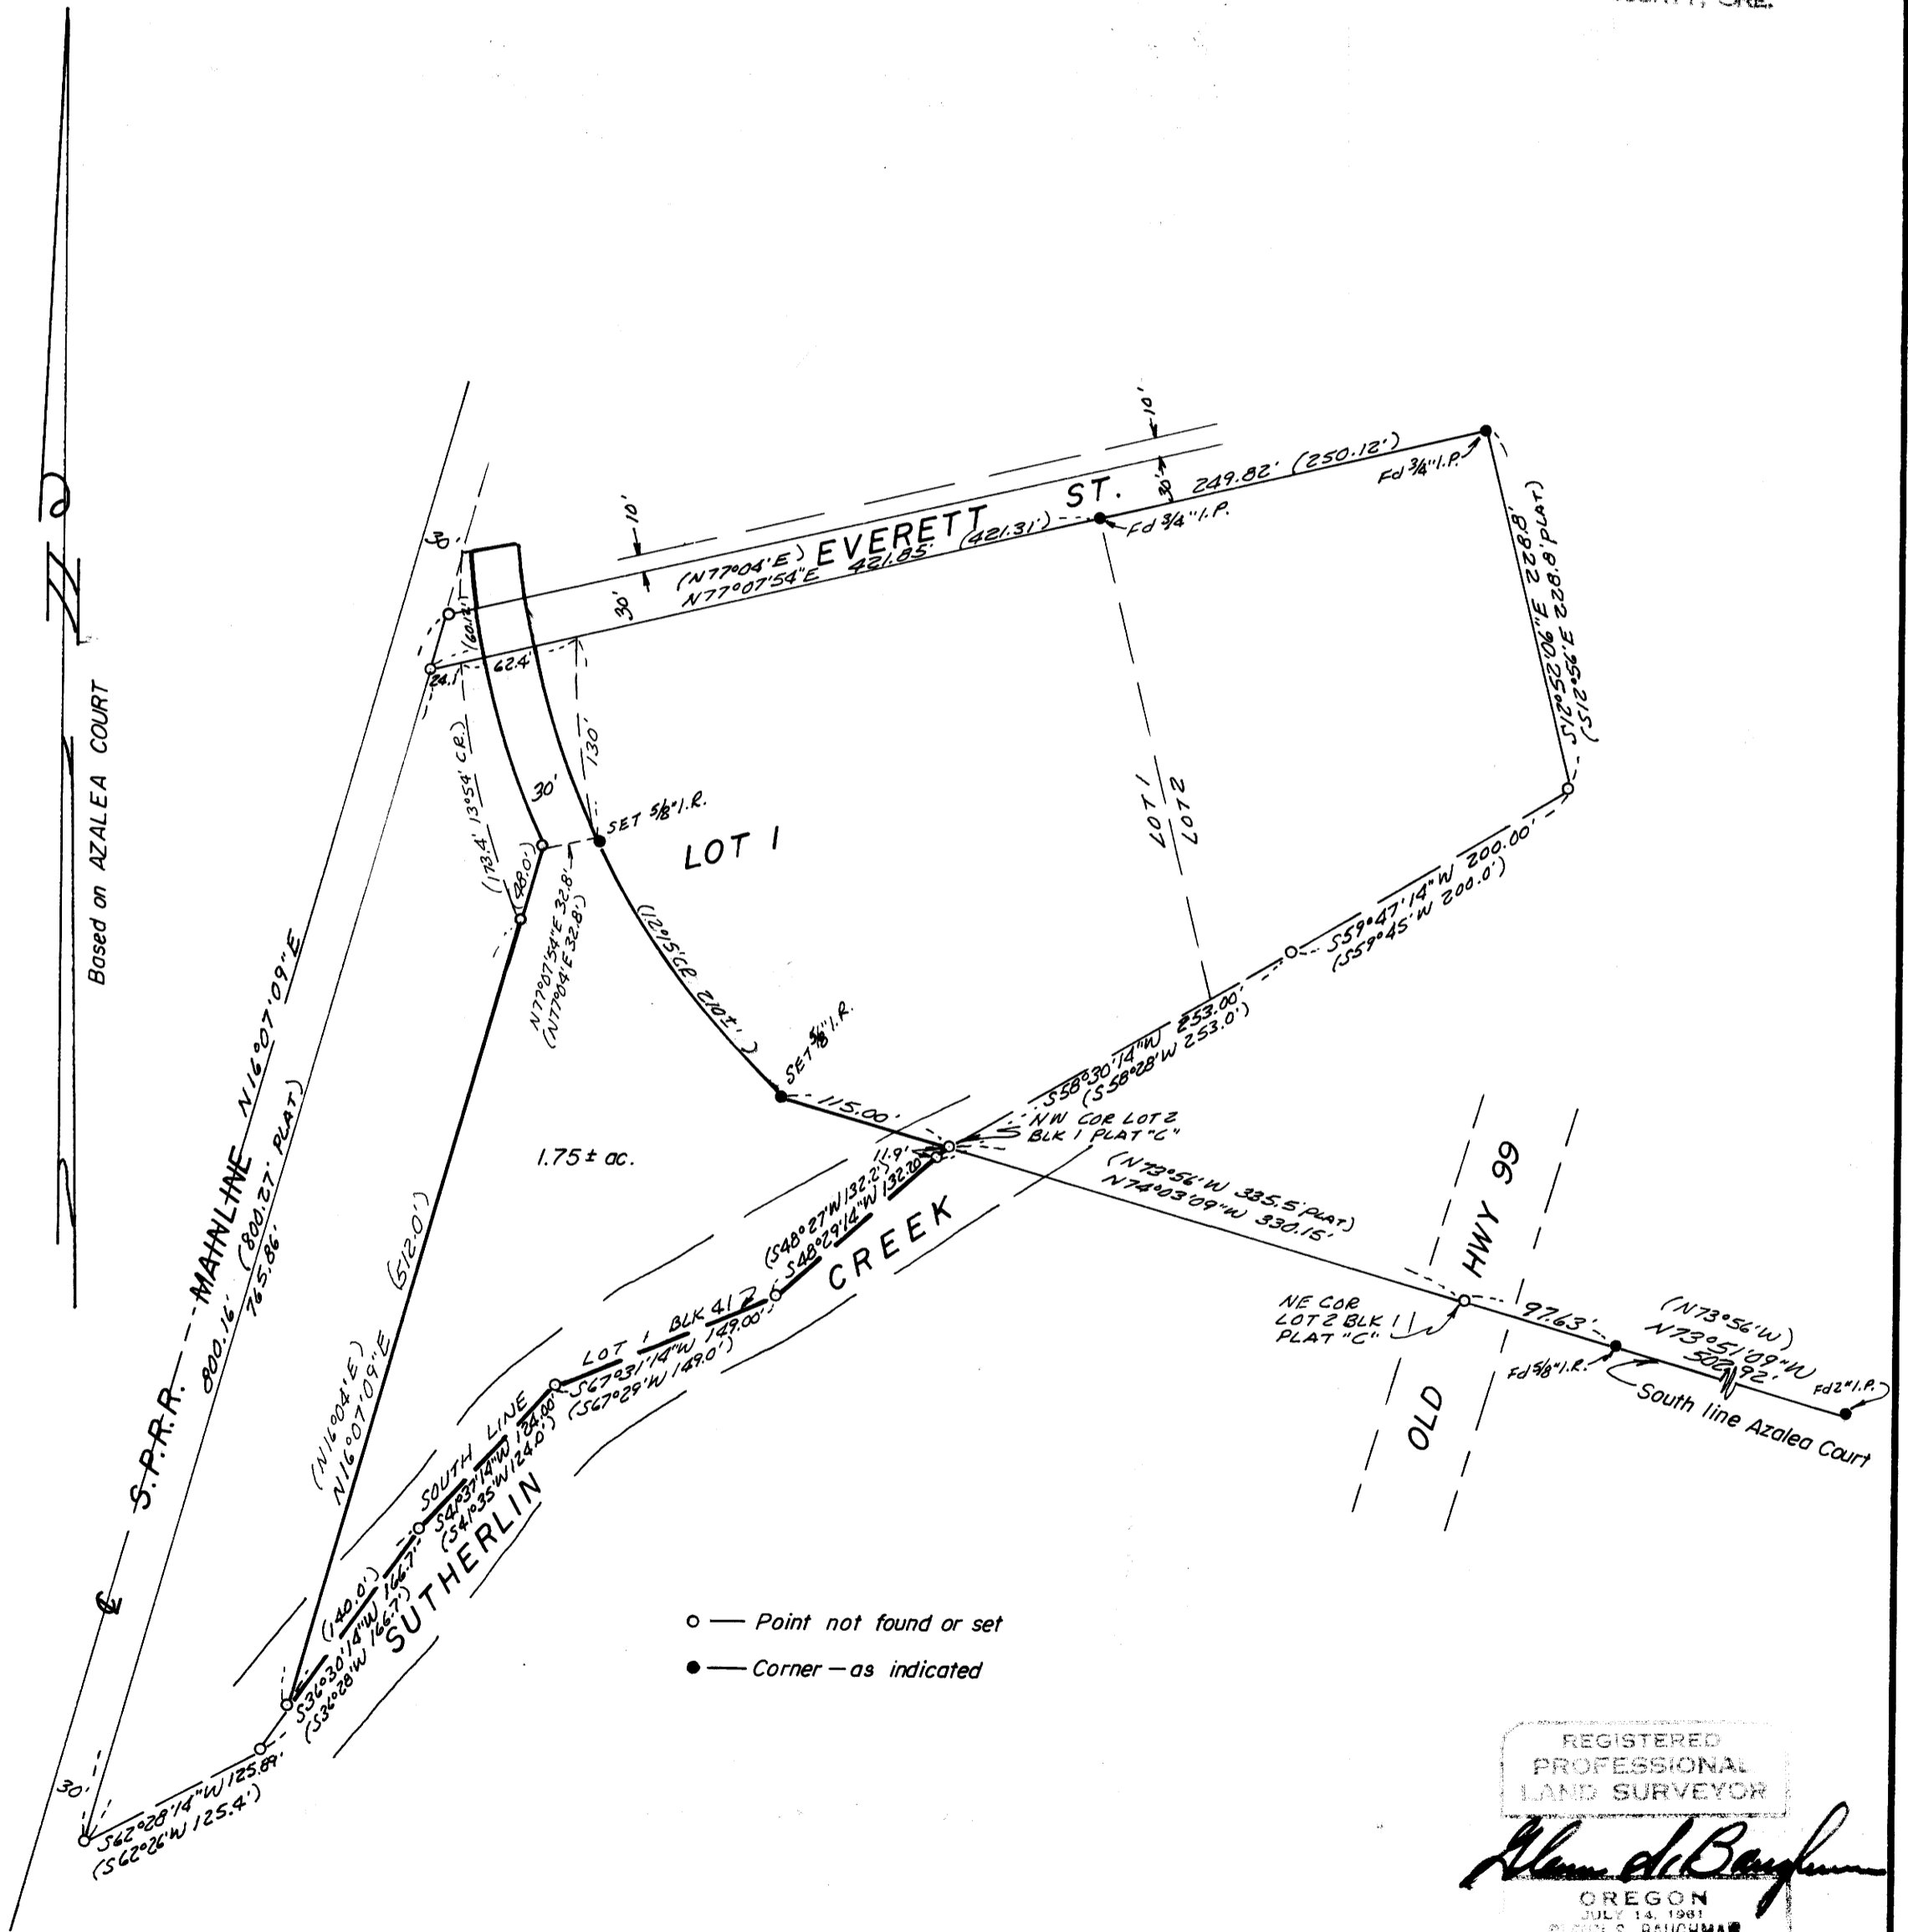

○ — Point not found or set  
● — Corner — as indicated

REGISTERED  
PROFESSIONAL  
LAND SURVEYOR  
*Alan S. Baughman*  
OREGON  
JULY 14, 1961  
ALAN S. BAUGHMAN  
536