

SURVEY FOR PROPERTY LINE AGREEMENT

FOR Leroy Johnson


FILED ✓
RECEIVED ✓

SEP 13 1977

COUNTY SURVEYOR
DOUGLAS COUNTY, ORE.

12 | 7
13 | 18
T. 32S., R. 4W., W.M. [EAST 1298.9]

[SOUTH 451.6]

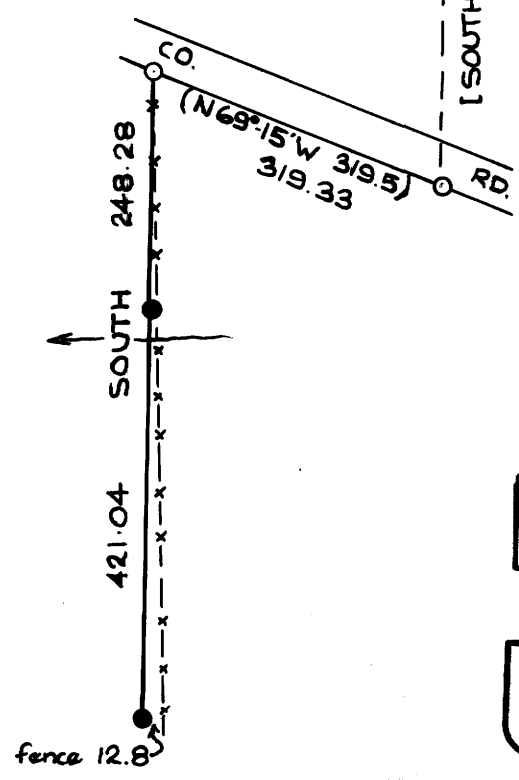

LEGEND

- FOUND 3/4" IRON PIPE PER M9-15
- SET 3/4" IRON ROD
- [] RECORD COURSE PER 76-12289 DOUGLAS COUNTY DEED RECORDS
- () RECORD COURSE PER M9-15



BASIS OF BEARING
SOLAR OBSERVATION

SCALE 1" = 200'

REGISTERED
OREGON
LAND SURVEYOR

William J. Ruppert

JULY 12, 1968
WILLIAM J. RUPPERT
866

UMPQUA SURVEYING CO. MYRTLE CREEK, OREGON.

AUGUST 18 1977
COUNTY SURVEYORS FILE DATA
DO NOT REMOVE FROM OFFICE