


SURVEY OF DEED DESCRIPTION FOR JAMES E. JENKINS

SEC. 21, T. 30 S., R. 1 W., W.M.

FILED *v*
RECEIVED *vh*

OCT 21 1977

COUNTY SURVEYOR
DOUGLAS COUNTY, ORE.

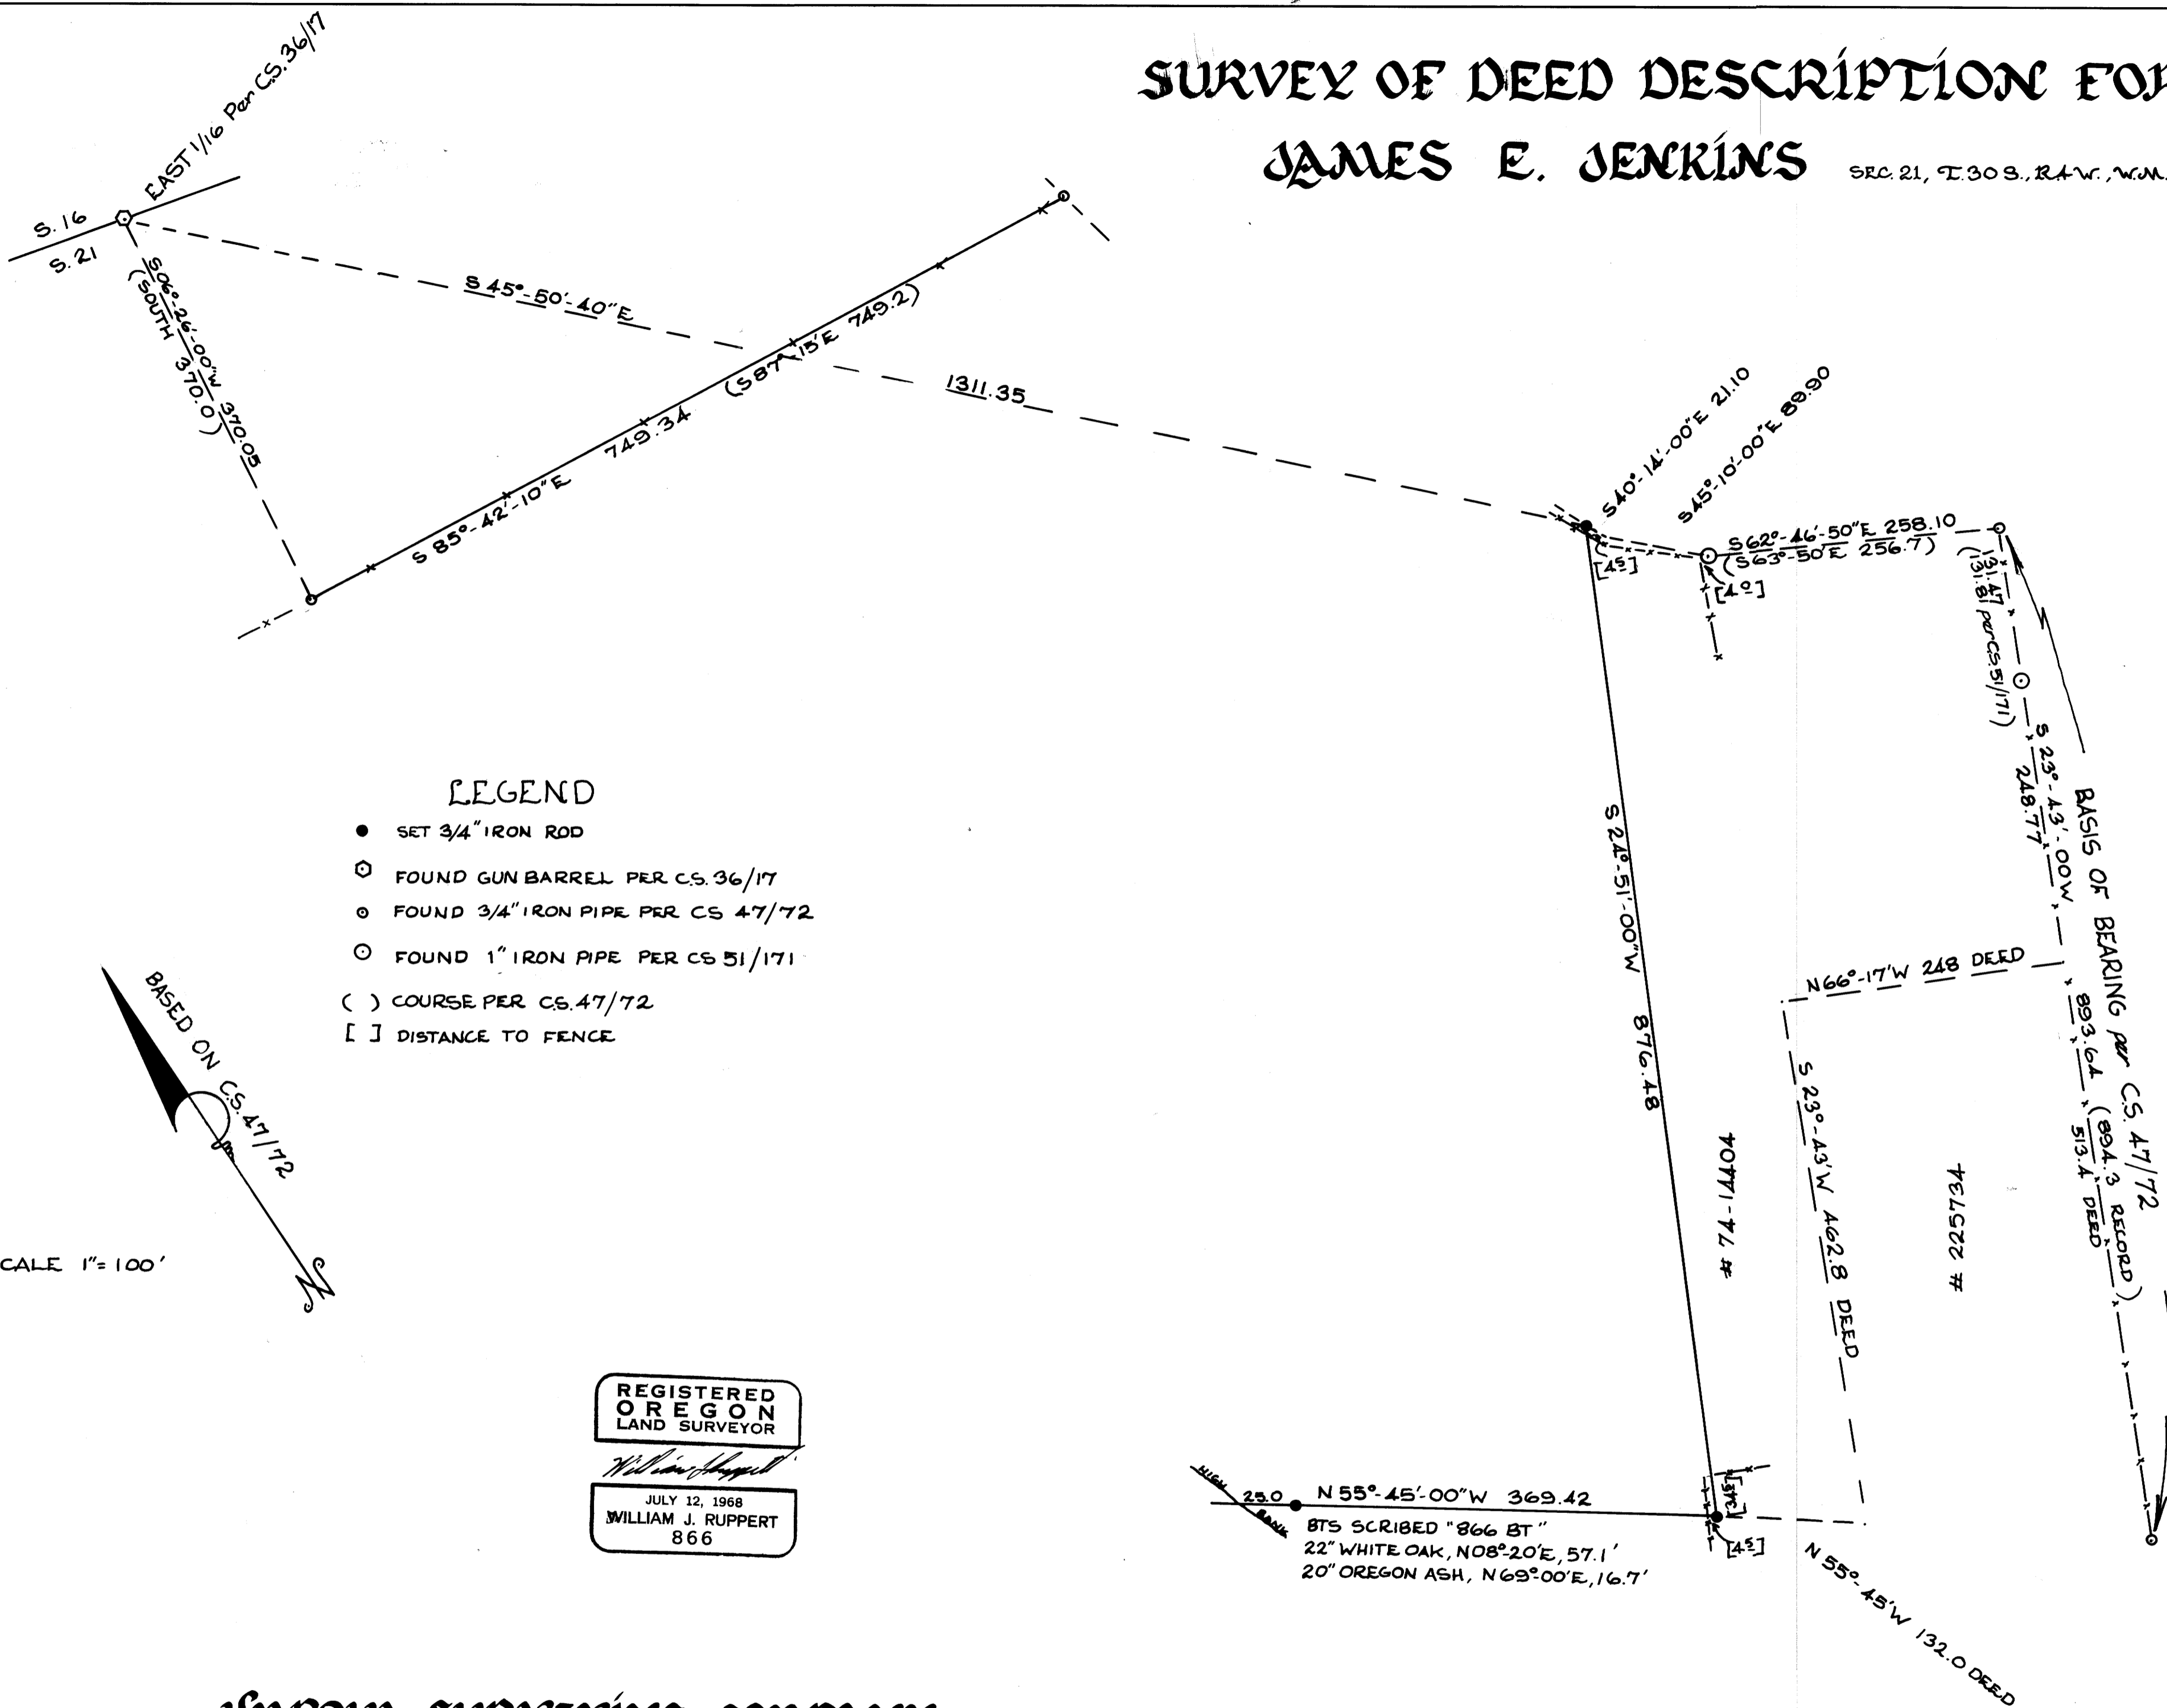

MAP FILE 1216.2-21

MAP FILE 1216.2-21