


FILED ✓
RECEIVED MLL

SURVEY TO SET PROPERTY CORNERS IN SECTION 17, T.26S. R.3W. W.M.

FOR: JEROME JANSEN
BY: C & G ENGINEERING INC.

OCTOBER 1977 SCALE: 1" = 30'

COUNTY SURVEYOR
JULIAS G. GIBSON, D.E.

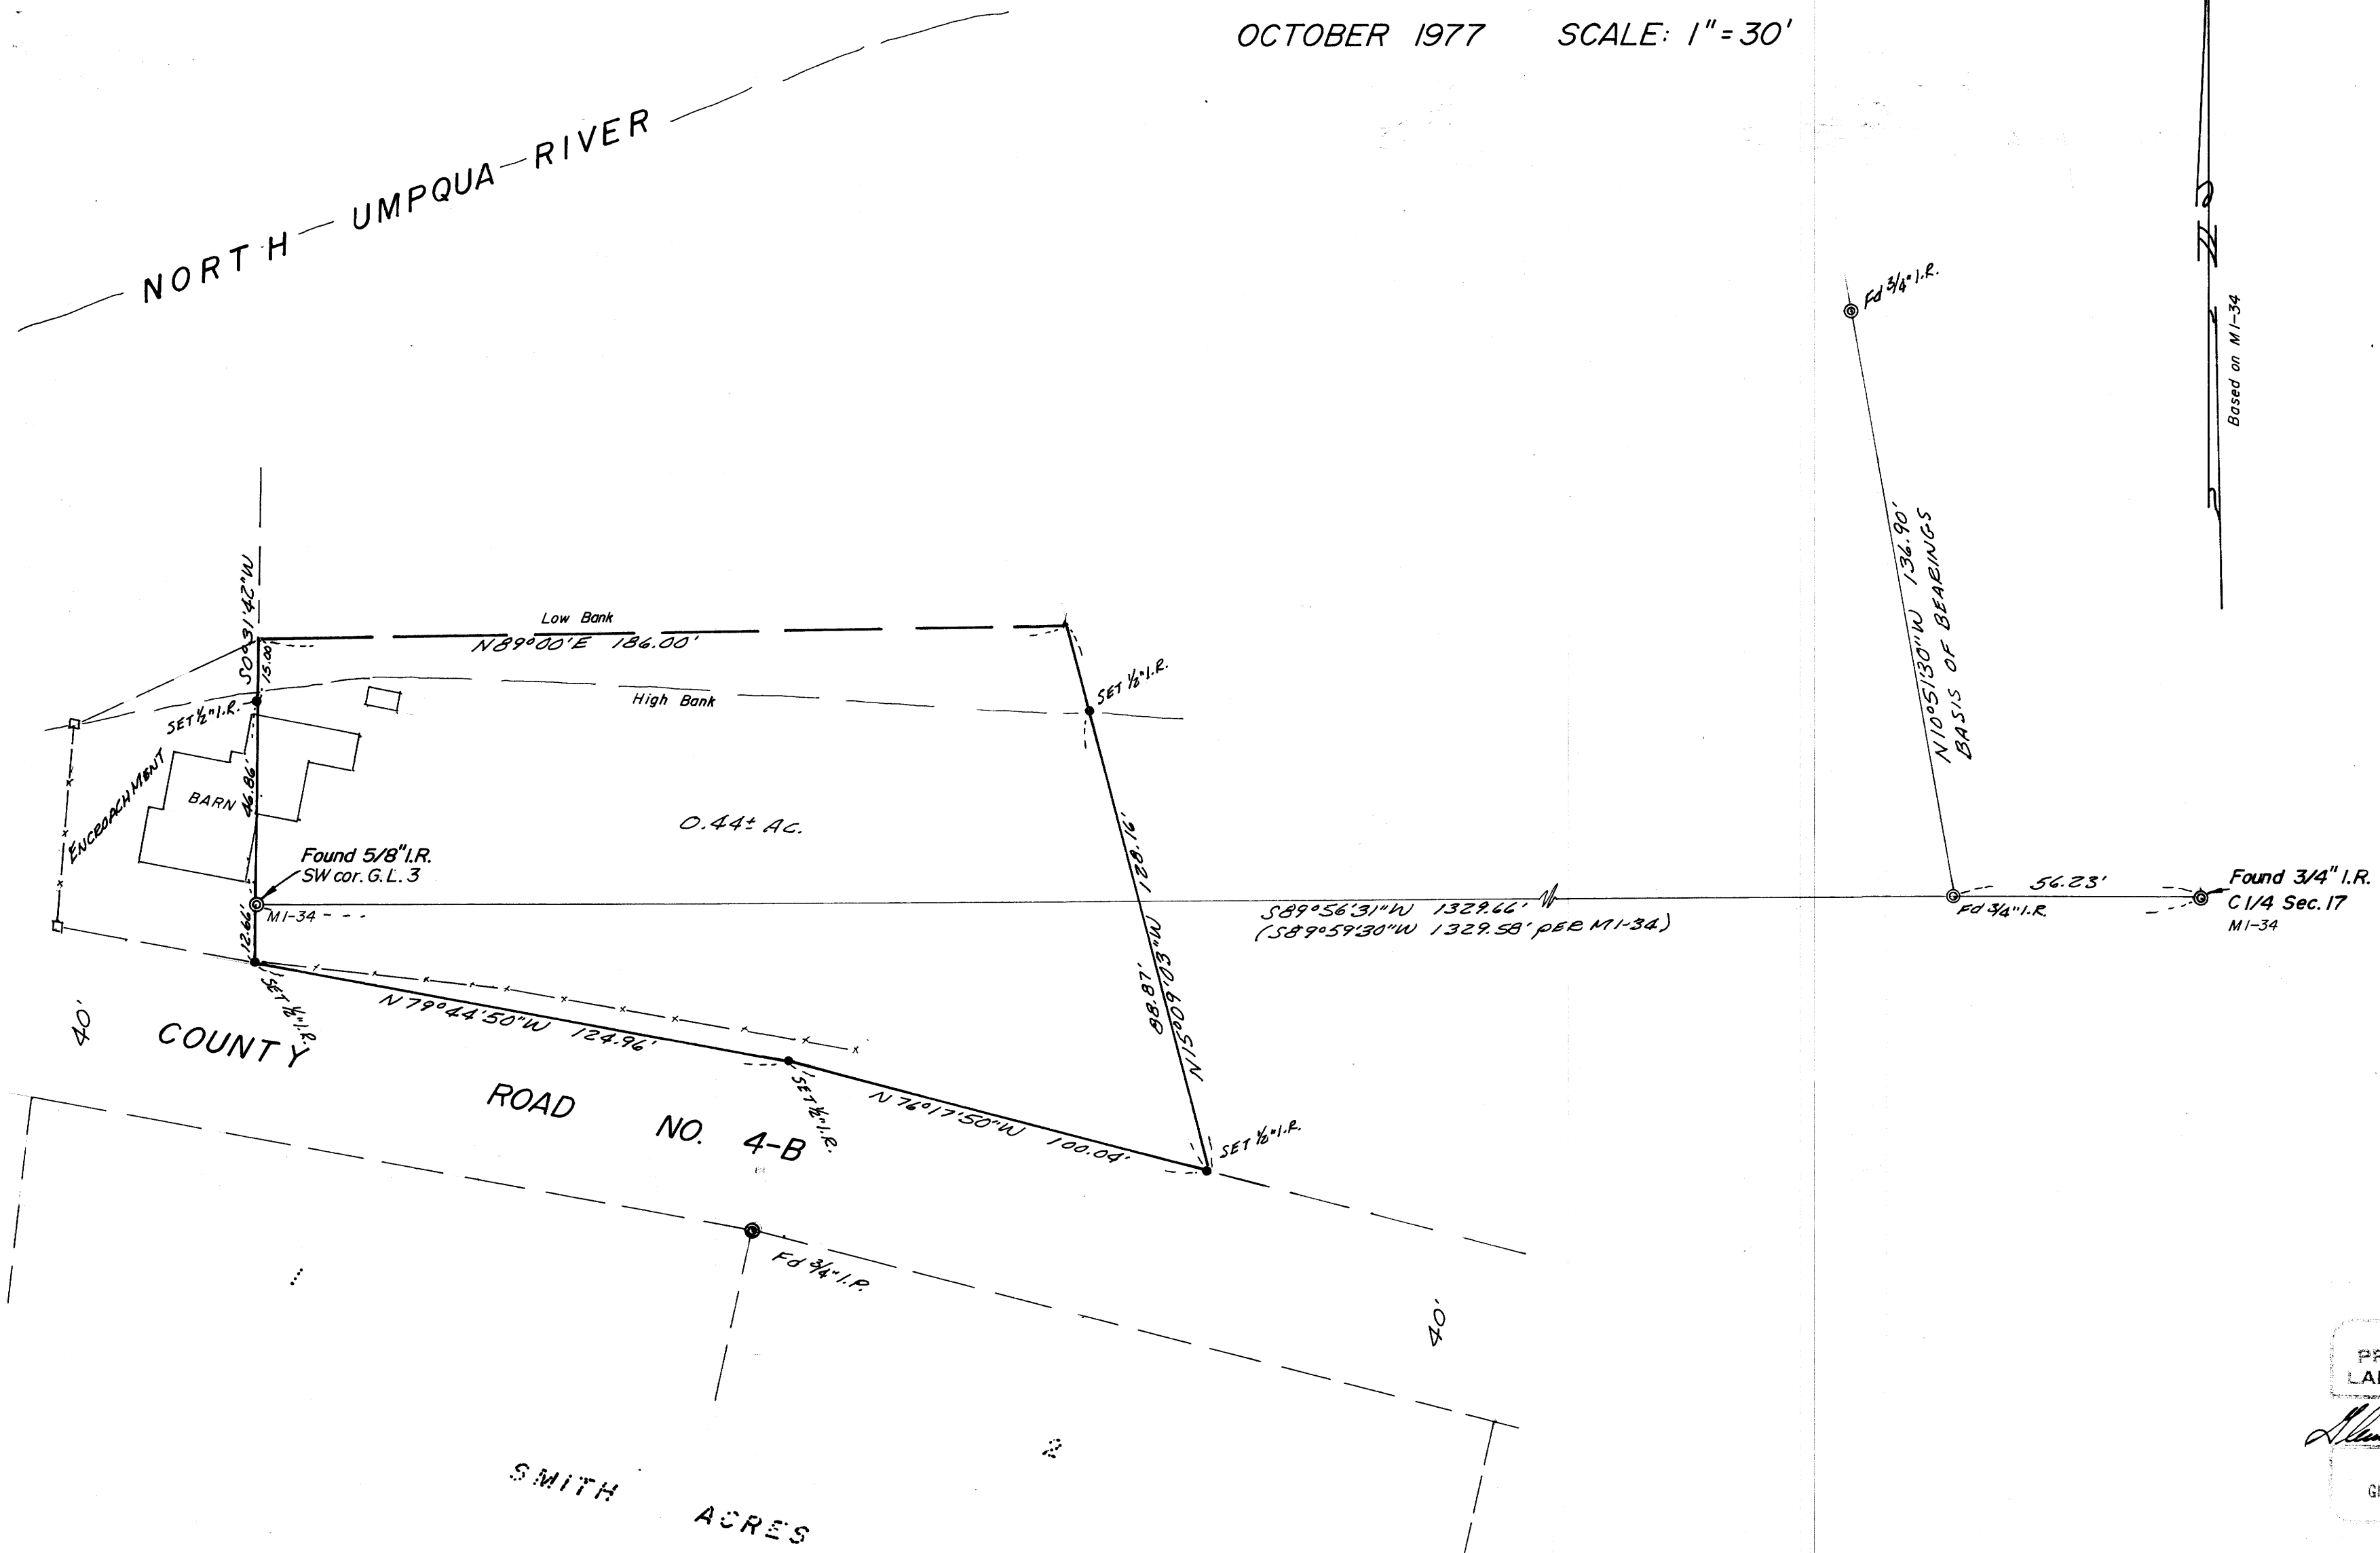

REGISTERED
PROFESSIONAL
LAND SURVEYOR

Glenn S. Baughman

OREGON
JULY 14, 1961
GLENN S. BAUGHMAN
536

MAP FILE M167-41

MAP FILE M167-41