


FILED
RECEIVED MLL
NOV 30 1977
COUNTY SURVEYOR
DOUGLAS COUNTY, ORE.

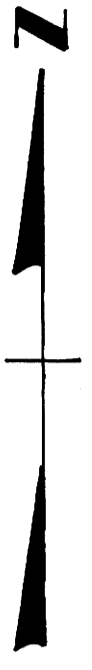

CORNER TO SECTIONS 25, 26, 35, & 36
FOUND: BLM BRASS CAP
38" FIR, N17E, 37.6'
34" FIR, S70E, 51.5'
26" FIR, S31W, 83.8'
72" FIR, N40W, 26.4'

WITNESS CORNER TO 1/4 CORNER FOR SECTIONS 35 AND 36
SET 5/8" X 42" REBAR IN LARGE MOUND OF STONE N 1° 10 3/4 W, 44.0' FROM POINT FOR 1/4 CORNER
36" FIR, N10E, 14.3' TO R.R. SPIKE
18" FIR, S35W, 31.0' TO R.R. SPIKE

CLOSING CORNER SECTIONS 35 & 36
SET 5/8" X 42" REBAR
10" FIR, N20E, 8.2' TO R.R. SPIKE
18" FIR, N42W, 11.9' TO R.R. SPIKE

1/4 CORNER SECTION 2 ONLY
FOUND MARKED STONE
32" FIR, S 61 1/2 E, 22.0' CLOSED FACE
28" FIR, S 45 1/2 E, 28.1' CLOSED FACE
5" FIR, S 40 E, 5.7', CLOSED FACE

S 89° 58' W, 97.6'
(N 89° 16' W 39.22 CHS GLO)
N 89° 15' W 2560.6'

S 89° 58' W 2588.1'
(N 89° 40' W, 39.23 CHS GLO)

STANDARD CORNER SECS. 1 AND 2
FOUND: 22" DOWN FIR, S44E, 67'
12" FIR, N38E, 18.5'
12" FIR, S07W, 33.5' (RECORDED S12W)
10" FIR, N04W, 10.5'
SET 1" ALUMINUM PIPE
20" FIR, S75E, 46.0' TO R.R. SPIKE
16" FIR, S89W, 21.1' TO R.R. SPIKE
10" FIR, N04W, 9.9' TO R.R. SPIKE

1/4 CORNER SECTION 1 ONLY
FOUND: DOUG. CO. BRASS CAP 1967
50" FIR, N60E, 25.1' O.B.T.
15" FIR, S36E, 23.0' C.S.B.T.
48" FIR, S5W, 44.2' O.B.T.
17" FIR, S53W, 4.3' C.S.B.T.

SURVEY OF W LINE AND W 1/2 S LINE
SEC. 36, T25S, R2W, W.M.
DOUGLAS COUNTY, OREGON

FOR
WEYERHAEUSER CO.
BY
TRIANGLE ENGINEERING CO.
SCALE: 1"=400' OCT 1977

COUNTY SURVEYORS FILE DATA
DO NOT REMOVE FROM OFFICE

REGISTERED
PROFESSIONAL
LAND SURVEYOR
L. D. Roberts
OREGON
AUGUST 22, 1975
L. D. ROBERTS
1039