

# SURVEY FOR DEED DESCRIPTION

COUNTY SURVEYORS FILE DATA  
DO NOT REMOVE FROM OFFICE

IN LOT 3, BLOCK 4, PLAT "O"  
S. L. & W. CO.  
SEC. 18, T 25 S, R 5 S, W. M.

SURVEYED FOR - BILL MOSS


NOV. 1977

FILED *W*  
RECEIVED *W*

COUNTY SURVEYOR  
DOUGLAS COUNTY, NEB.

*W*

- Denotes 5/8" iron pipes fd.
- " 5/8" iron rods set.
- ⊙ " cor.'s calculated but not set.

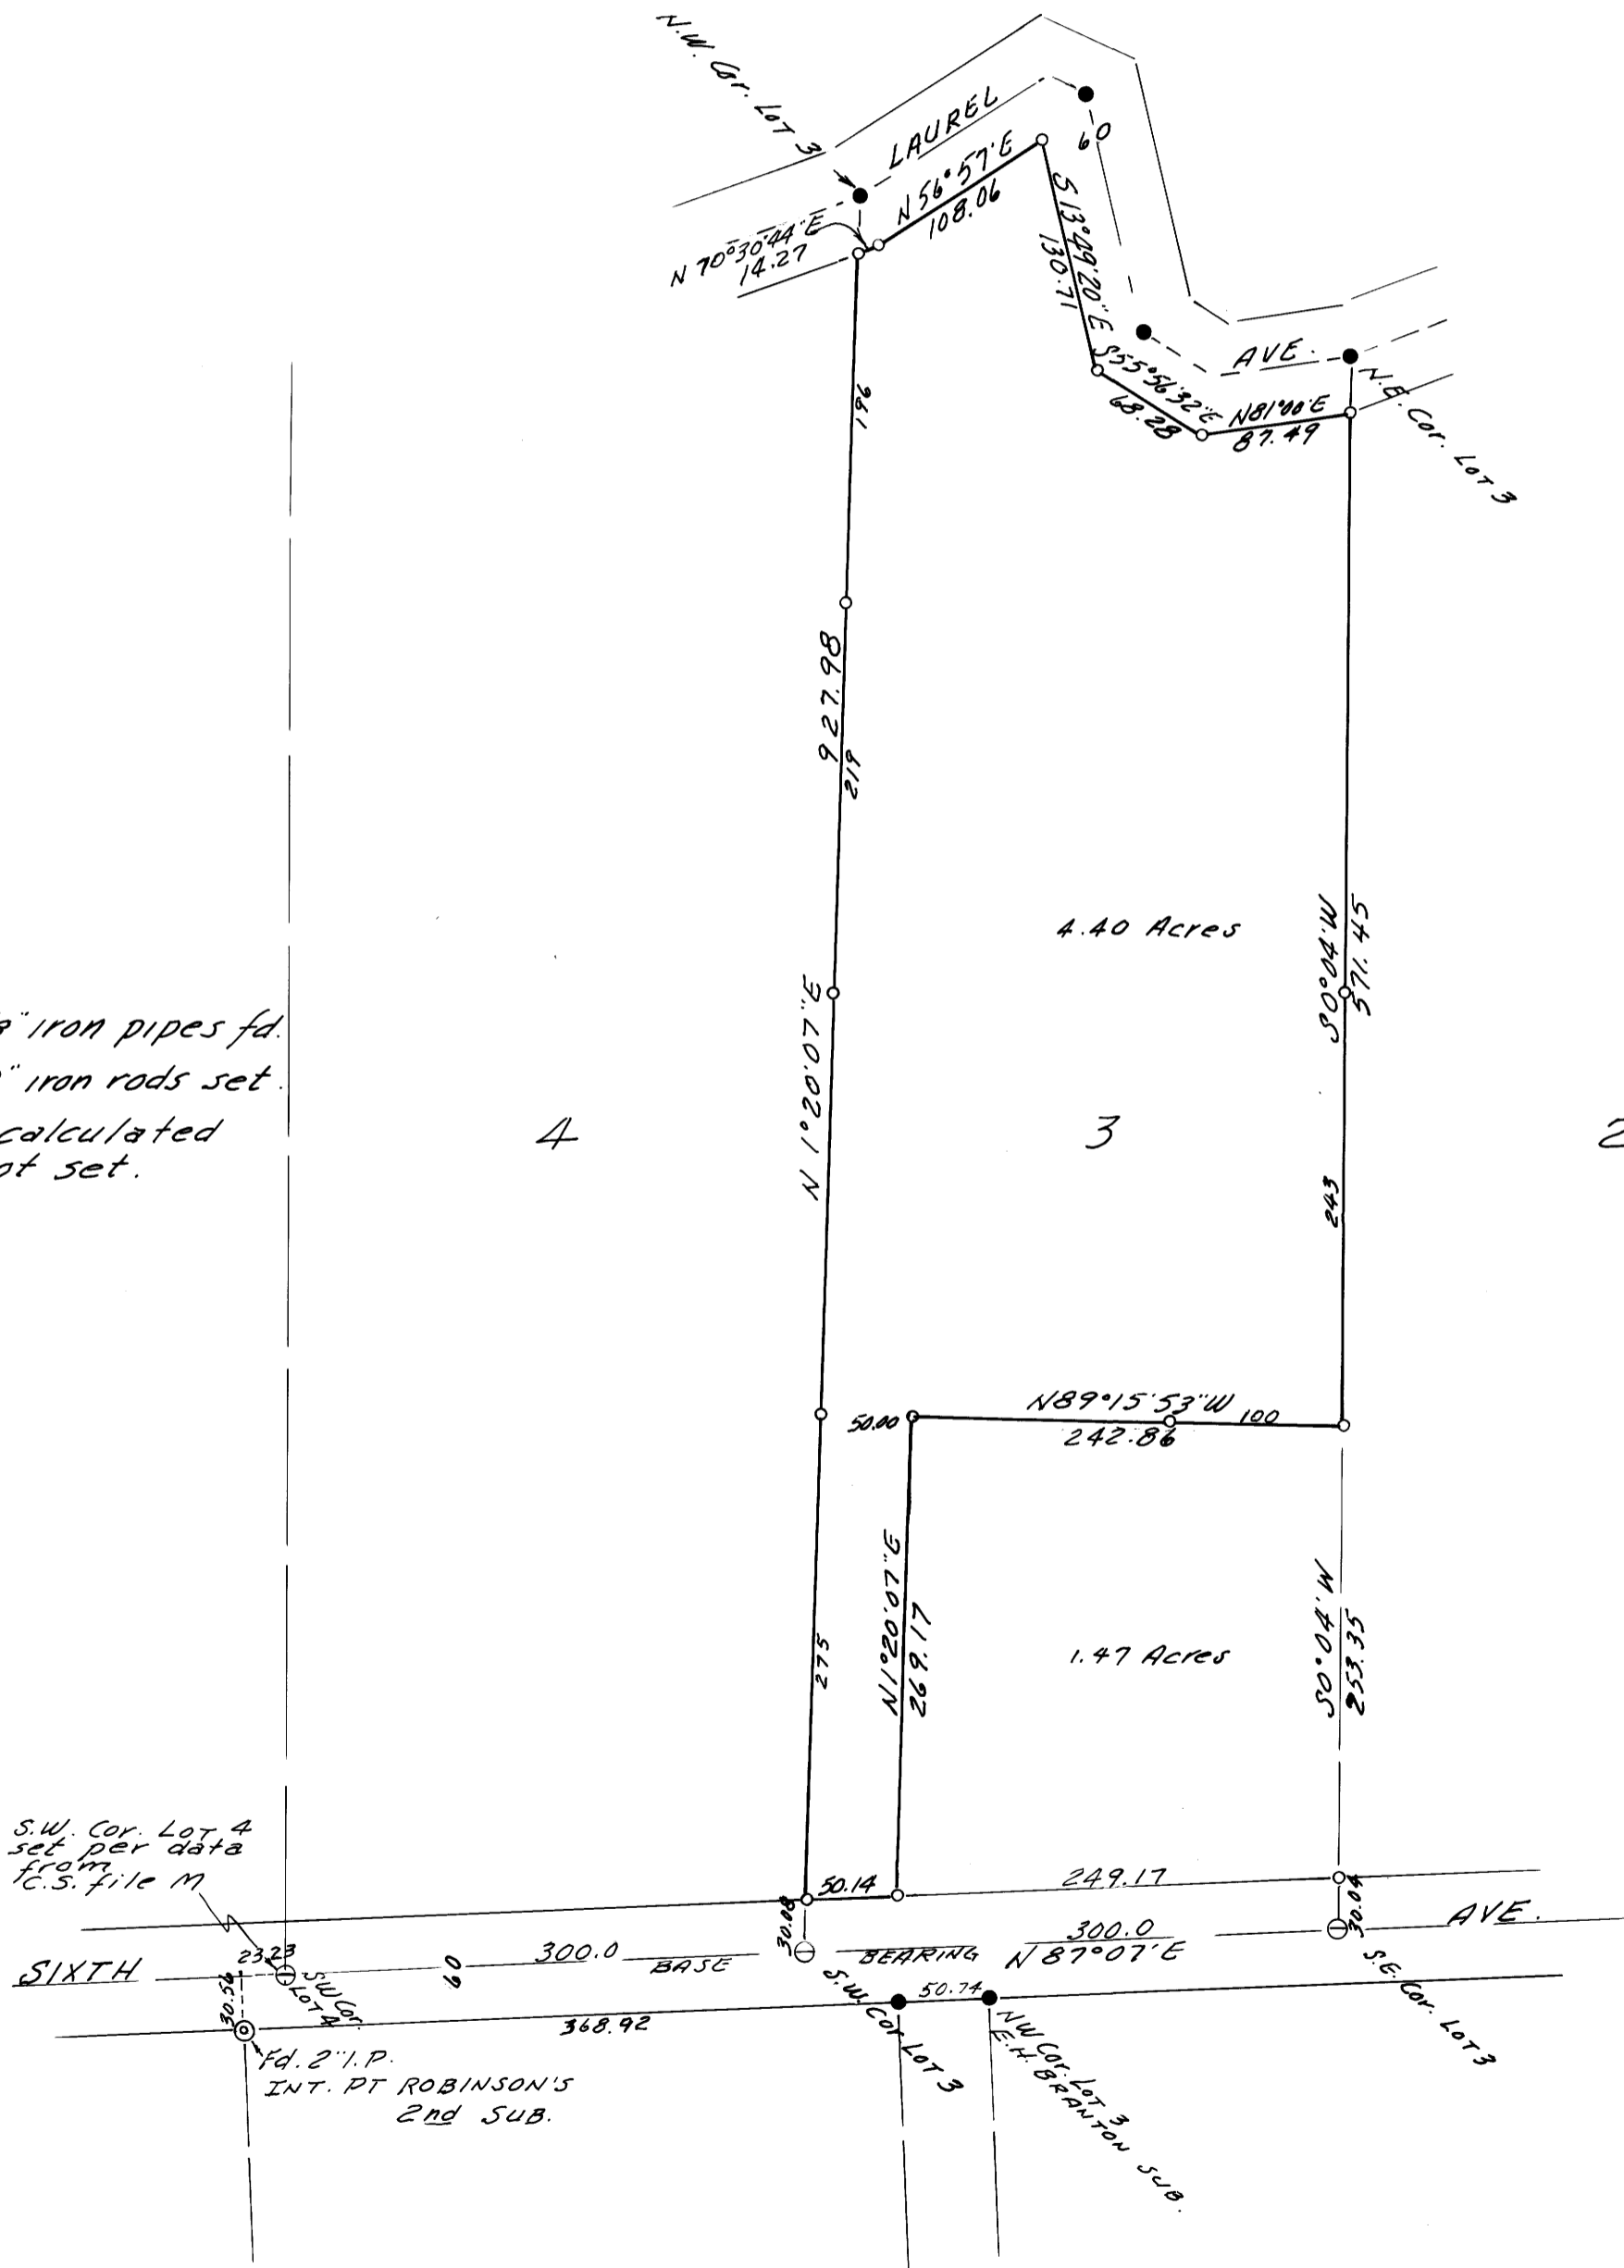

SCALE 1" = 100'

REGISTERED  
PROFESSIONAL  
LAND SURVEYOR

*W S Barnes*

NOV 1977  
MILLS & BARNES  
SURVEYORS