

COUNTY SURVEYORS FILE DATA  
DO NOT REMOVE FROM OFFICE

# Survey in Sec. 7, 8, & 18, T26S, R6W, W.M.

For: Gerald Bacon  
By: B.H.W. Eng. & Surveying

January 1978


Scale: 1" = 200'

- ——— Fd. 5/8" Iron Rod
- ——— Set 5/8" Iron Rod
- 1/4 CORNER


REGISTERED  
PROFESSIONAL  
LAND SURVEYOR

Romanso E. Ware

OREGON  
NOV. 16, 1973  
ROMANSO E. WARE  
1005

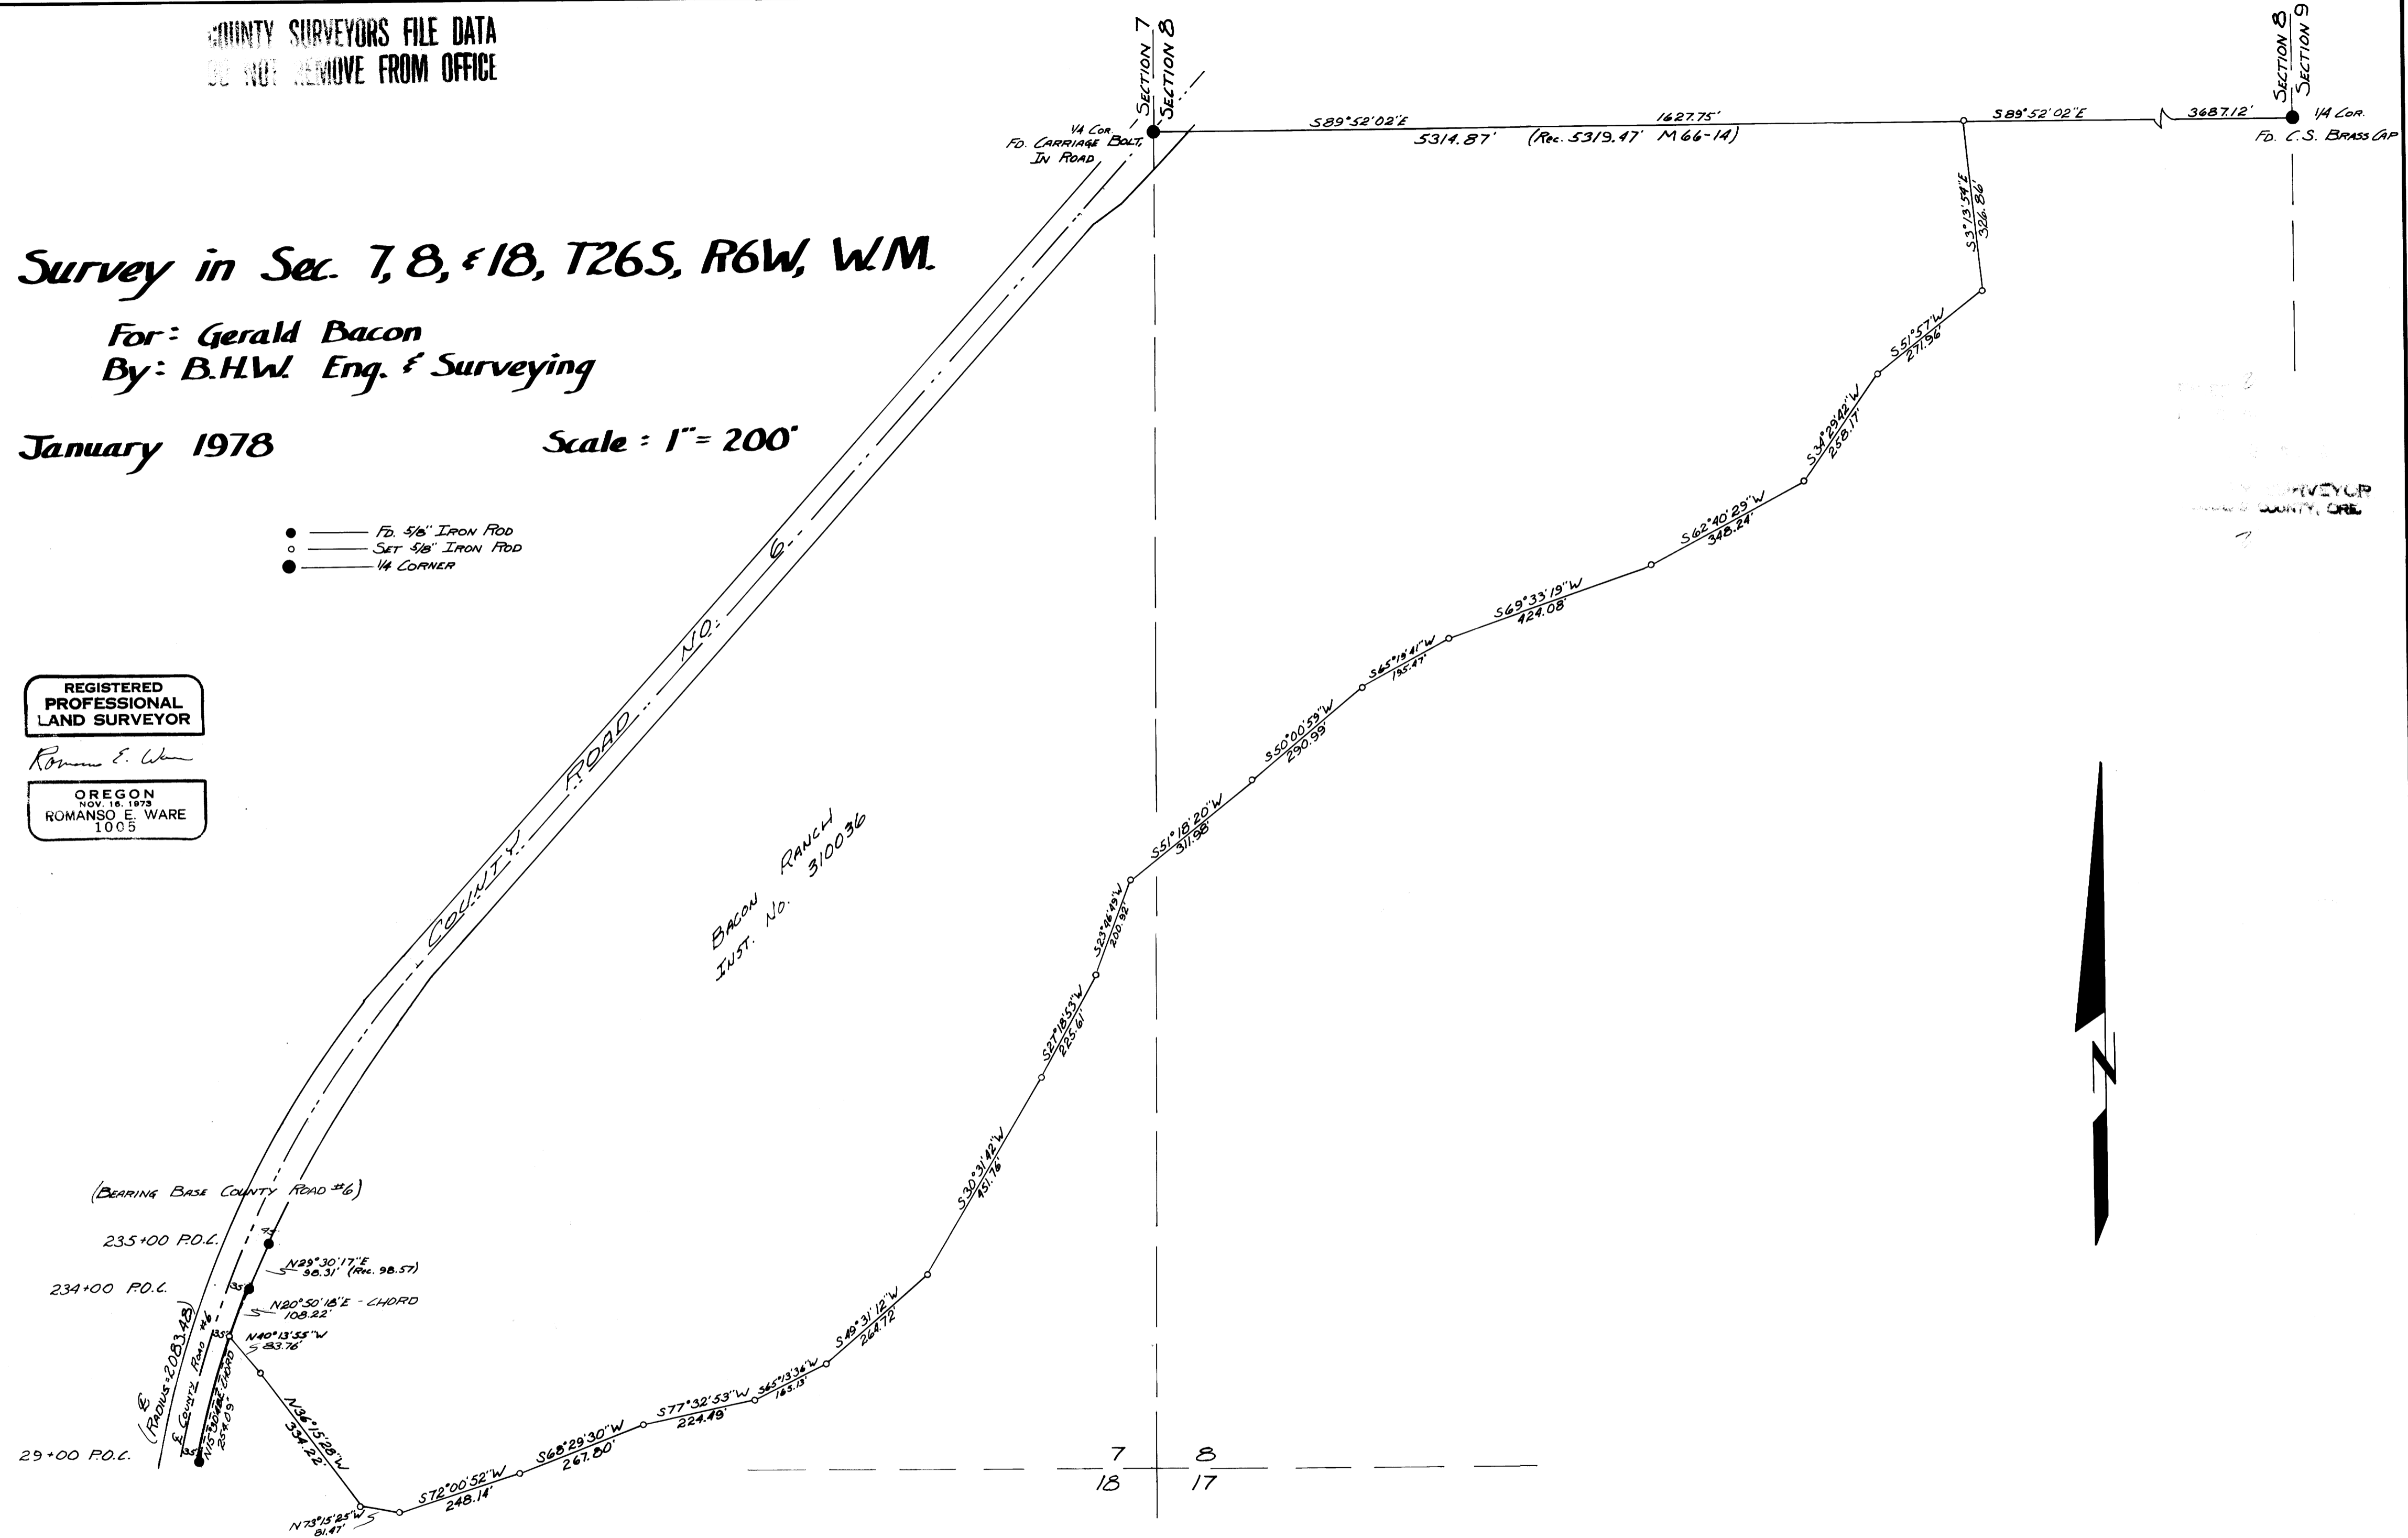

BACON RANCH  
INST. No. 310036

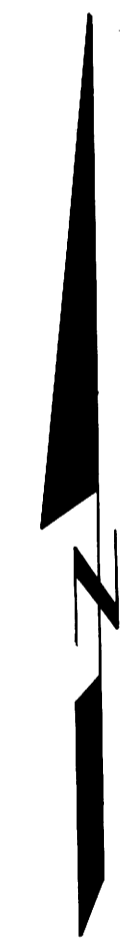

7 8  
18 17

REGISTERED  
PROFESSIONAL  
LAND SURVEYOR  
ROMANSO E. WARE  
1005