


COUNTY SURVEYORS FILE DATA  
DO NOT REMOVE FROM OFFICE

SURVEY TO SET PROPERTY CORNERS  
IN BLOCK 4, GABBERT'S ADDITION  
SECTION 21, T29S, R5W, W.M.  
FOR: ROLAND THEISS  
BY: HAROLD L. BALL - SURVEYOR  
MAY, 1978

NOTE:  
SET PINS ARE BASED BY APPORTIONING DISTANCES  
BETWEEN EXISTING PINS AS WELL AS LONG EXISTING  
PHYSICAL IMPROVEMENTS I.E. HOUSES,  
FENCES, & ROAD CENTERLINES

FILED  
MAY 8 1978  
7/2

M 69-71

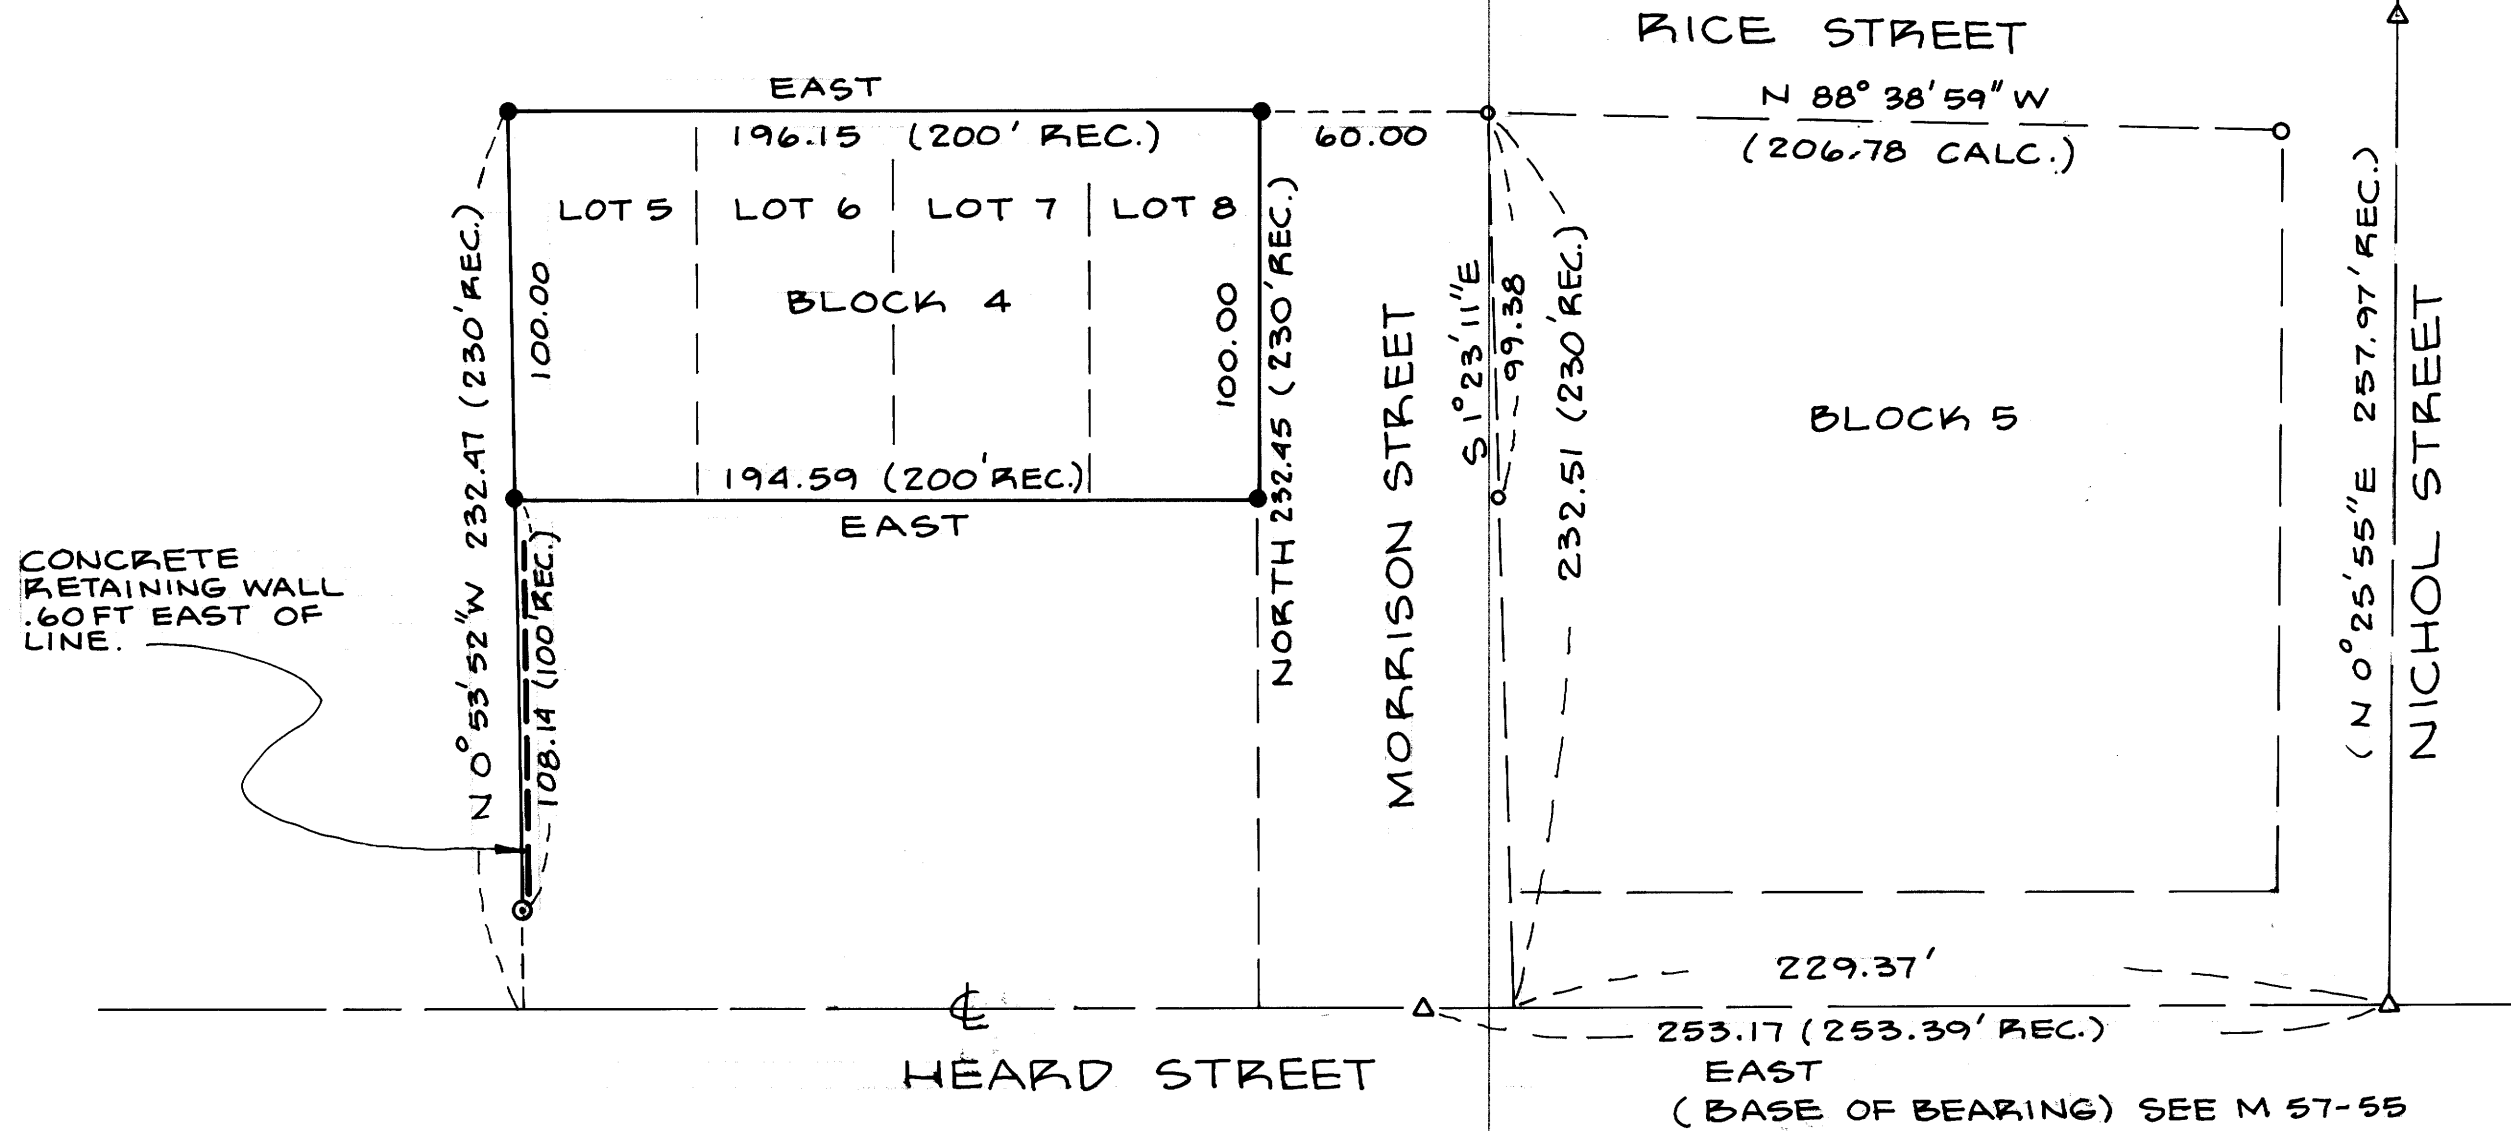

1" = 50'

**LEGEND**

- FD. 1/2" I.P.
- FD. 5/8" I.P.
- FD. 1/2" I.P.
- SET 5/8" I.P.
- △ FD. CONCRETE NAIL

REGISTERED  
PROFESSIONAL  
LAND SURVEYOR  
*Harold L. Ball*  
OREGON  
SEPT. 23, 1977  
HAROLD L. BALL  
1123

M 69-71