


SURVEYED FOR - T. RICHARDSON
SURVEYED BY - W.S. BARNES ENGR. SERVICE

MAY 1978

FILED
COUNTY CLERK
MAY 1978



SCALE 1" = 100'

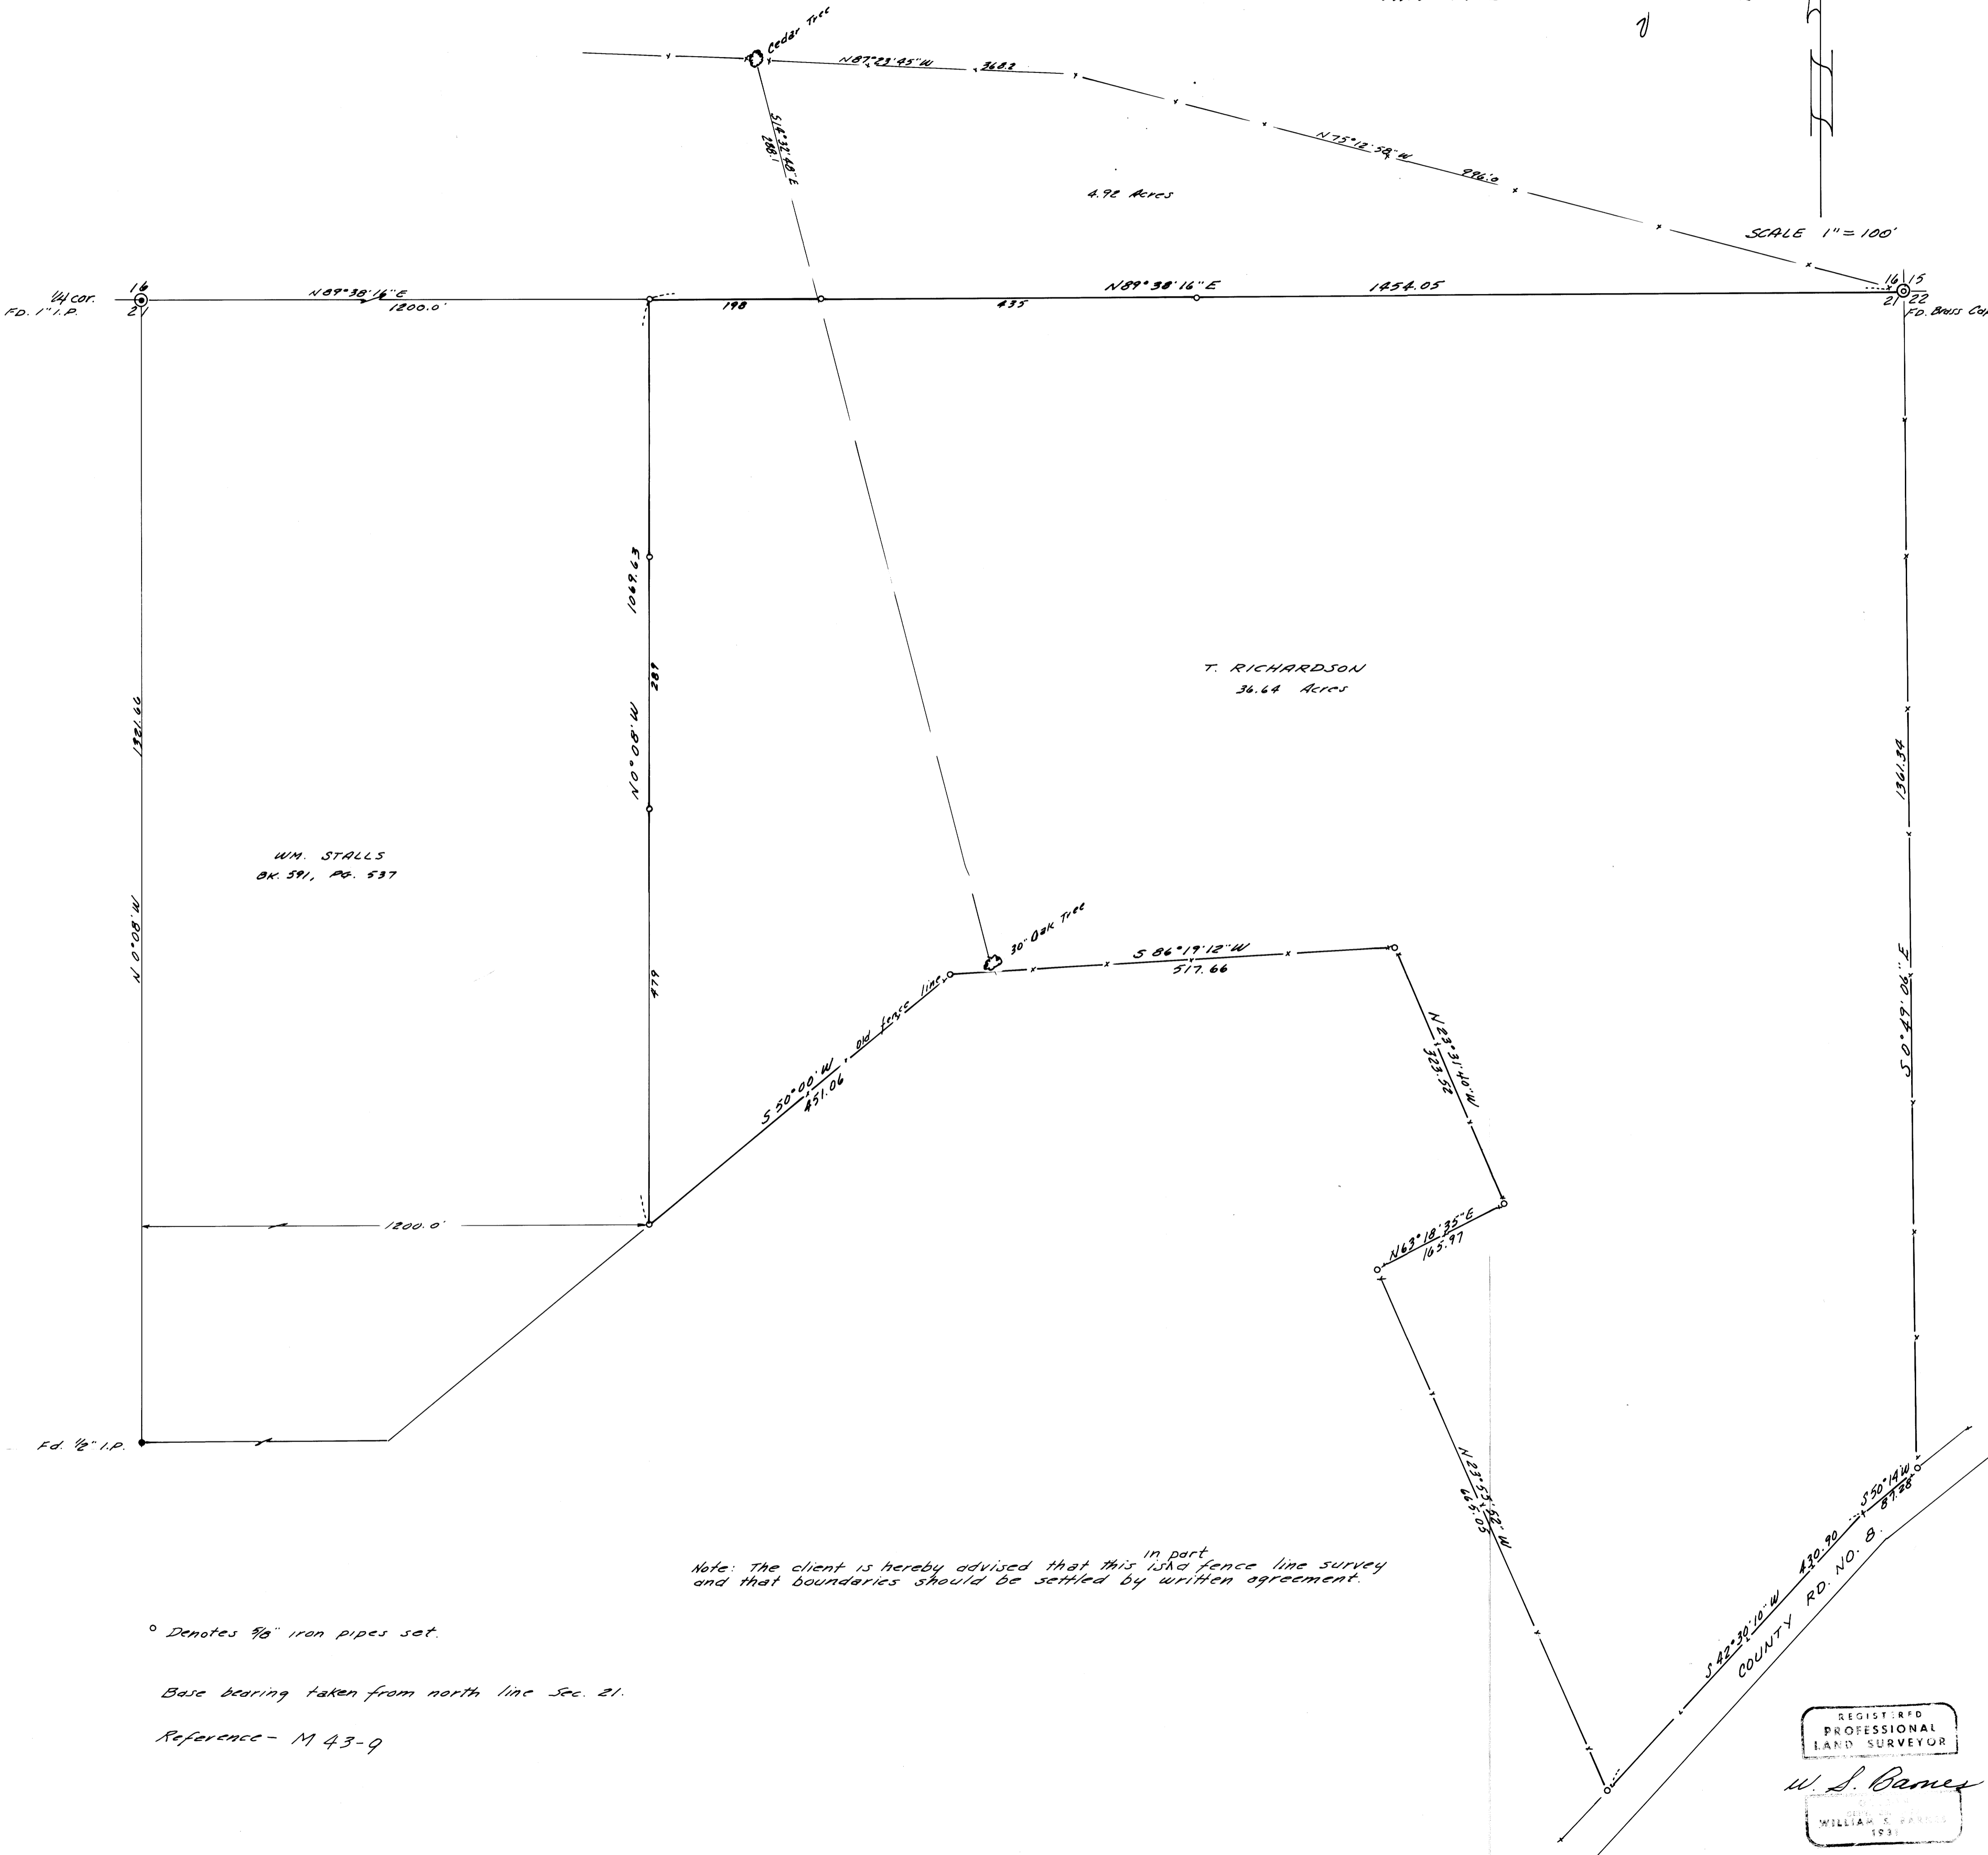

Note: The client is hereby advised that this is a fence line survey in part and that boundaries should be settled by written agreement.

o Denotes 3/4" iron pipes set.

Base bearing taken from north line Sec. 21.

Reference - M 43-9

REGISTERED
PROFESSIONAL
LAND SURVEYOR
W.S. Barnes
WILLIAM S. BARNES
1931