

COUNTY SURVEYORS FILE DATA
DO NOT REMOVE FROM OFFICE



FILED
RECEIVED
MAY 17 1978
COUNTY SURVEYOR
DOUGLAS COUNTY, ORE.

SURVEY TO SET CE 1/16 & CS1/16 CORNERS
SITUATED IN SEC. 28, T.20S. R.6W., W.M.

FOR: SUN STUDS INC.
BY: BURTON W. HOLT

SCALE 1" = 200'

MAY 1978

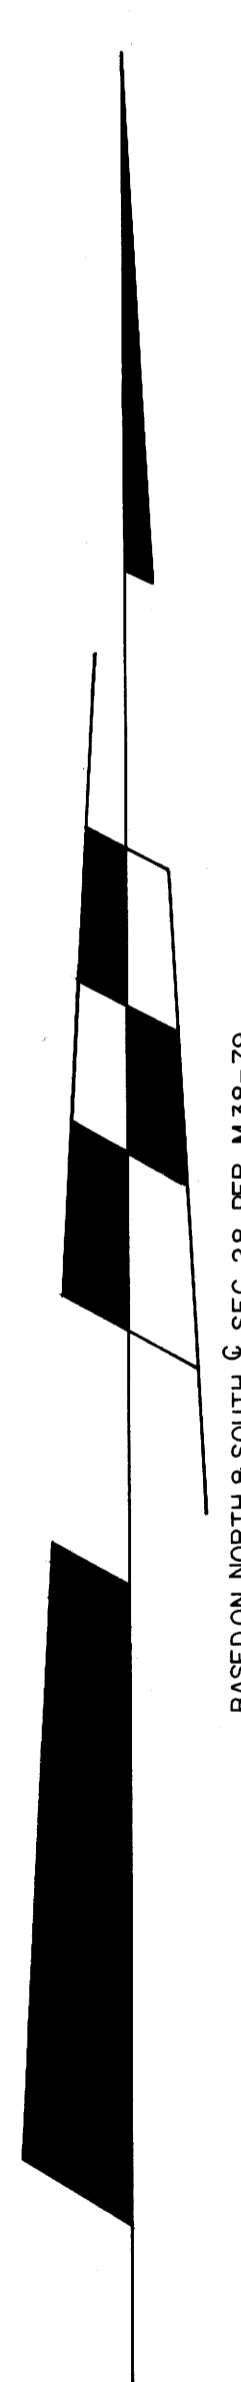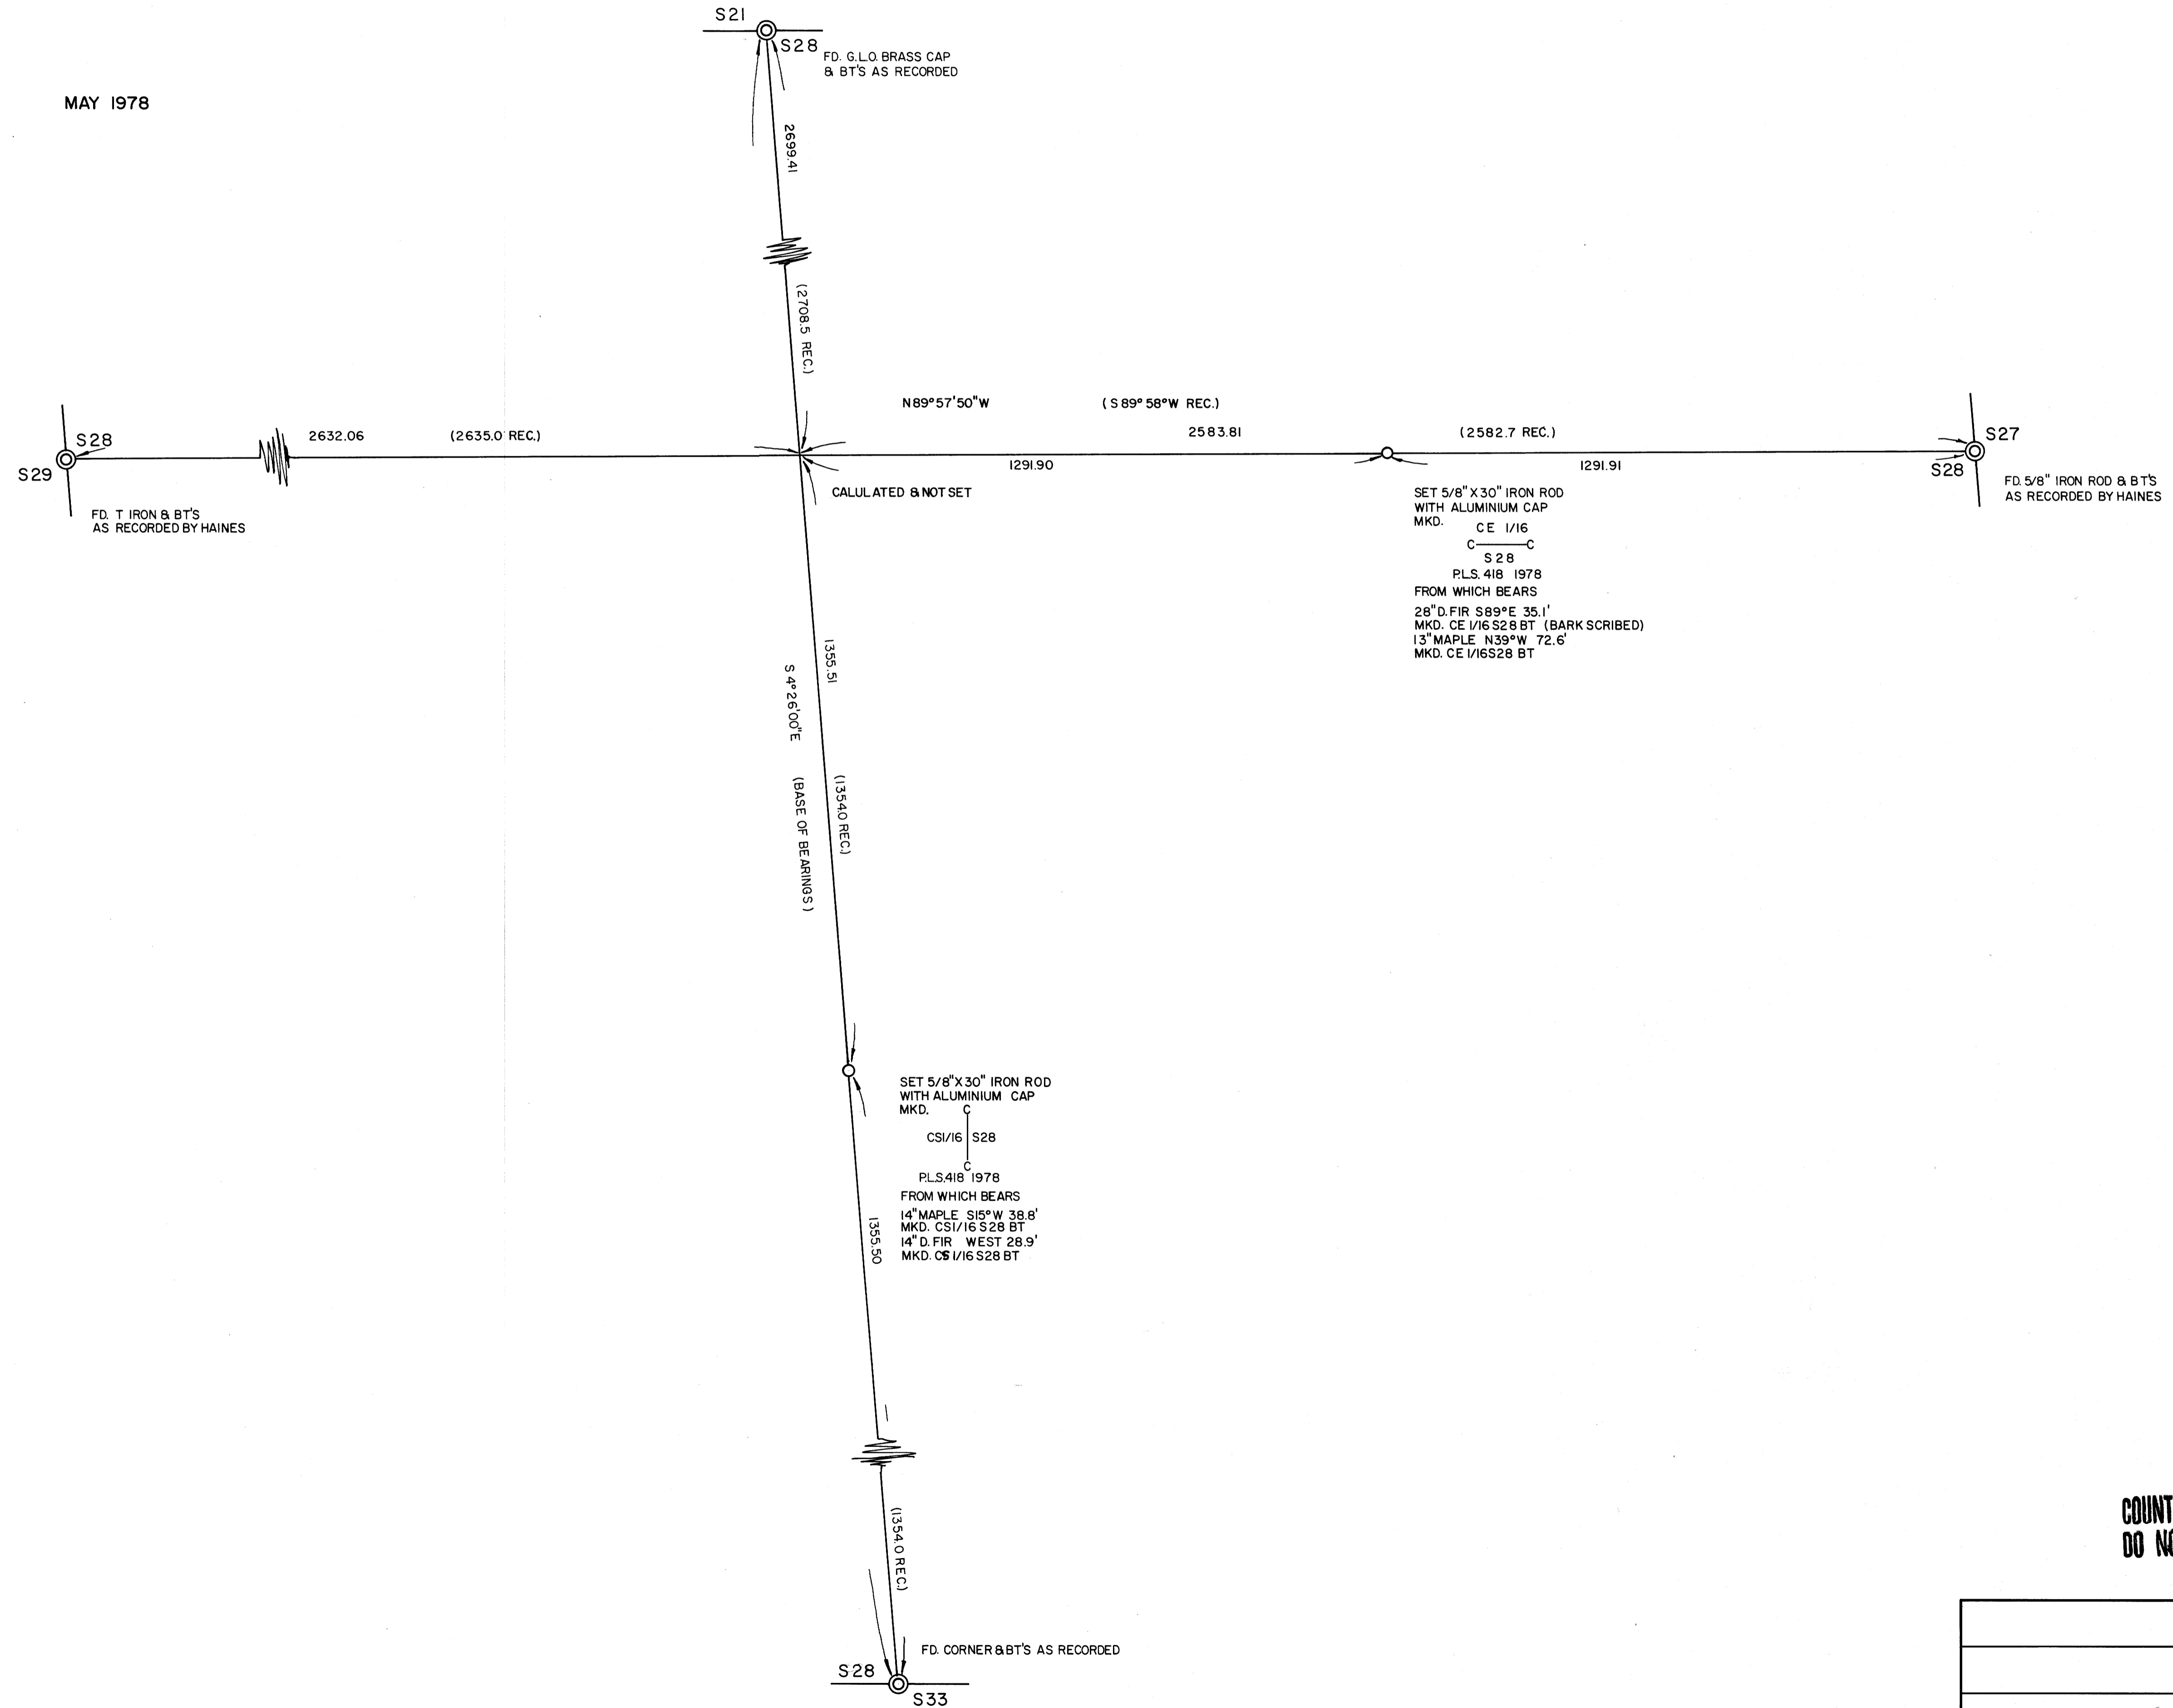

BASED ON NORTH & SOUTH & SEC. 28 PER. W.38-79

REGISTERED
PROFESSIONAL
LAND SURVEYOR
BURTON W. HOLT
OREGON
418

LEGEND: AS SHOWN

COUNTY SURVEYORS FILE DATA
DO NOT REMOVE FROM OFFICE

SCALE	DRAWN BY	
	REVISED	
DATE	APPROVED BY	DRAWING NUMBER