

Set brass cap mkd.
T22S, R9W, WM
N1/16 S15, S14 1977
From which a:
22" Douglas fir, 1 scribe
"N1/16 S15 BT"
Bears S61°W, 76.3 ft.
30" Douglas fir, 1 scribe
"N1/16 S14 BT"
Bears S32°E, 174.2 ft.

Set brass cap mkd.
T22S, R9W, WM
10, 11, 14, 15 1977
From which a:
60" Douglas fir original BT
Now 7 ft. dia. burned out hole
With stubs & old USGLO location poster
Bears S76°E, 25.7 ft.
16" Douglas fir original BT
Now 52" with old face, old "X" & scars
Bears S59°W, 151.8 ft.
(Record, S48 1/2°W, 145.9 ft.)
36" Douglas fir original BT
Now big stub
Bears N39°E, 151.7 ft.
(Record, N45°E, 132.0 ft.)
Above evidence noted by Haines in
May 16, 1967 survey, 1 concur.
52" Douglas fir original BT, 1 rescribe
"T22S, R9W, S15 BT"
Bears S59°W, 151.8 ft.
24" Douglas fir, 1 scribe
"T22S, R9W, S10 BT"
Bears N47°W, 62.5 ft.
22" Douglas fir, 1 scribe
"T22S, R9W, S11 BT"
Bears N24°E, 27.0 ft.
28" Douglas fir, 1 scribe
"T22S, R9W, S14 BT"
Bears S73°E, 67.2 ft.

Set brass cap mkd.
T22S, R9W, WM
NWC DLC 44 1977
From which a:
24" Douglas fir, 1 scribe
"T22S, R9W
NWC DLC 44 BT"
Bears S71°W, 11.5 ft.
22" Douglas fir, 1 scribe
"T22S, R9W
NWC DLC 44 BT"
Bears S82°E, 57.0 ft.
Original BT's gone. Area
on probable slide 70-80
years old.

Mkd. "X" on sandstone
bedrock on N shoulder of
small ridge running E-W
From which a:
10" Douglas fir, 1 scribe
"W1/16 S14 BT"
Bears S61°E, 86.0 ft.
6" Douglas fir, 1 scribe
"W1/16 S11 BT"
Bears N28°W, 49.3 ft.


Cor. in Weatherly Creek Rd.
Fd. brass cap at Witness Cor.
20 ft. West mkd.
Wit. Cor. 1/4 S11, S14
T22S, R9W
County Surveyor's Office 1958
From which Witness Cor. a:
26" red fir BT
Scribe vis.
Bears N6 1/2°E, 40.5 ft.
36" red fir BT
Face vis.
Bears N55°E, 159.5 ft.

Set brass cap mkd.
T22S, R9W, WM
NEC DLC No. 43
DLC No. 44 1977
From which a:
48" maple, 1 scribe
"T22S, R9W, NEC DLC 43 BT"
Bears N78°W, 6.7 ft.
12" oak, 1 scribe
"T22S, R9W, NEC DLC 43 BT"
Bears North, 132.4 ft.
Ancient fence line bears N & S
with old fence line bearing W.

STATEMENT:
I, Floyd V. Weatherly, and
my family, have owned the property
adjacent to and east of above corner
for 90 years. These property lines
and corner have been accepted as
the location of the NE Corner of
Donation Land Claim No. 43
for this period of time.
Floyd V. Weatherly
Signed: Floyd V. Weatherly

July 2, 1977
Witness:
W. Carey Weatherly

{ Line calls to South
look very good.

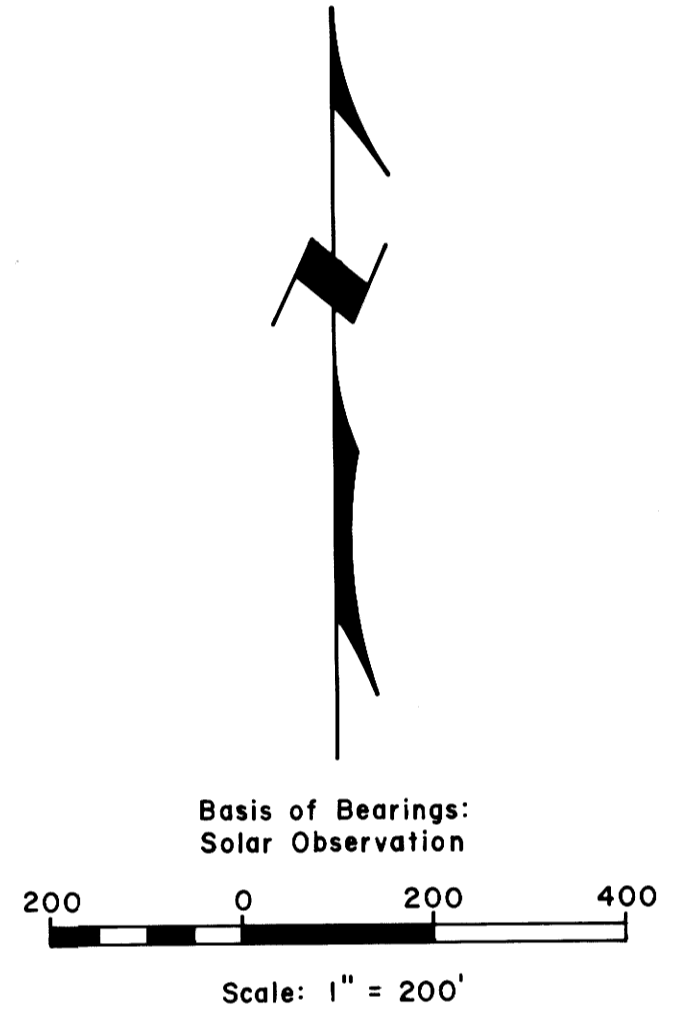

LEGEND

- Corner found
- Corner set
- Corner projected
- 5/8" iron rod found
- 5/8" iron rod with aluminum cap set
- Property line marked with blazes and paint
- Line run
- Line not run

REGISTERED
PROFESSIONAL
LAND SURVEYOR
B.A. Shaner
OREGON
S. A. SHANER
430

REGISTERED PROFESSIONAL
ENGINEER
6906
B.A. Shaner
OREGON
July 9, 1962
BRUCE A. SHANER

PROPERTY LINE SURVEY IN THE NW 1/4
SEC. 14, T. 22 S., R. 9 W., W. M.
For: Reservation Ranch
By: Shaner Engineering, Inc.
August 26, 1977