


COUNTY SURVEYORS FILE DATA
DO NOT REMOVE FROM OFFICE

FILED 2
RECEIVED JHW

OCT 23 1978

COUNTY SURVEYOR
GEORGE L. BROWN, ORE.

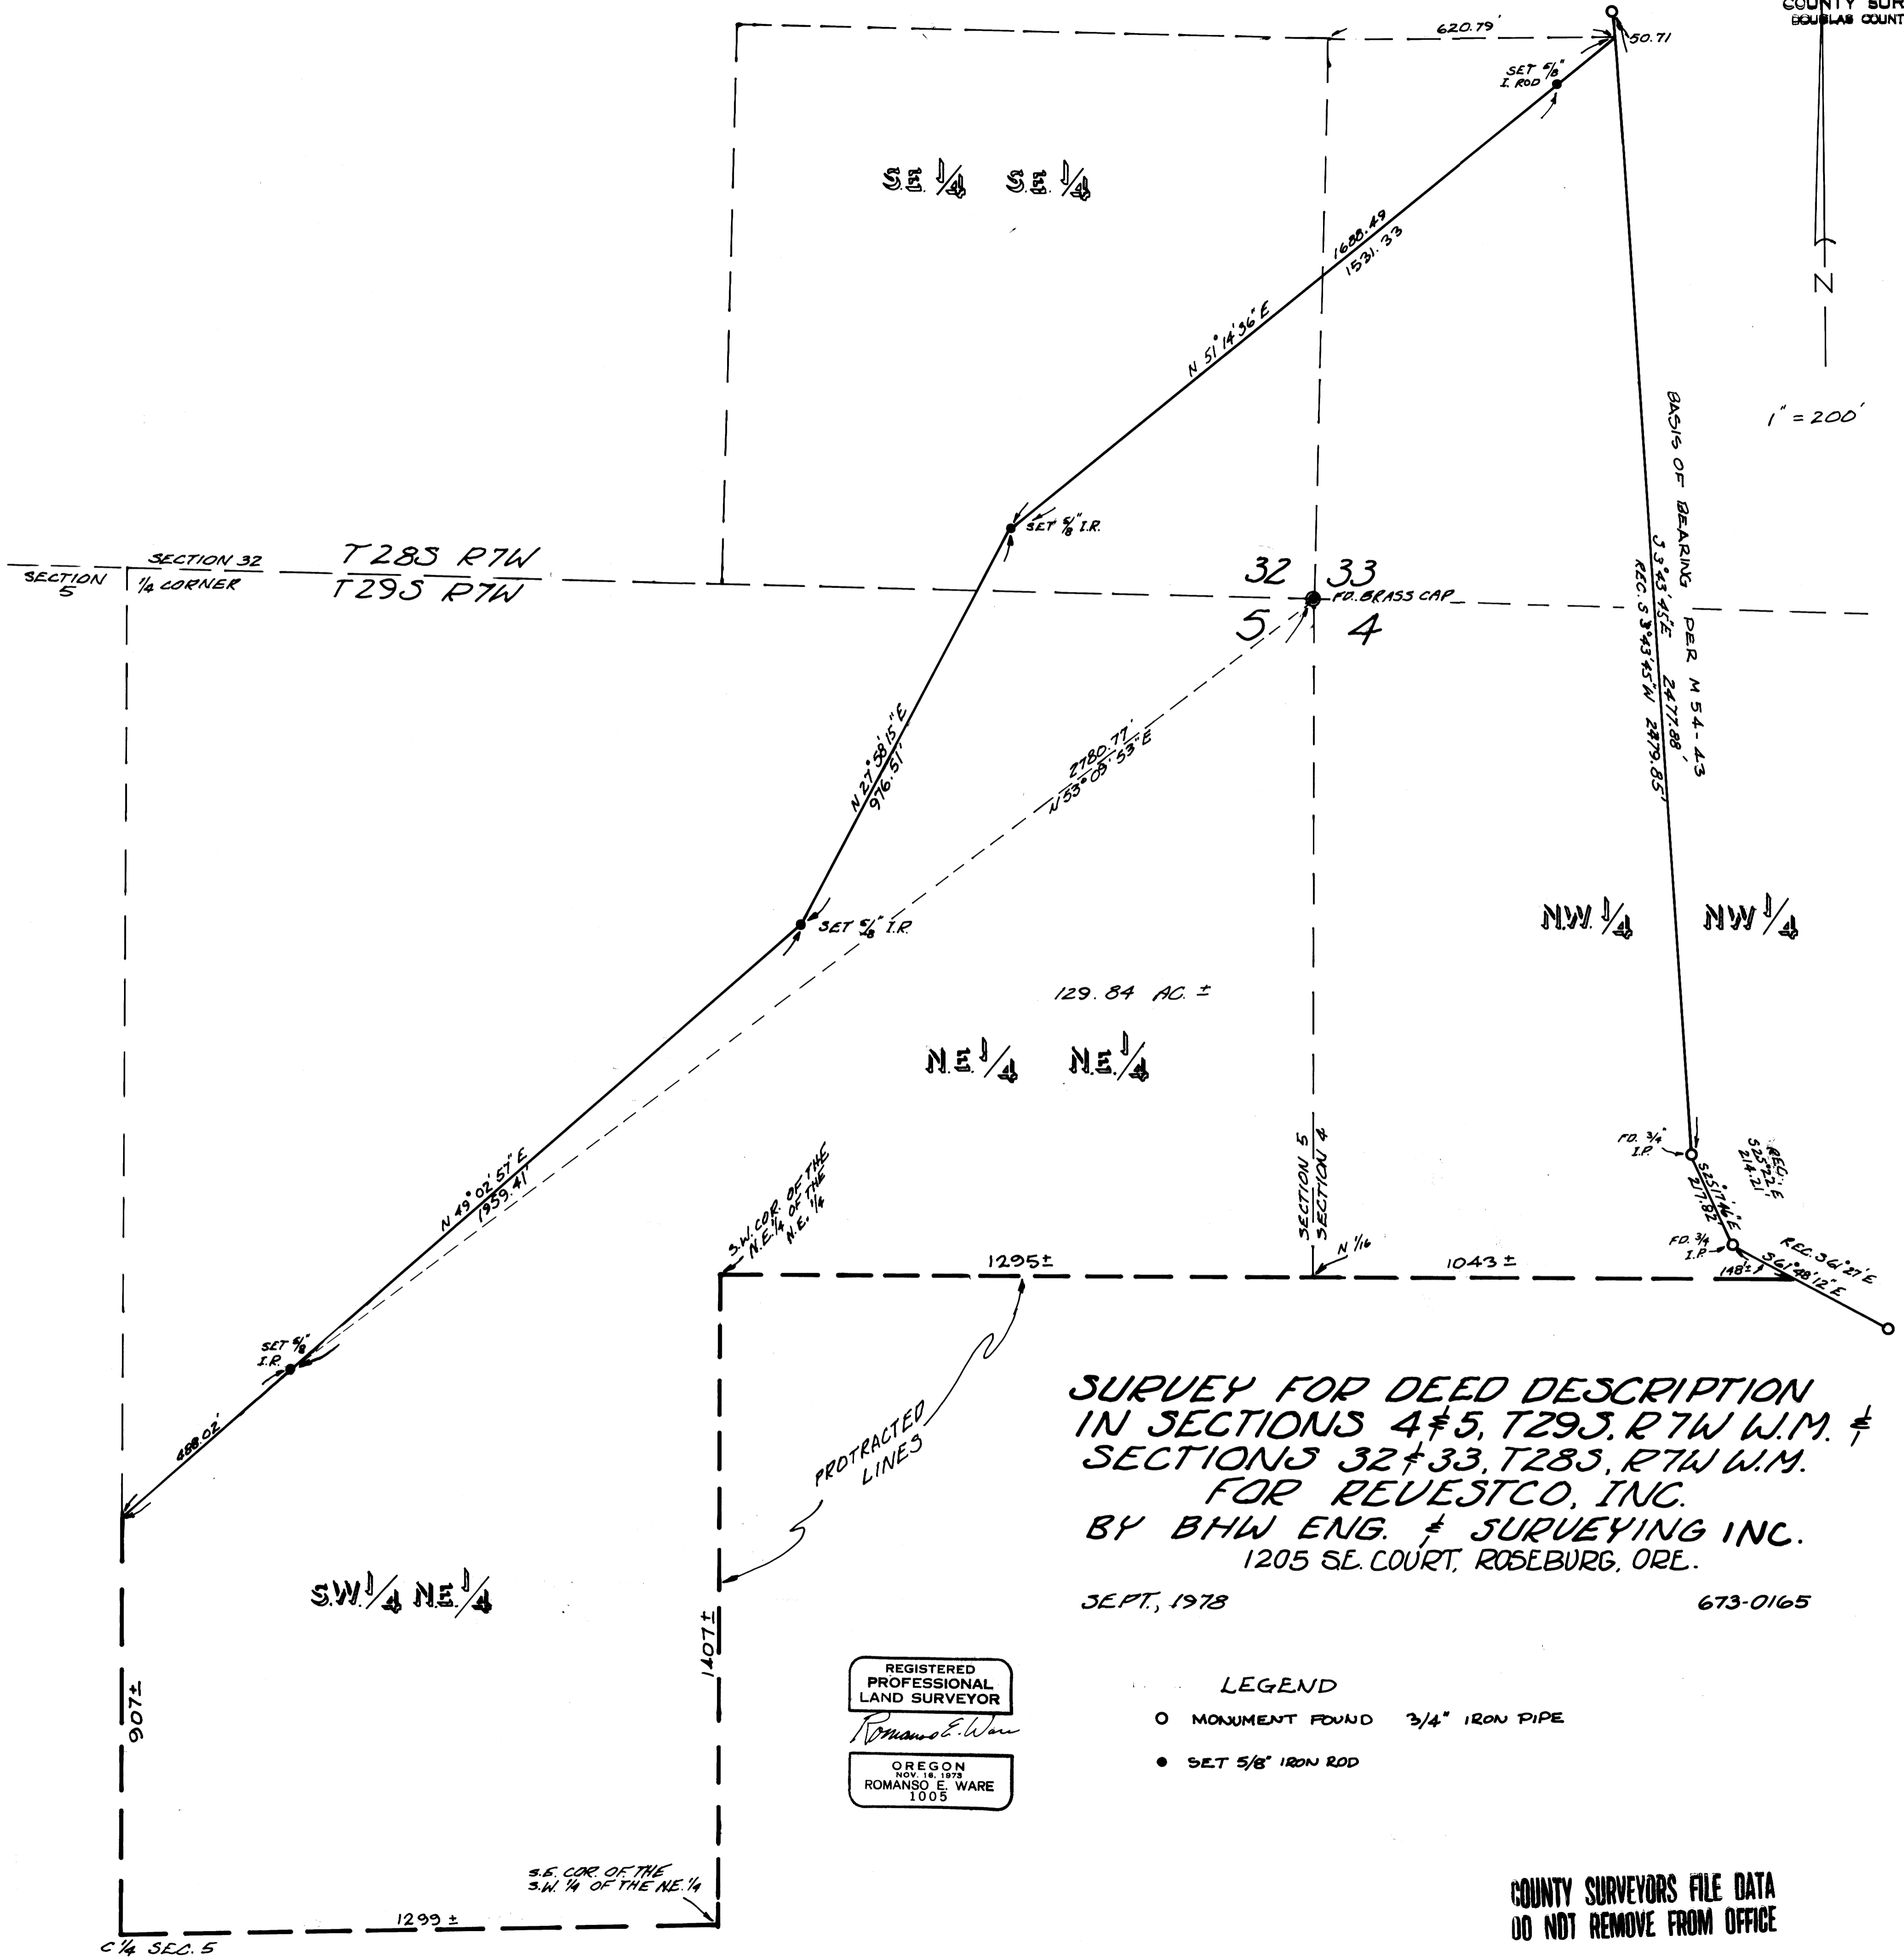

**SURVEY FOR DEED DESCRIPTION
IN SECTIONS 4 & 5, T29S, R7W W.M. &
SECTIONS 32 & 33, T28S, R7W W.M.
FOR REVESTCO, INC.
BY BHW ENG. & SURVEYING INC.
1205 SE. COURT, ROSEBURG, ORE.**

SEPT., 1978

673-0165

REGISTERED
PROFESSIONAL
LAND SURVEYOR

Romanso E. Ware

OREGON
NOV. 18, 1973
ROMANSO E. WARE
1005

LEGEND

- MONUMENT FOUND 3/4" IRON PIPE
- SET 5/8" IRON ROD

COUNTY SURVEYORS FILE DATA
DO NOT REMOVE FROM OFFICE