


MAP FILE *M 72-5*
 COUNTY SURVEYORS FILE DATA
 DO NOT REMOVE FROM OFFICE

FILED *7*
 RECEIVED *SB*
 APR 21 1978
 COUNTY SURVEYOR
 DOUGLAS COUNTY, ORE.
nr

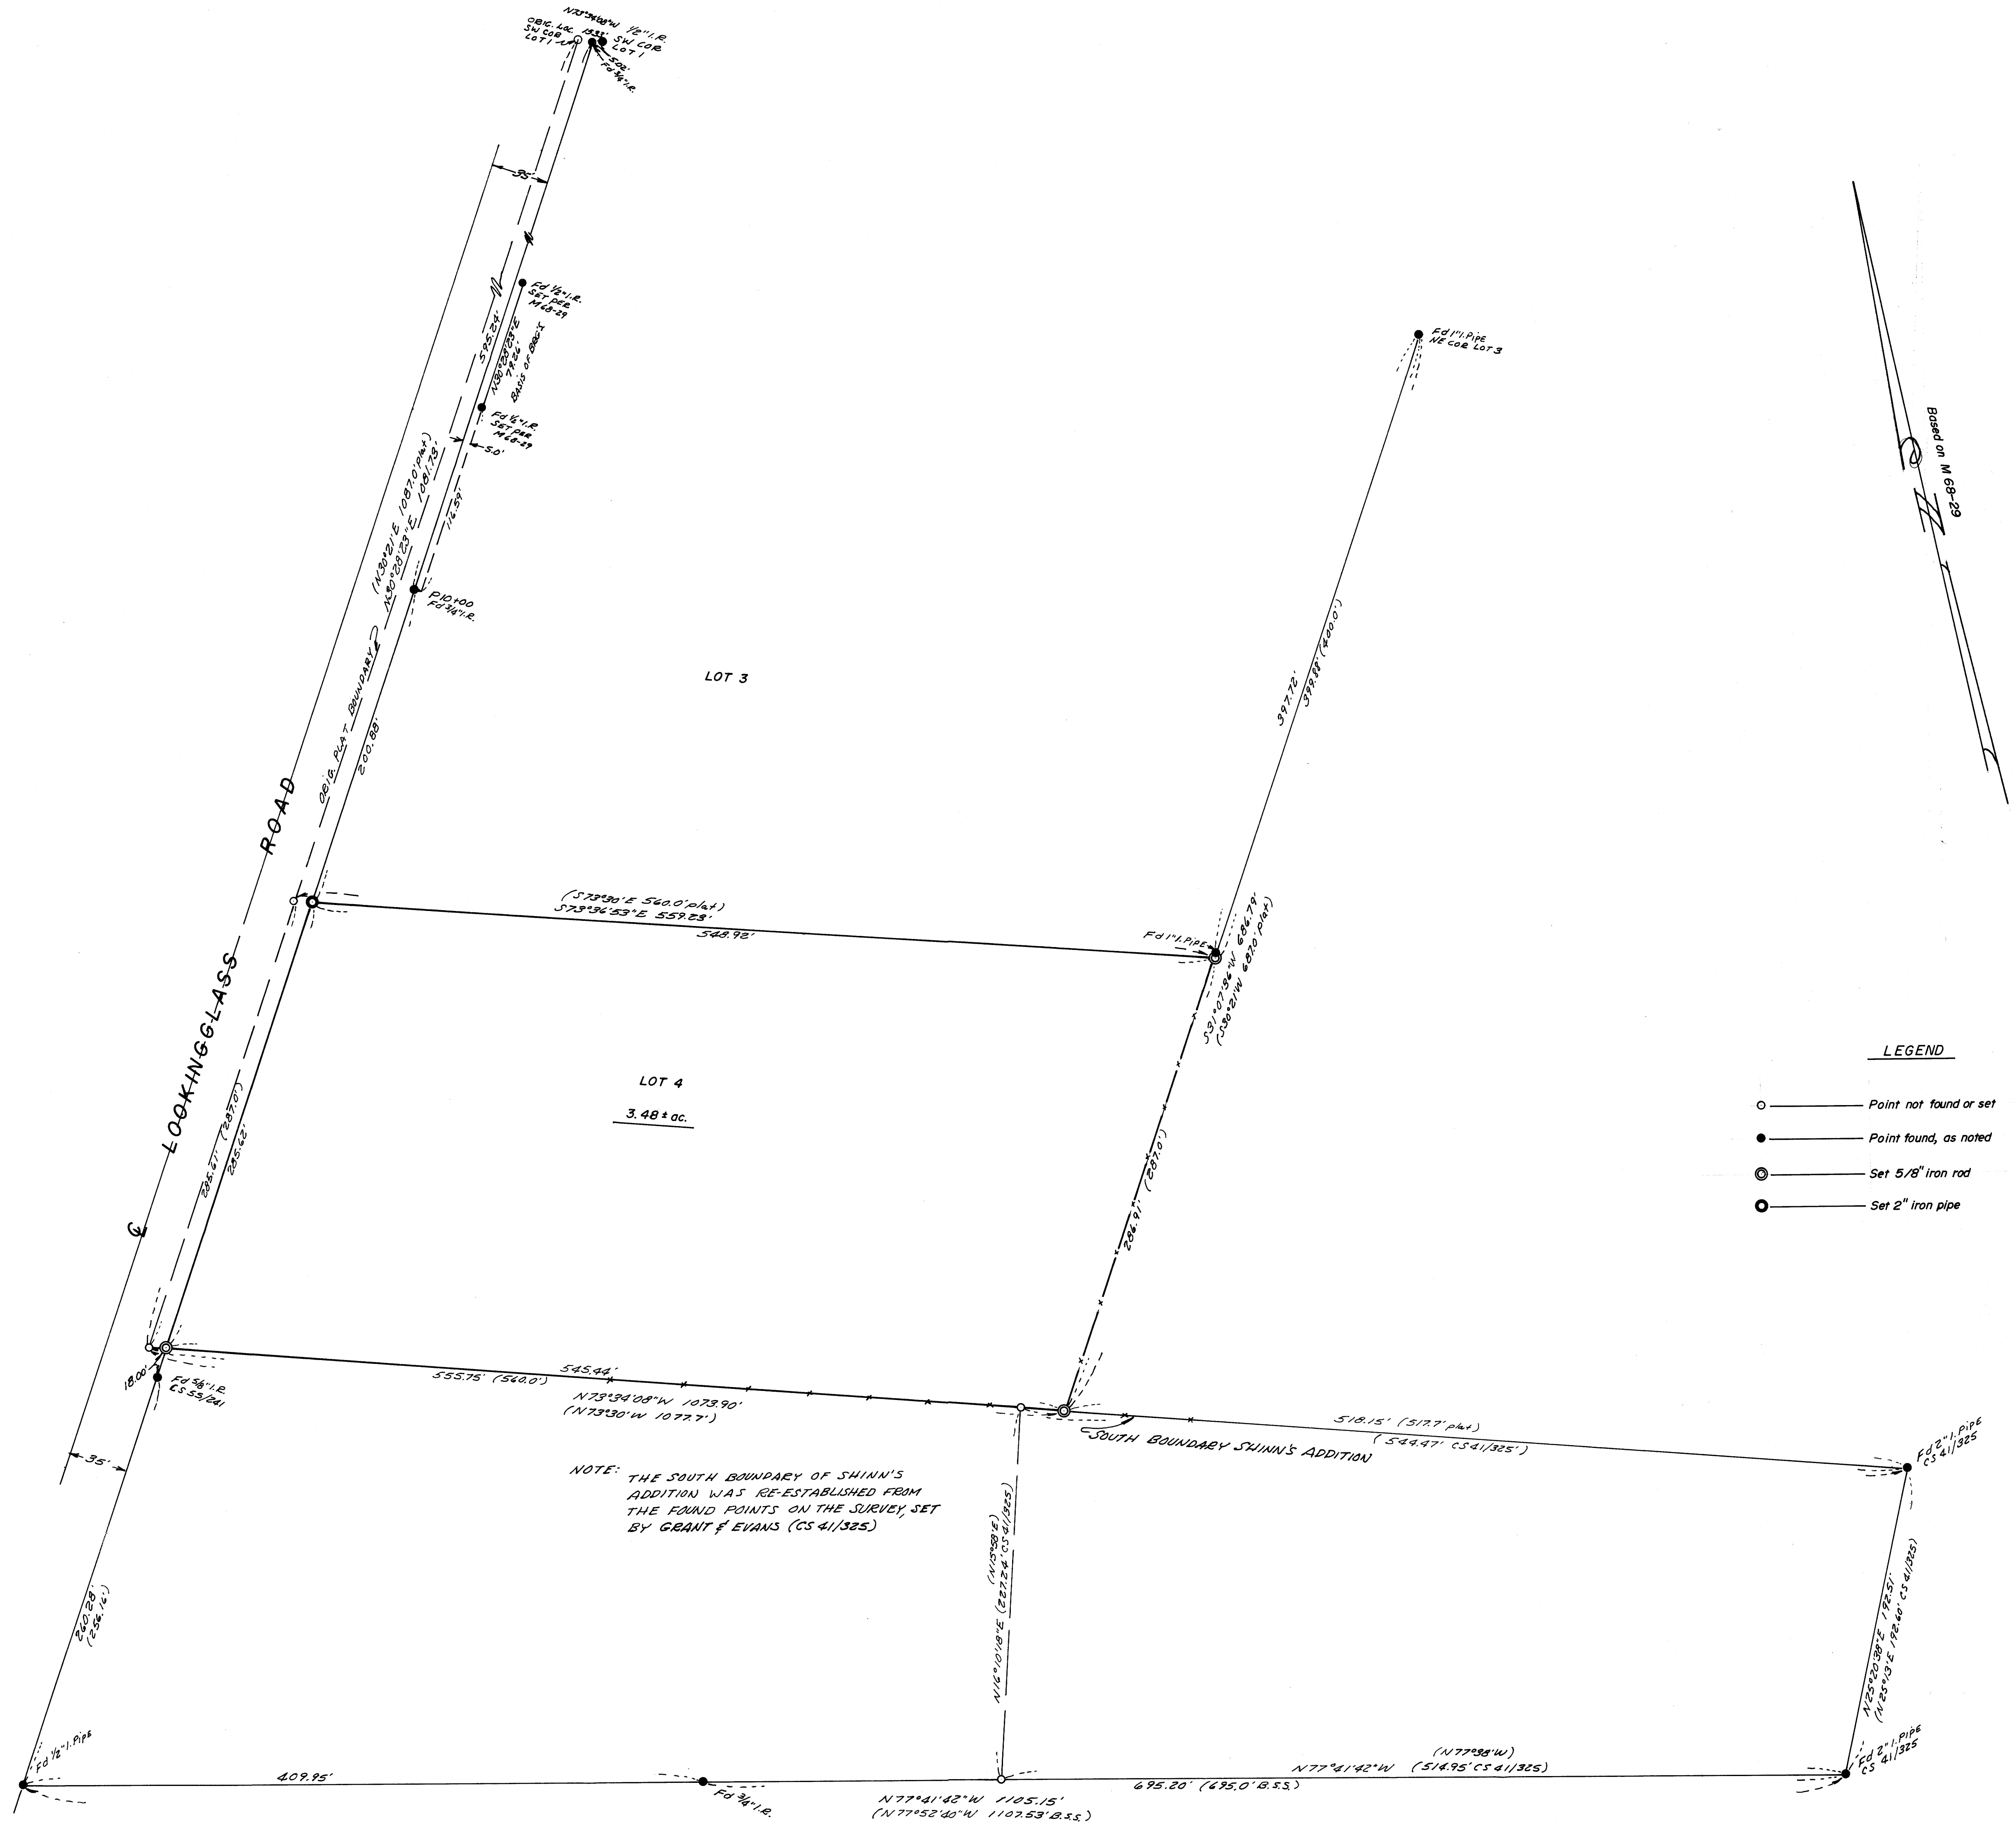

LEGEND

- — Point not found or set
- — Point found, as noted
- ⊙ — Set 5/8" iron rod
- ⦿ — Set 2" iron pipe

REGISTERED
 PROFESSIONAL
 LAND SURVEYOR
Glenn S. Baughman
 GLENN S. BAUGHMAN
 201

COUNTY SURVEYORS FILE DATA
 DO NOT REMOVE FROM OFFICE

SURVEY FOR PROPERTY CORNERS IN LOT 4, BLOCK 4, SHINN'S ADDITION - SEC. 22, T.27S. R.6W.W.M.		
FOR: RICHARD HARRELL	SCALE: 1"=50'	DRAWN BY: Eob
BY: BAUGHMAN TECHNICAL SERVICES INC		REVISED:
DATE: APRIL 1978	APPROVED BY:	DRAWING NUMBER: FM 1-35