

LOT SURVEY IN BLOCK 2, BROWNS ADDITION
SECTION 4, T25S, R5W, W.M. DOUGLAS COUNTY, OREGON.

FOR: WILLIAM & FRANCIS MACKENZIE
BY: ROBERT L. DOLAN
DATE: MARCH 1979
SCALE: 1" = 20'

COUNTY SURVEYORS FILE DATA
DO NOT REMOVE FROM OFFICE


FILED
RECEIVED *JD*
MAR 21 1979
COUNTY SURVEYOR
DOUGLAS COUNTY, ORE.
TD

Base Bearing: C.S. File # RM 2-59

- LEGEND**
- - Set 5/8" Iron rod
 - - Fd. 5/8" Iron rod
 - - Man Hole's

REGISTERED
PROFESSIONAL
LAND SURVEYOR
Robert L. Dolan
OREGON
JULY 30, 1976
ROBERT L. DOLAN
1076

WALNUT ST.

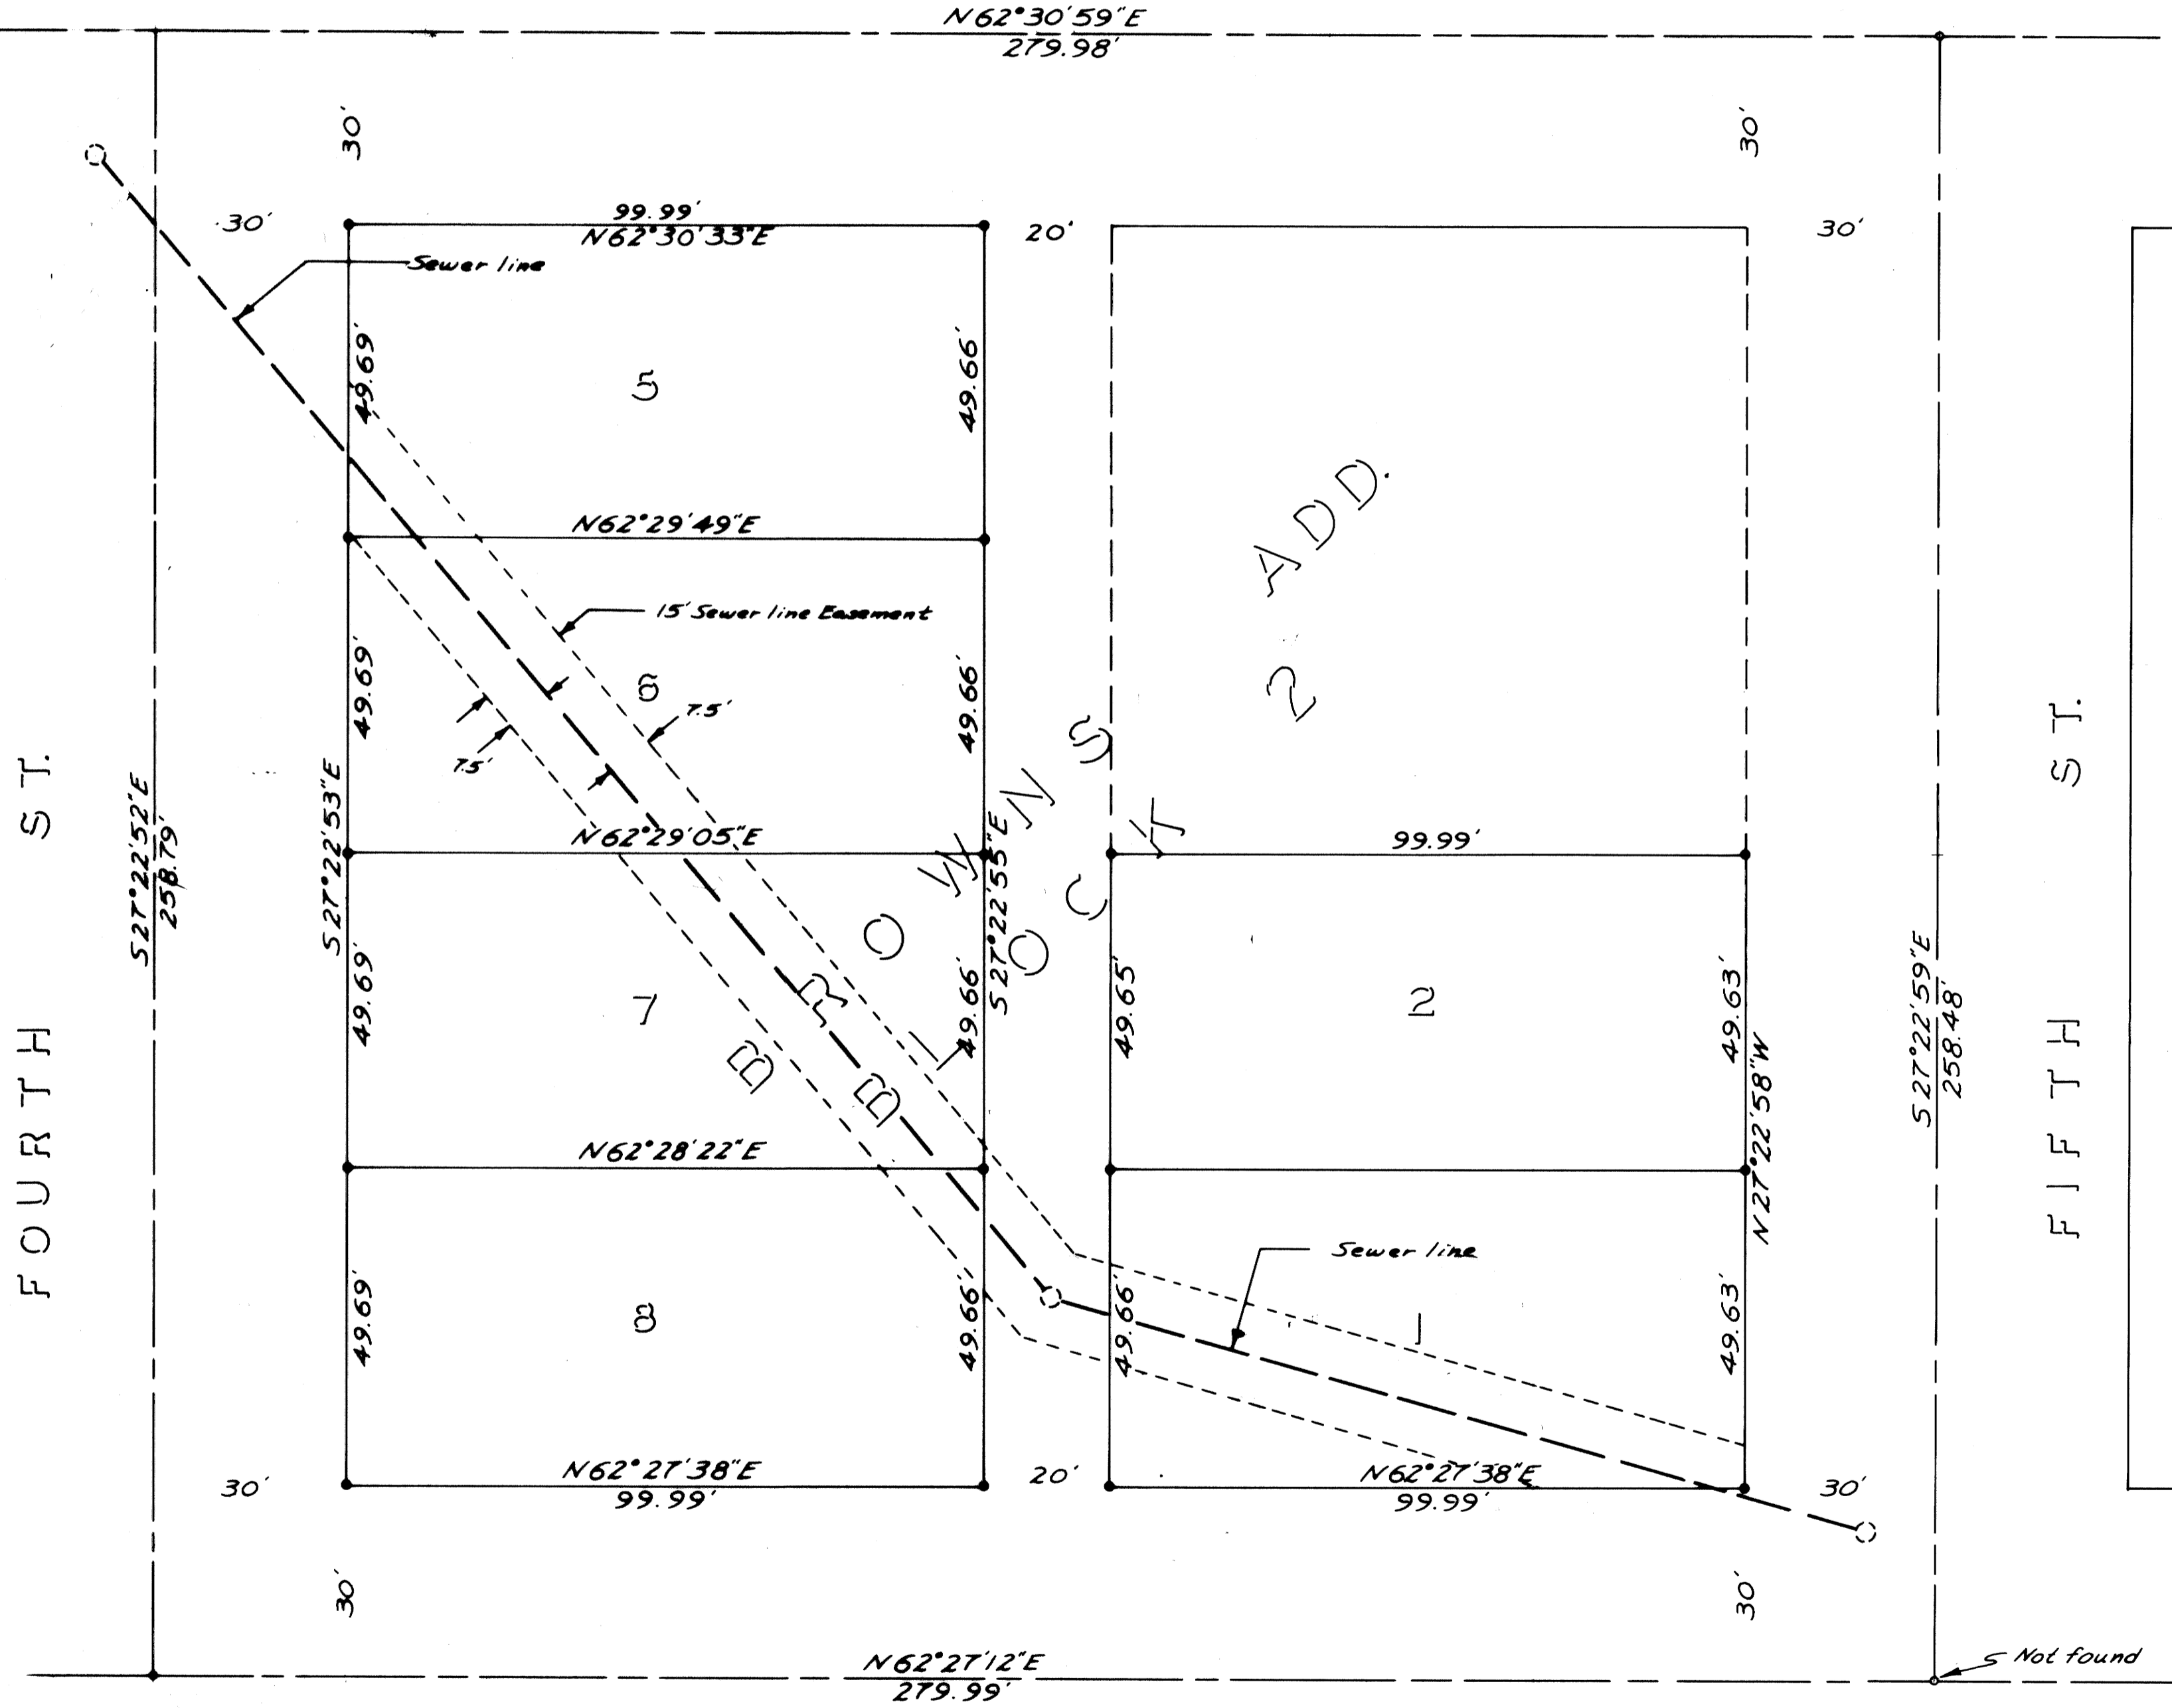

CHESTNUT ST.

COUNTY SURVEYORS FILE DATA
DO NOT REMOVE FROM OFFICE

MAP FILE 1120-52

2-30