

# SURVEY FOR U.S. FOREST SERVICE

OF SE 1/4 SEC. 7, T.30 S., R.1 W., W.M.  
DOUGLAS COUNTY OREGON  
BY UMPQUA SURVEYING COMPANY  
MYRTLE CREEK, ORE. 863-5201

FILED  
RECEIVED  
MAY 10 1979  
COUNTY SURVEYOR  
DOUGLAS COUNTY, ORE.

DATE OF SURVEY: APRIL 1979


SCALE 1" = 200'  
0 100 200  
FEET

I, William J. Ruppert, a registered professional land surveyor in the State of Oregon hereby certify that this plat and the notes hereon, or attached, are a correct representation of a survey performed during January through April 1979, for the U.S. Forest Service, in accordance with the statutes of the State of Oregon and with the articles of the contract.



William J. Ruppert

## LEGEND


- CORNER MONUMENTS FOUND
- CORNER MONUMENTS SET
- ( ) RECORD CALL PER M 88-66 COUNTY SURVEYOR'S FILE
- [ ] RECORD CALL PER GLO PLAT FEB. 20, 1958
- LINE POINTED WITH STEEL FENCE POSTS AND GOVERNMENT PROPERTY SIGNS
- + NO MONUMENT, CALCULATED POINT ONLY.

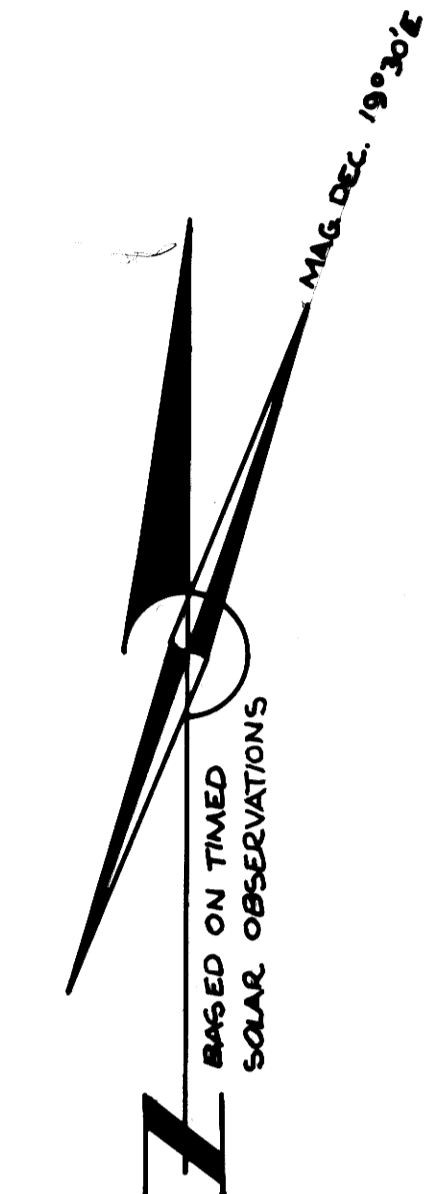


NOTE: DISTANCES SHOWN ARE NOT REDUCED TO SEA LEVEL.

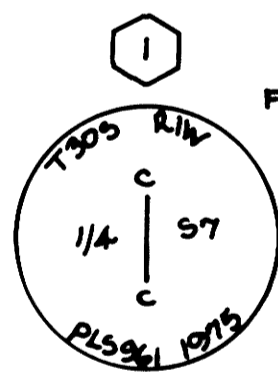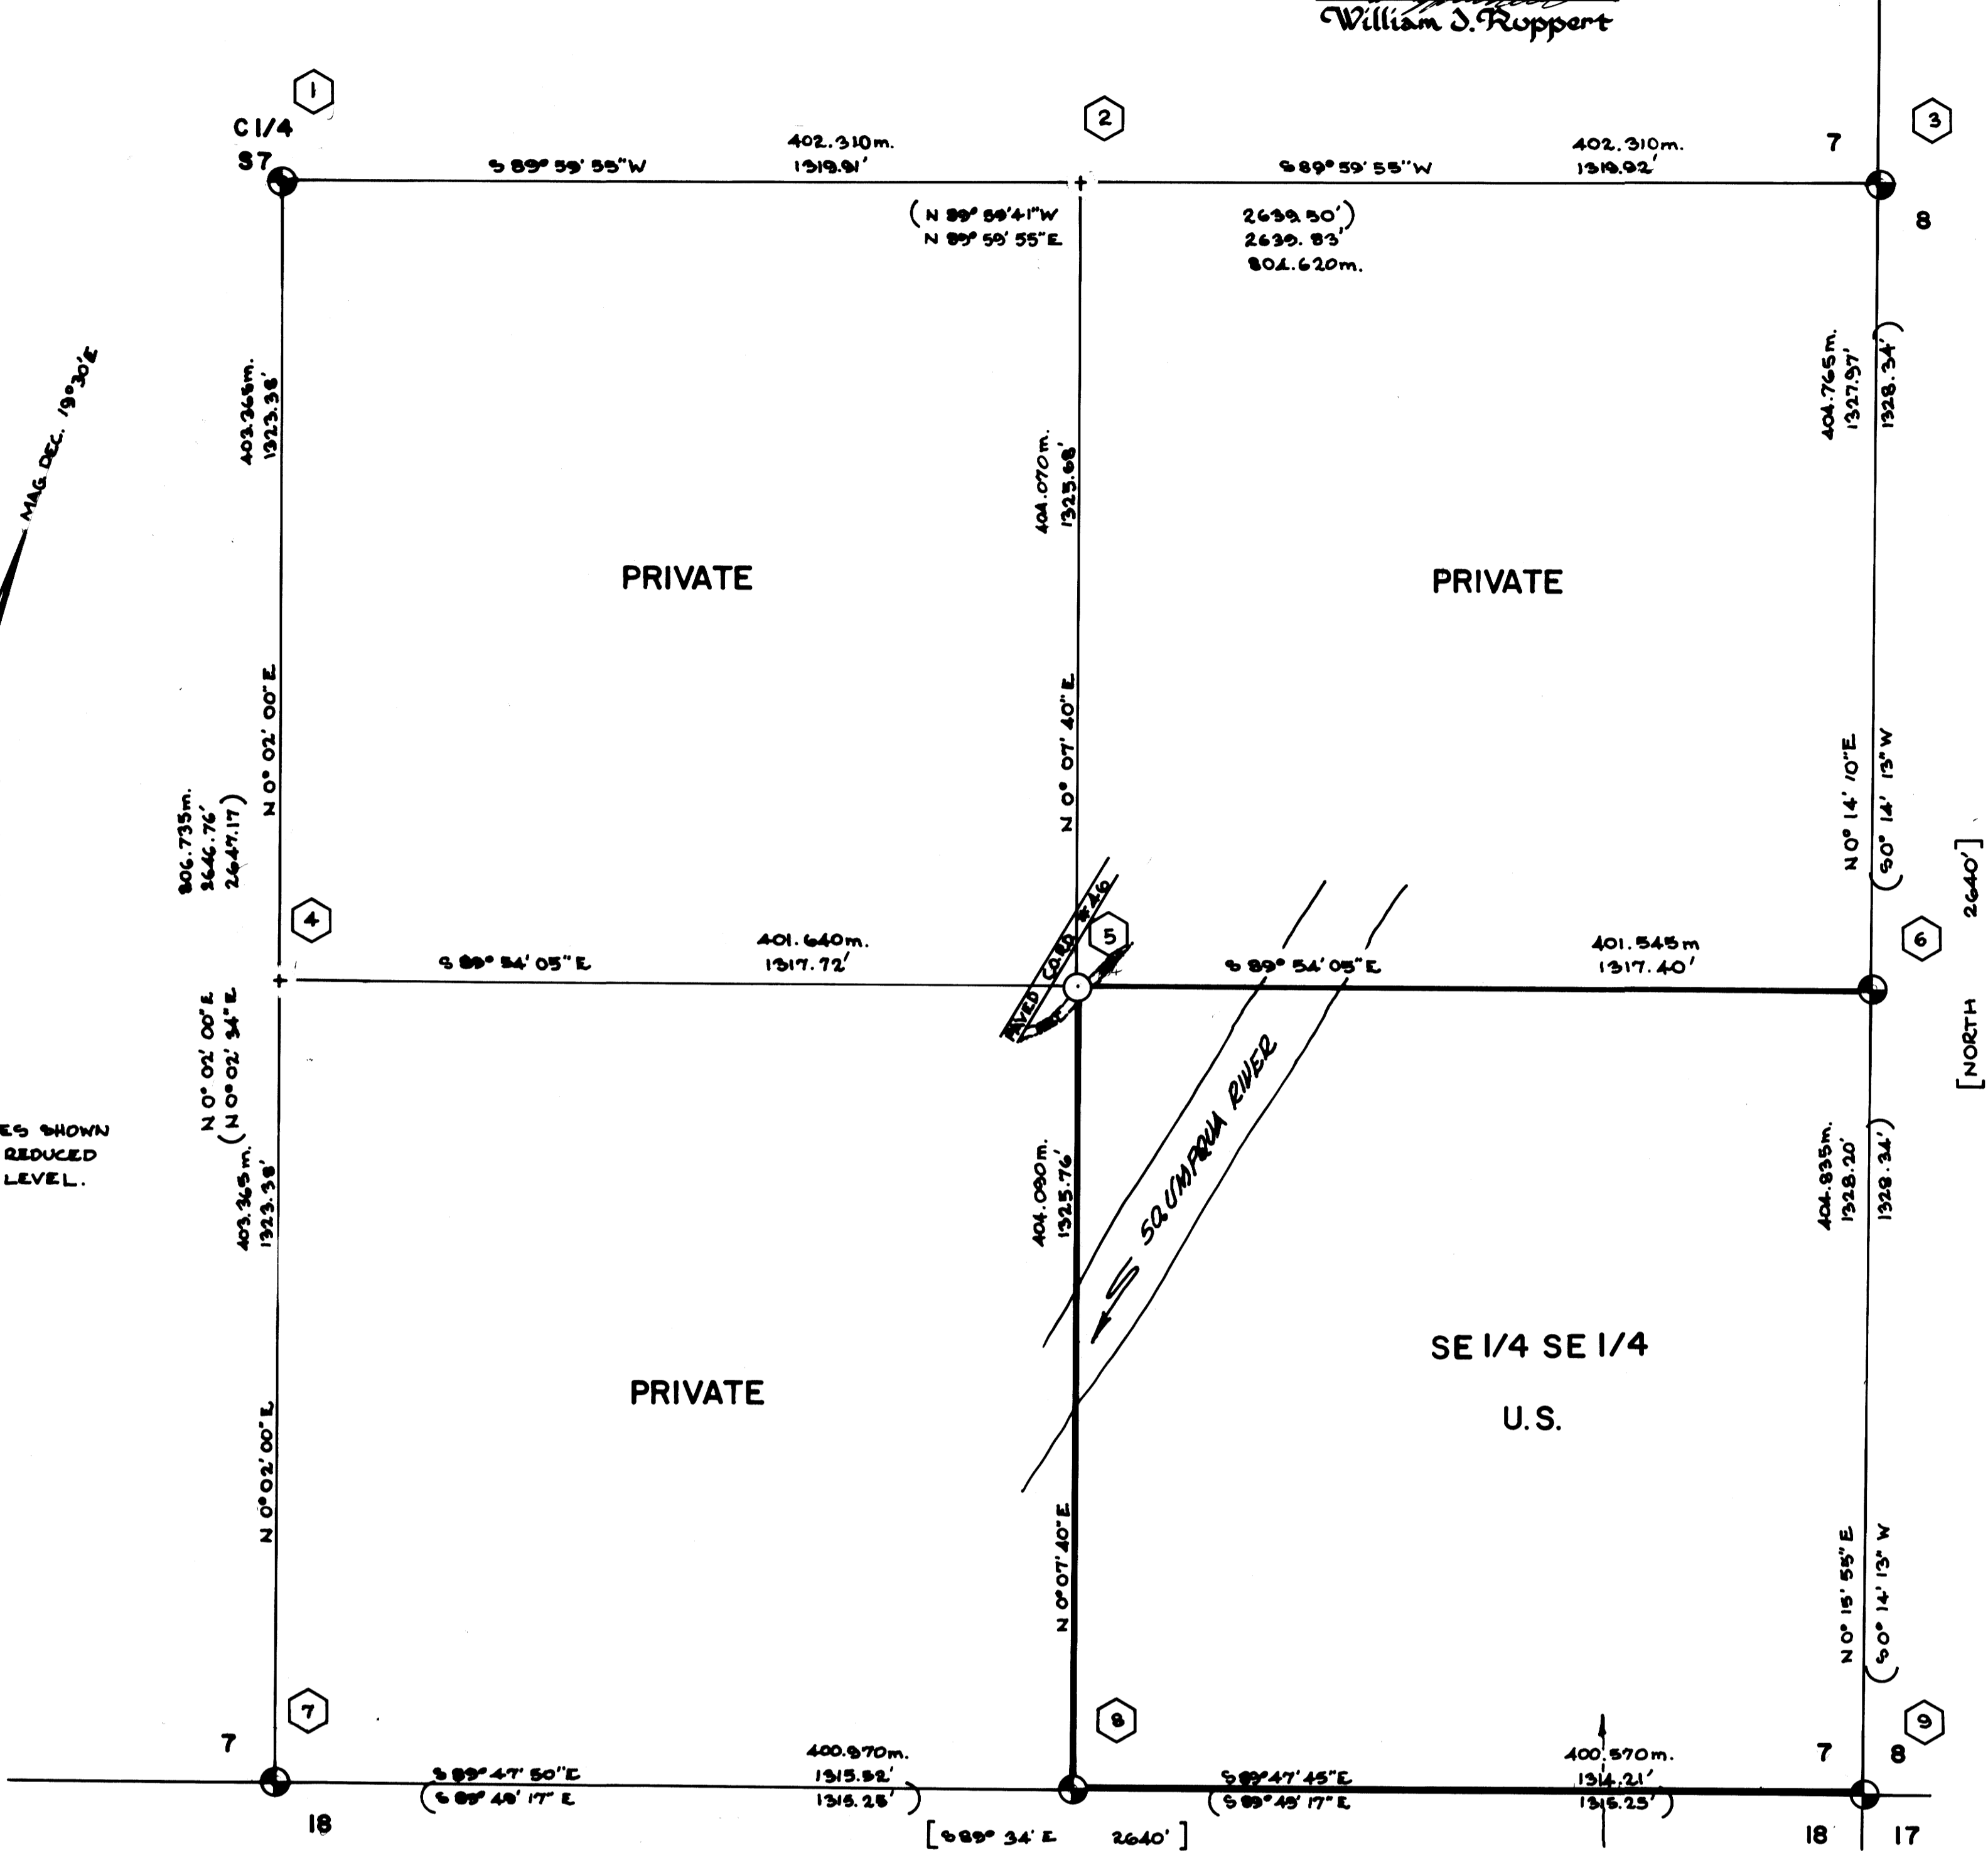


FOUND: 2" IRON PIPE WITH 3" BRASS CAP  
14" CEDAR S 1°30' E 75.6 FT "C 1/4 57 BT"  
8" OAK N 78°15' W 32.5 FT "C 1/4 57 BT"  
BRASS DISC MARKED "L5961" IS ATTACHED TO EACH BT.

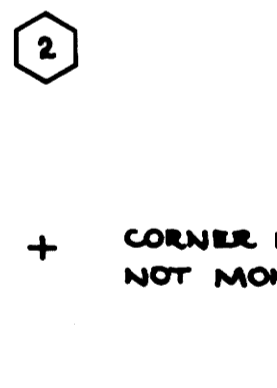


+ CORNER BY SINGLE PROPORTIONATE MEASUREMENT, NOT MONUMENTED.

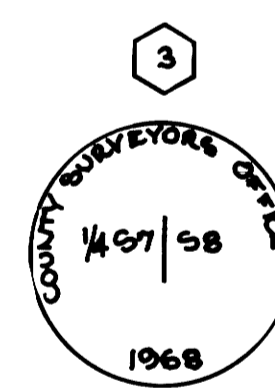


FOUND: 1" IRON PIPE WITH 2 1/2" BRASS CAP  
22" HEMLOCK N 49°00' E 12.9 FT "4" VISIBLE  
30" HEMLOCK S 26°30' E 40.5 FT "1/4 58 C6 BT"  
20" HEMLOCK N 16°45' W 22.0 FT "1/4 57 C6 BT" NOW AN UPROOT

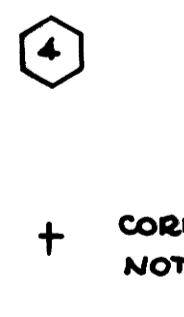


+ CORNER BY SINGLE PROPORTIONATE MEASUREMENT, NOT MONUMENTED.

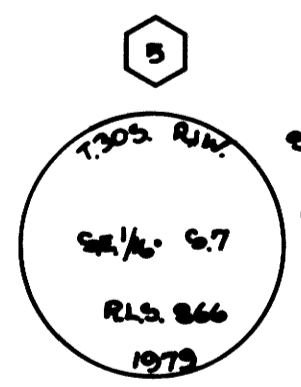


SET: 2x30" GALV. IRON PIPE WITH 3" BRASS CAP  
SCRIBED: 18" CEDAR N 16°45' W 20.0 FT "5 1/2 57 BT"  
7" D. FIR S 80°15' E 48.5 FT "5 1/2 57 BT"

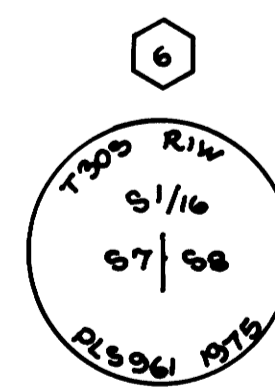


FOUND: 2" IRON PIPE WITH 3" BRASS CAP  
24" PINE N 75°10' W 57.2 FT "5 1/2 57 BT" WITH BRASS DISC MARKED "L5961"  
18" CEDAR S 33°30' E 47.7 FT "5 1/2 58 BT" WITH BRASS DISC MARKED "L5961"

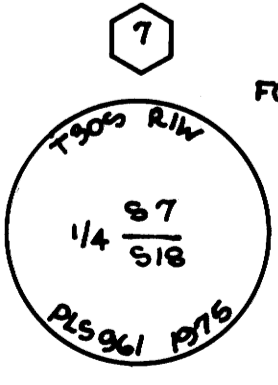

FOUND: 3" BRASS CAP IN CONCRETE ON LARGE BOULDER  
5" W. OAK N 1°30' E 21.5 FT "1/4 57 BT"  
5" W. OAK S 44°45' W 9.2 FT "1/4 58 BT"

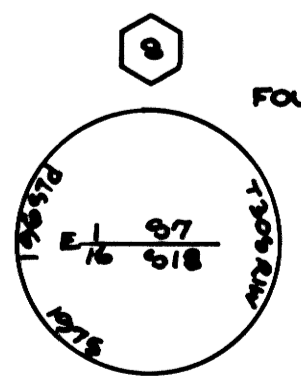

FOUND: 2" IRON PIPE WITH 3" BRASS CAP  
8" HEMLOCK S 76°15' E 13.0 FT "E 1/2 58 BT" WITH BRASS DISC MARKED "L5961"  
19" D. FIR N 25°15' W 27.3 FT "E 1/2 57 BT" WITH BRASS DISC MARKED "L5961"

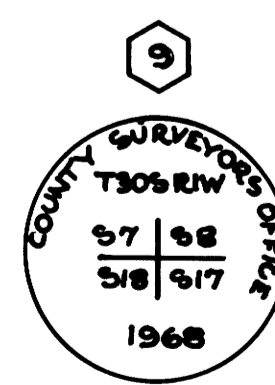

FOUND: 1" IRON PIPE WITH 2 1/2" BRASS CAP  
20" D. FIR N 18°30' E 23.1 FT GOOD SCAR  
15" D. FIR S 22°30' E 21.6 FT GOOD SCAR  
21" D. FIR N 89°45' W 14.9 FT GOOD SCAR  
21" D. FIR S 43°30' W 15.5 FT GOOD SCAR  
SCRIBED NEW BT.  
9" D. FIR S 74°00' E 59.2 FT "T306 RIW 517 BT"

Note: Corners are monumented by this survey with 2x30" galv iron pipe with 2 1/2" brass cap.  
All bearing tree dimension indicate the diameter of the tree at chest height.  
All bearing tree distances and bearings are from the center of the monument to the center of the tree.  
Bearing trees scribbled during this survey have a brass disc stamped "L5 866" nailed to the lower blaze.

CONTRACT 53-04HI-9-7198 TILLER 33  
FIELD BOOK SECTION 7

REGISTERED OREGON LAND SURVEYOR  
WILLIAM J. RUPPERT  
866

MAP FILE M79-5024

MAP FILE M79-5024