


MAP FILE M.70-75
 COUNTY SURVEYORS FILE DATA
 DO NOT REMOVE FROM OFFICE

SURVEY TO SET INTERIOR CORNERS
 SITUATED IN SEC. 30, T.29S. R.3W. W.M.
 FOR - SUN STUDS INC.
 BY - BURTON W. HOLT
 SCALE 1" = 200'

FILED
 RECEIVED JWH
 JUL 16 1979
 COUNTY SURVEYOR
 DOUGLAS COUNTY, ORE.
 JB

JULY 1979

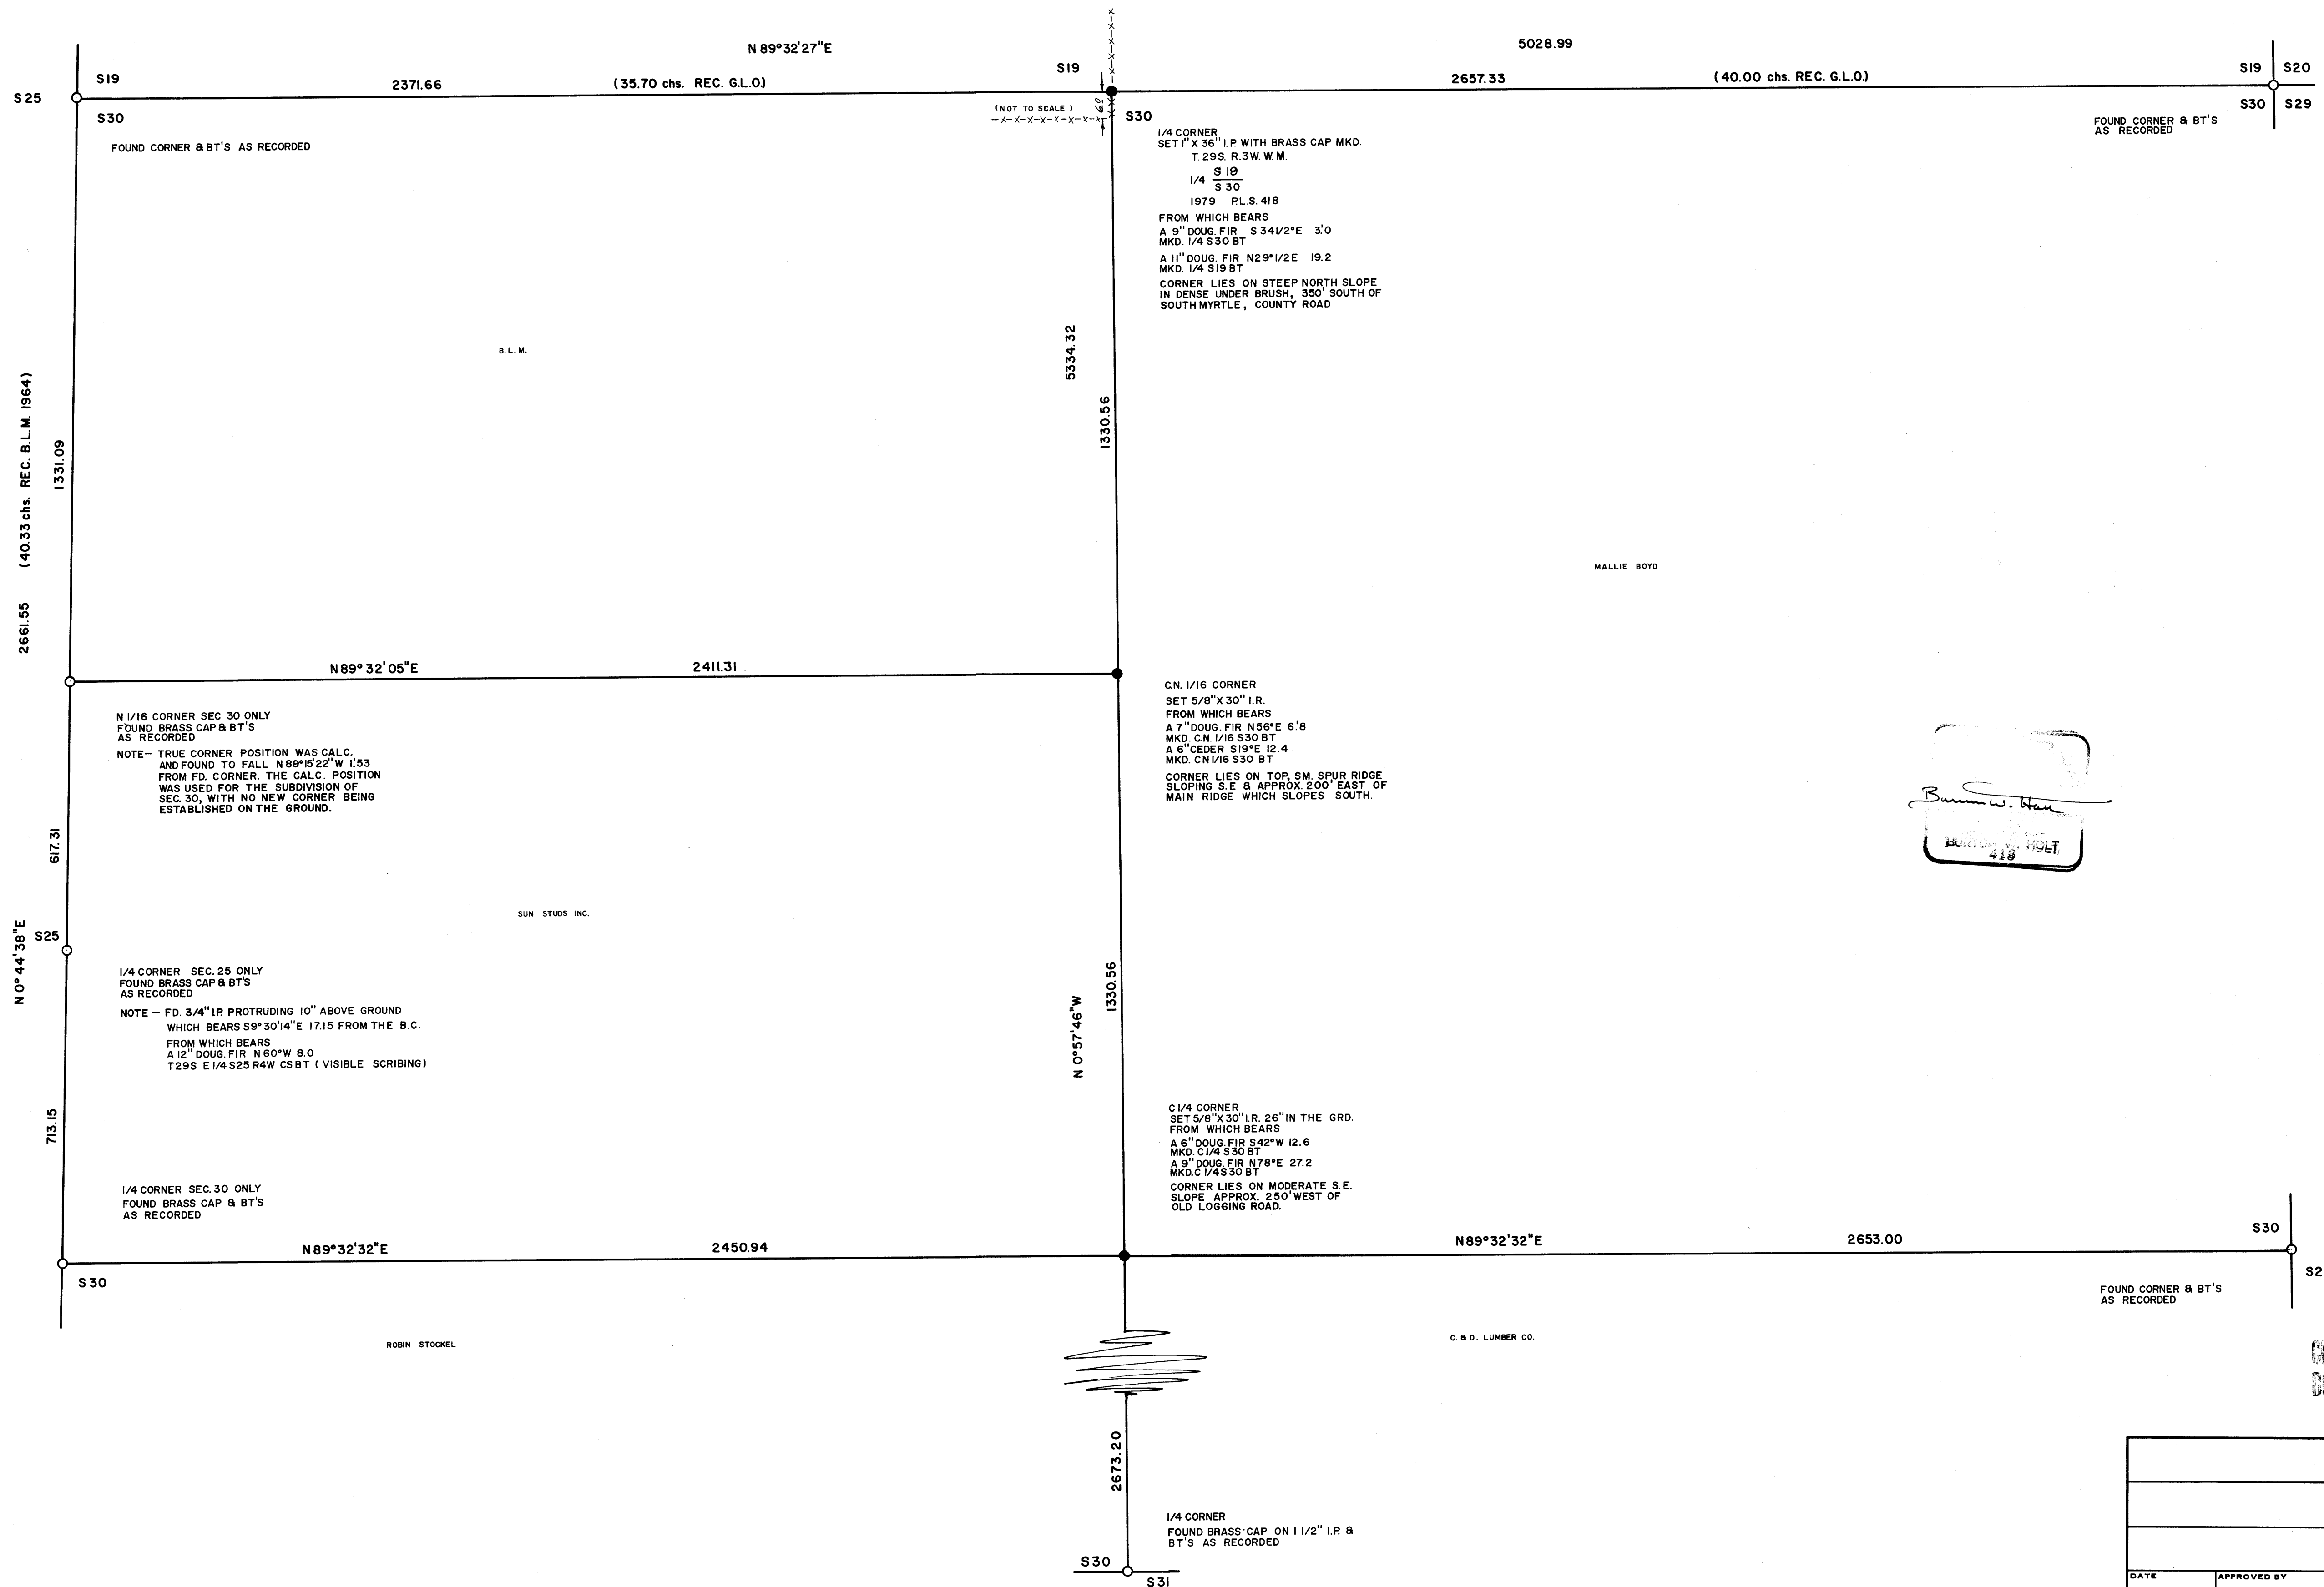

Burton W. Holt
 BURTON W. HOLT
 418

COUNTY SURVEYORS FILE DATA
 DO NOT REMOVE FROM OFFICE

DATE		APPROVED BY		DRAWING NUMBER	
				BMH 7202	
SCALE		DRAWN BY		REVISED	