


FILED  
RECEIVED  
MAY 30 1978  
COUNTY SURVEYOR  
DOUGLAS COUNTY, ORE.

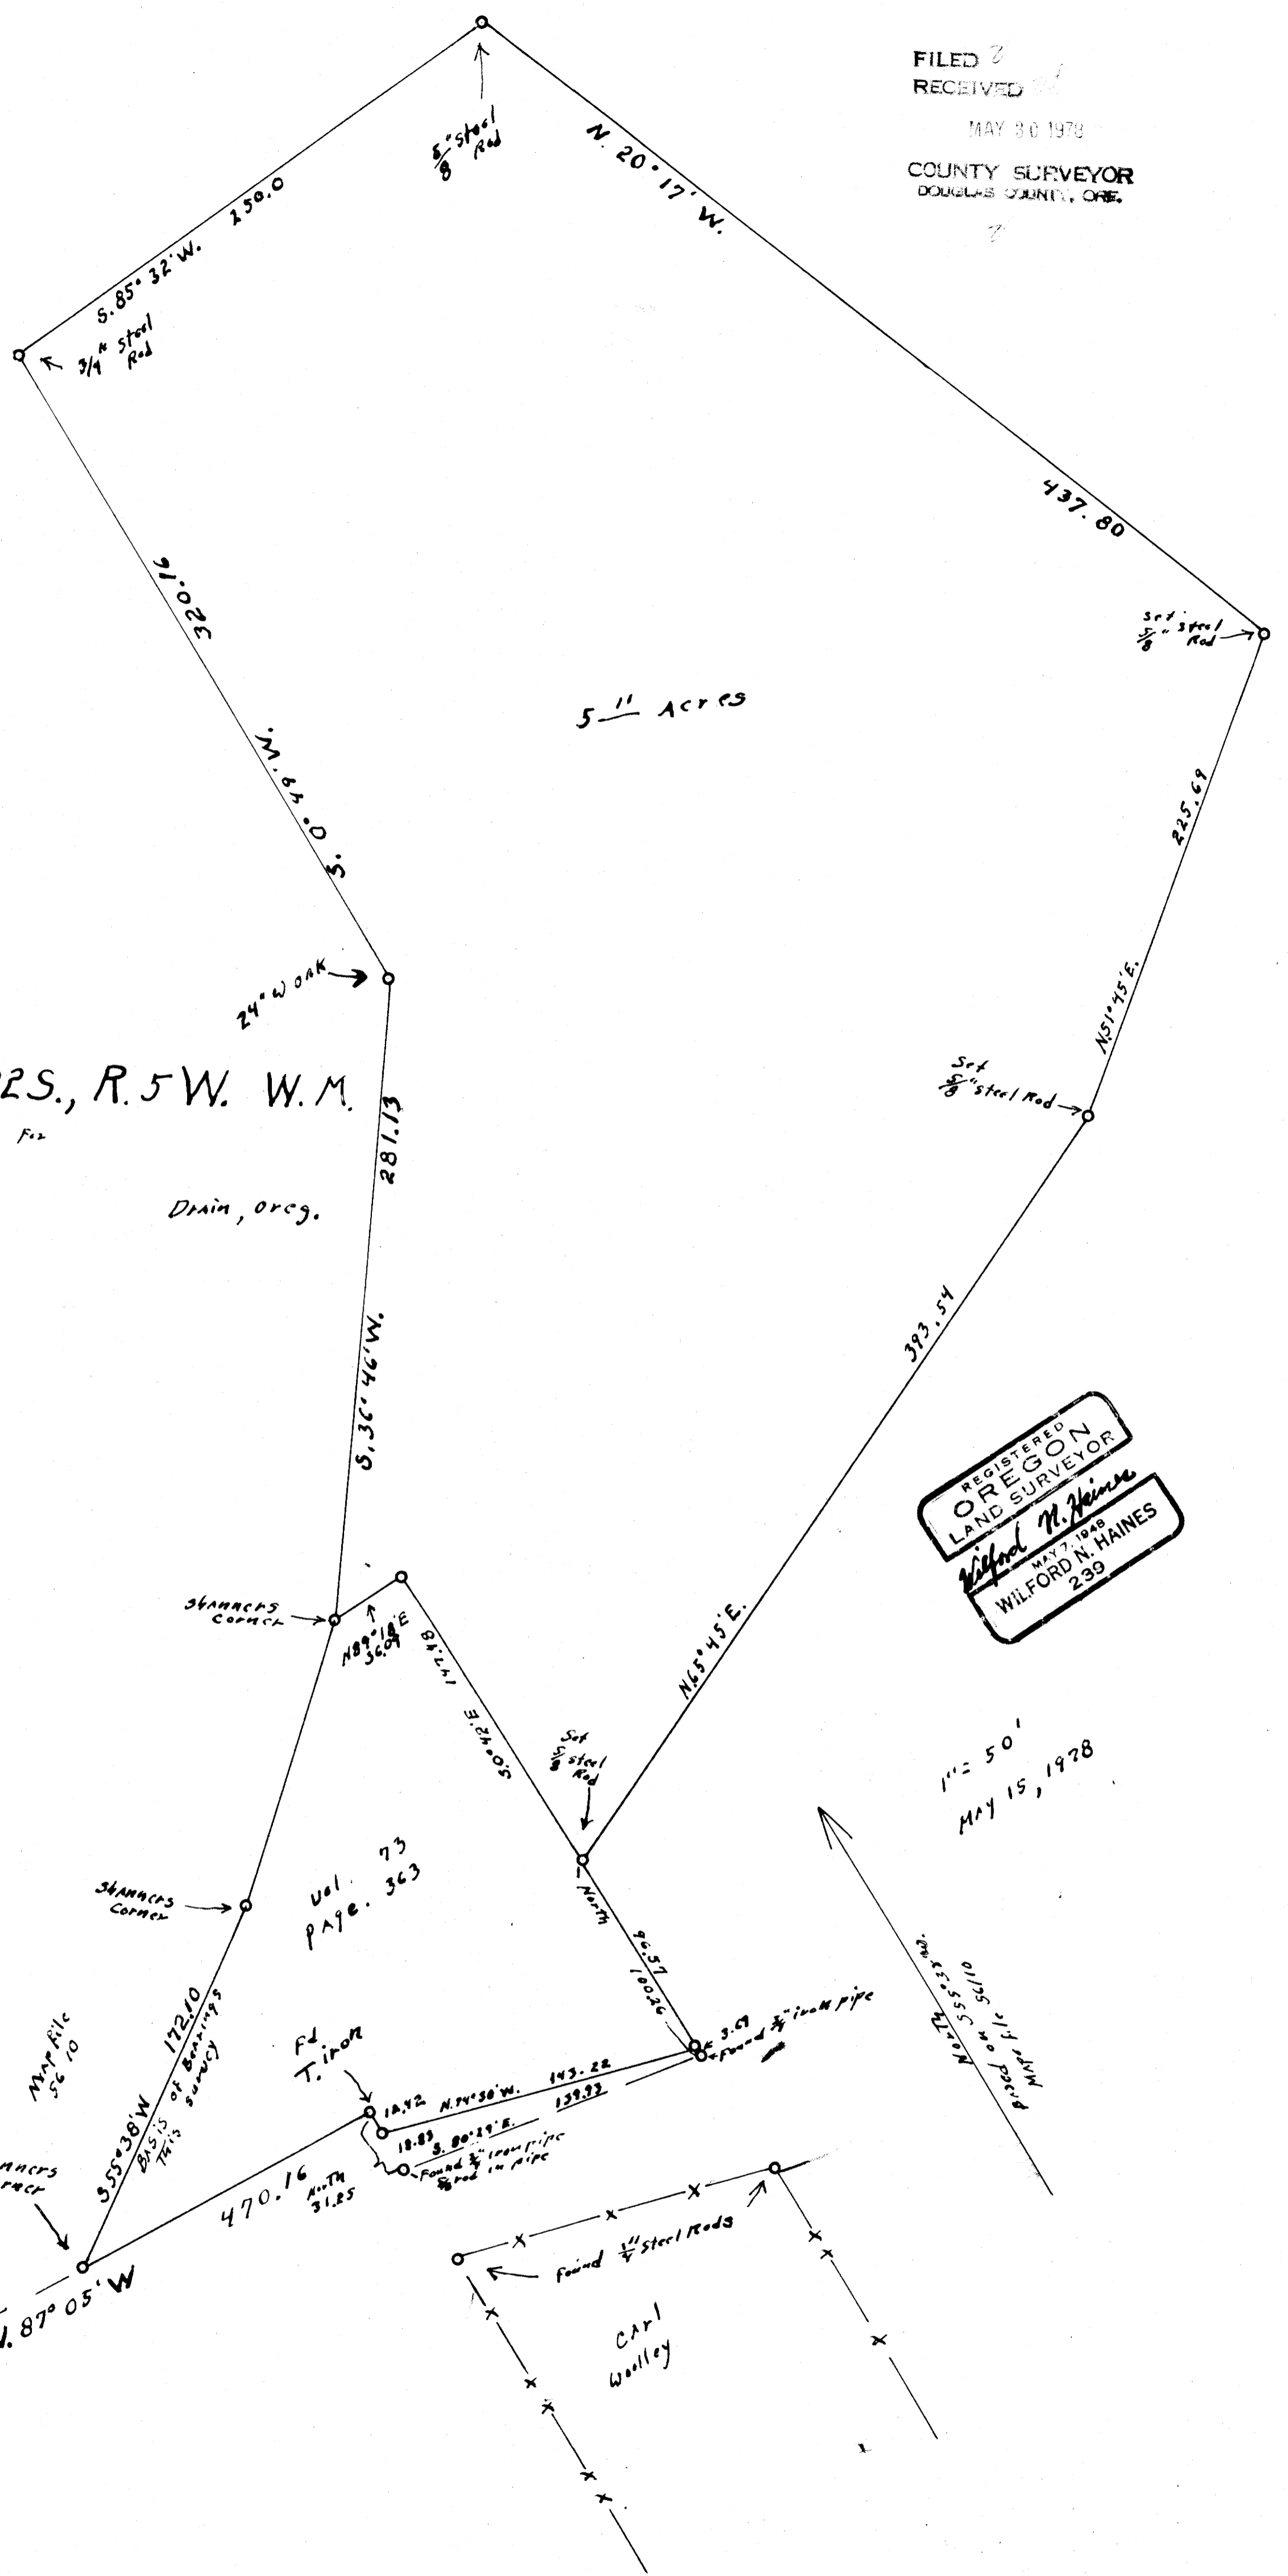

SECT. 16, T. 22 S., R. 5 W. W.M.

"Bill" Duncan

DRAIN, ORCG.

REGISTERED  
OREGON  
LAND SURVEYOR  
Michael N. Haines  
MAY 7 1968  
WILFORD N. HAINES  
239

1" = 50'  
MAY 15, 1978

89  
17 16

N. 2° 40' 43.3" E.  
1284.0

N. 87° 05' W.  
470.16  
N. 74° 38' W.  
172.10  
BASIS of Bearings THIS SURVEY

10.72 N. 74° 38' W. 143.22  
18.89 S. 80° 19' E. 139.92  
Found 1/2" iron pipe & rod in pipe

