

DO NOT REMOVE THIS DATA

FILED  
RECEIVED

MAY 30 1978

COUNTY SURVEYOR  
DOUGLAS COUNTY, ORE.

# T.22S., R.5 W. W.M. SECTS. 24 + 25


For

EXACON  
Box 64, Eugene oreg 97401

phone 345-6052

scale 8" = 1 mile

MAY 2, 1978

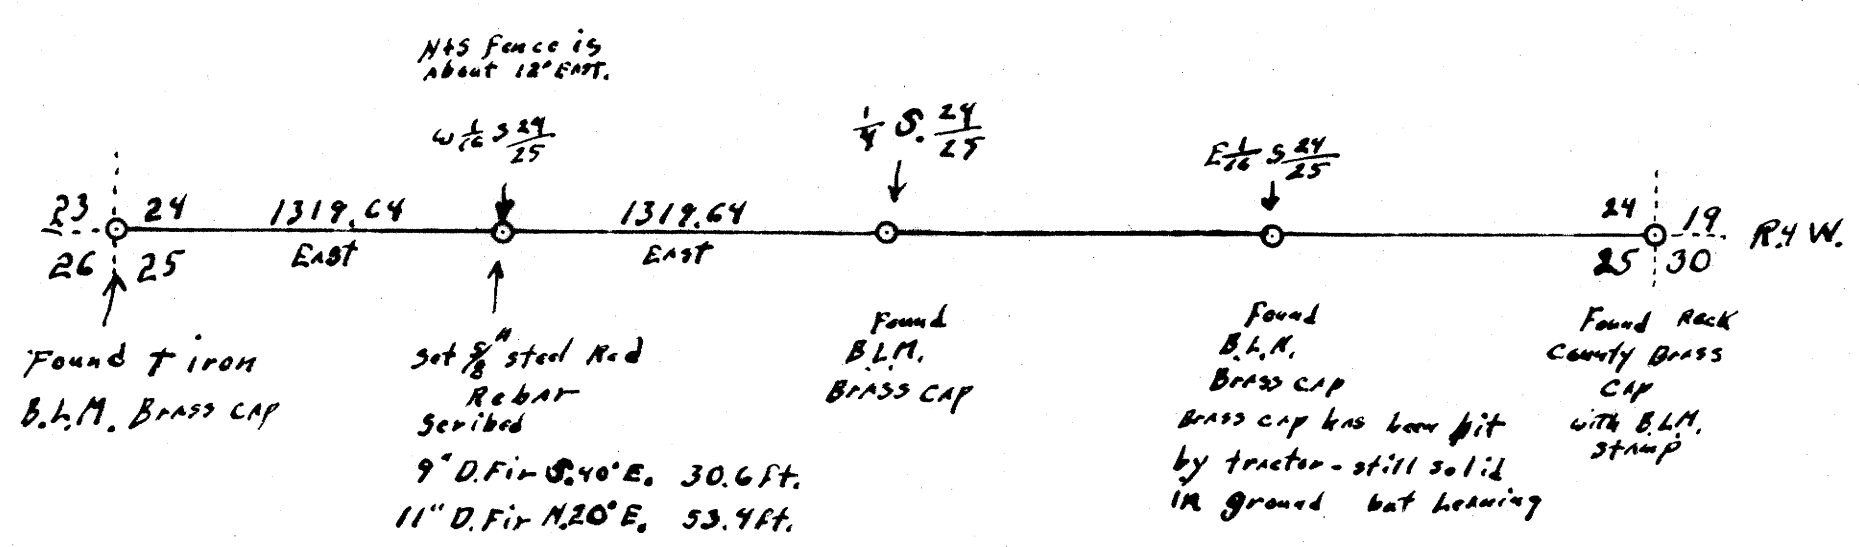

REGISTERED  
OREGON  
LAND SURVEYOR

*Wilford N. Haines*

MAY 7, 1948  
WILFORD N. HAINES  
239