
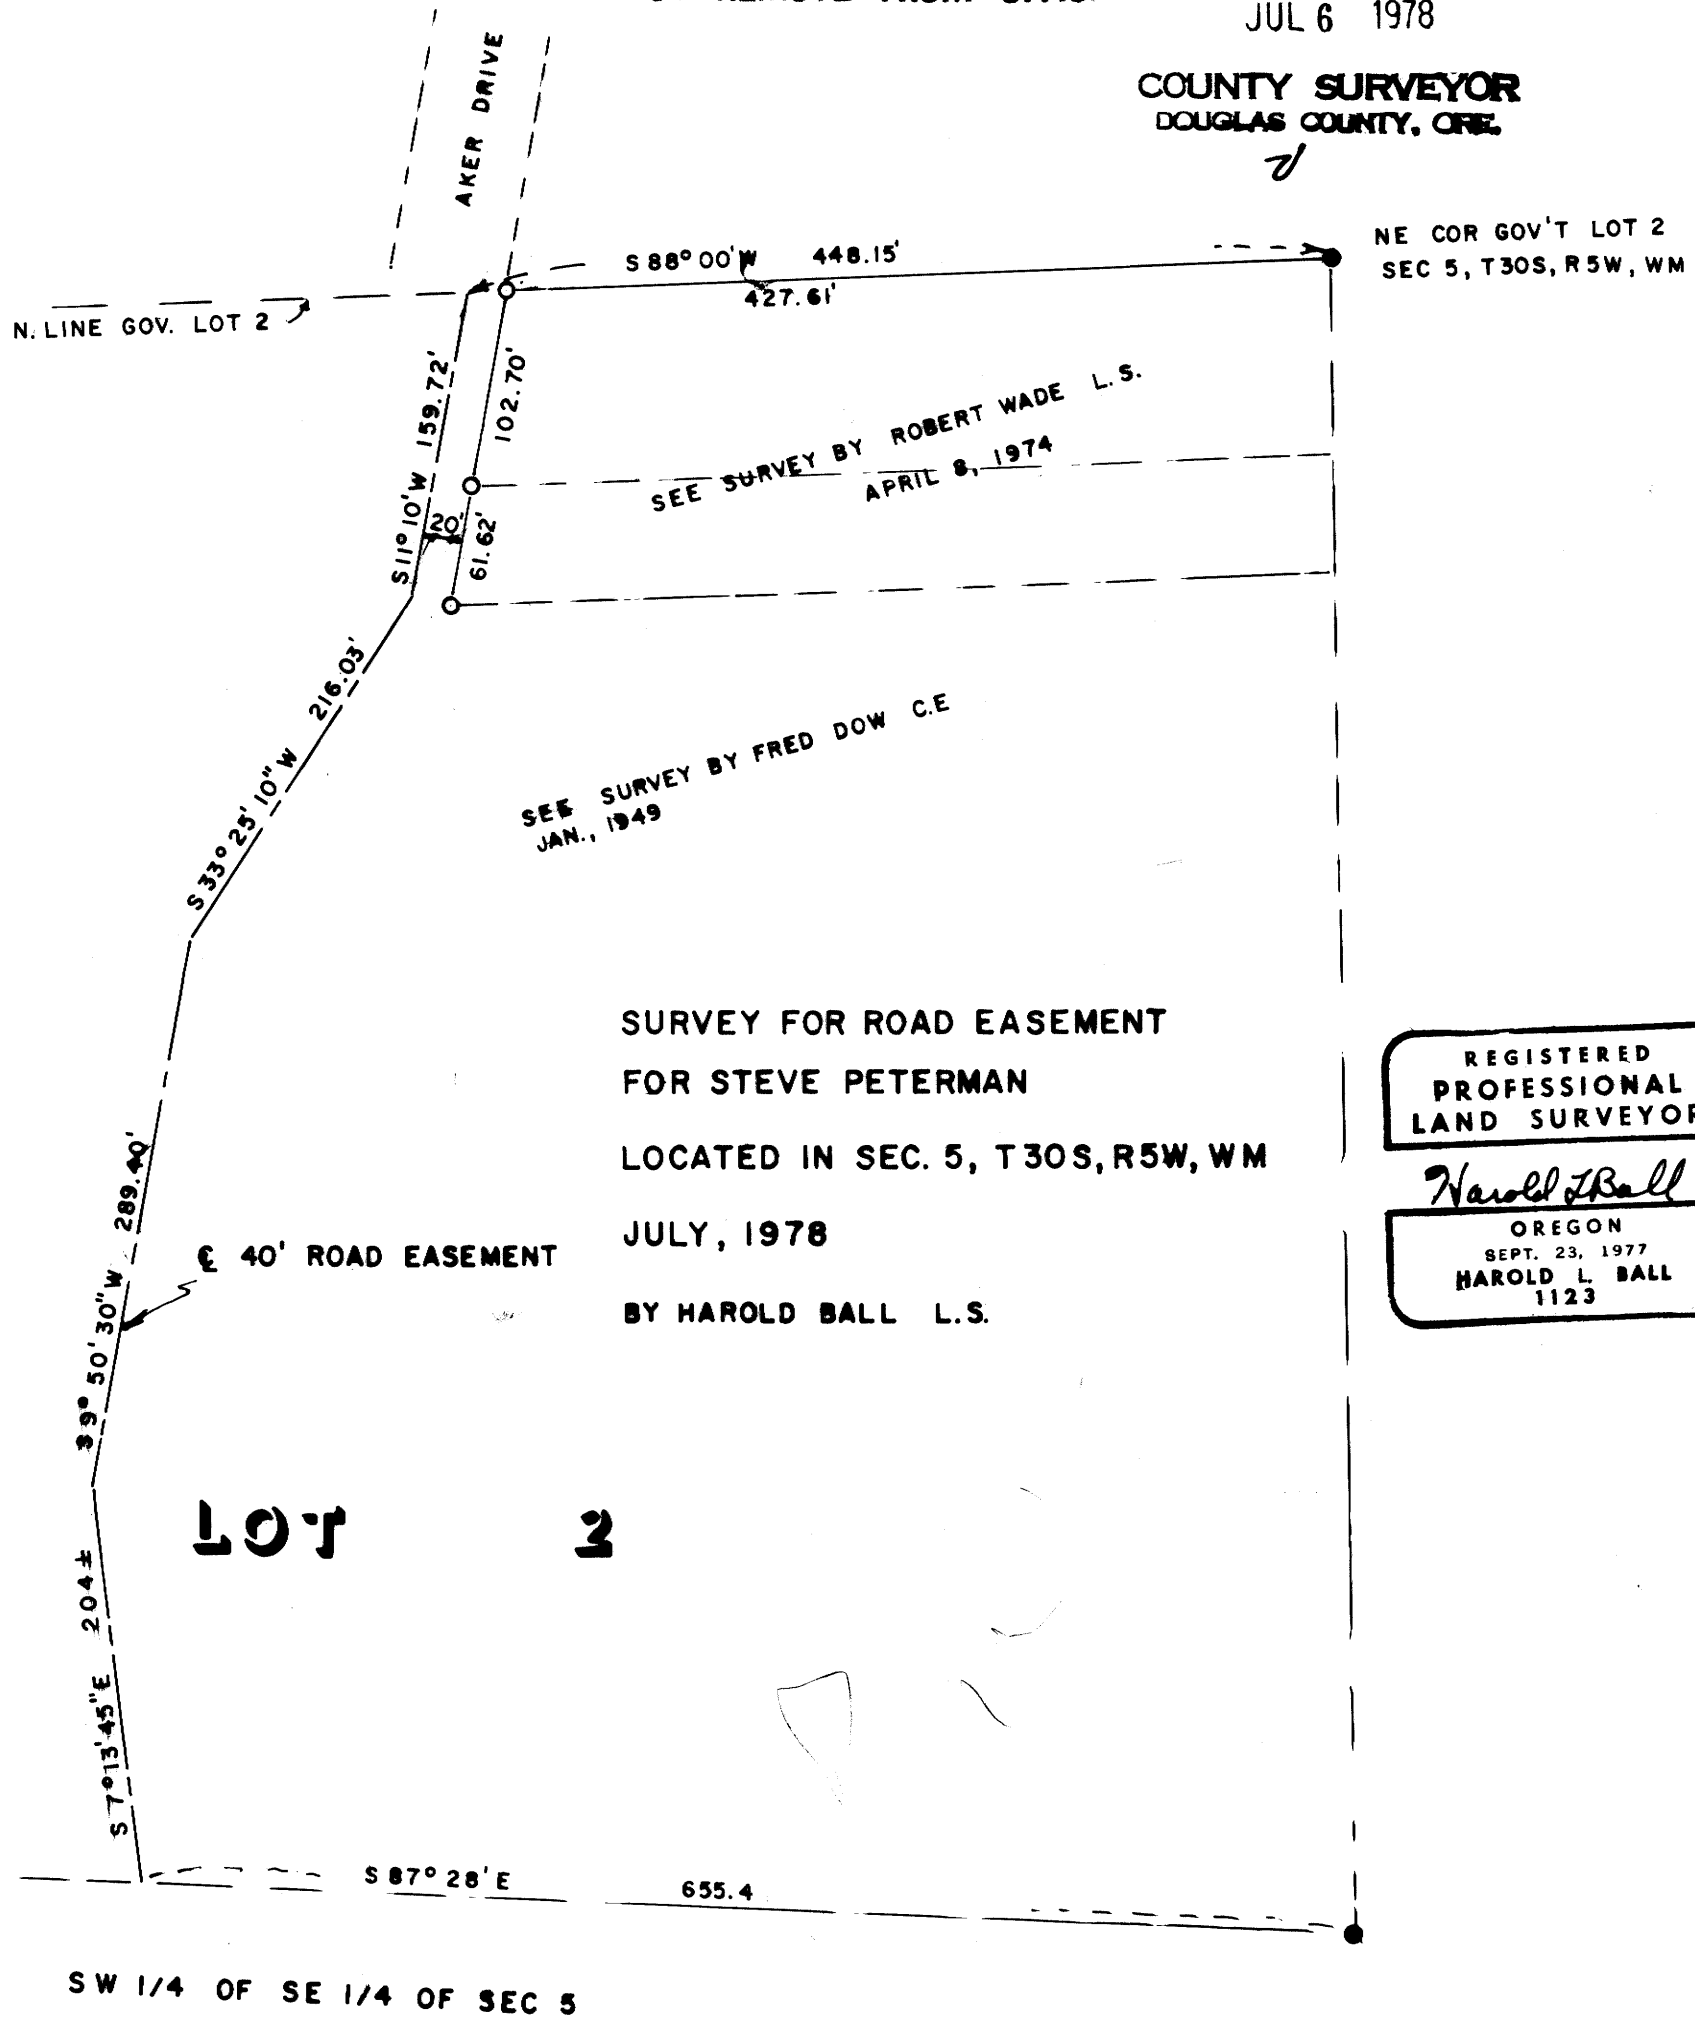


COUNTY SURVEYORS FILE DATA
DO NOT REMOVE FROM OFFICE

FILED
RECEIVED

JUL 6 1978

COUNTY SURVEYOR
DOUGLAS COUNTY, ORE.

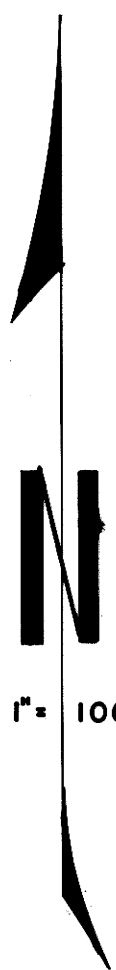

- FD 3/4" I. PIPE
- FD 1/2" I. PIPE

REGISTERED
PROFESSIONAL
LAND SURVEYOR

Harold L. Ball

OREGON
SEPT. 23, 1977
HAROLD L. BALL
1123