

COUNTY SURVEYORS FILE DATA
DO NOT REMOVE FROM OFFICE

SURVEY FOR ALLAN KUSLER



FILED 8
RECEIVED (w)

IN LOT 7
DEERFIELD SUBDIVISION

JUN 19 1978

SECTION 5 T30S R.5W W.M. DOUGLAS COUNTY, ORE.

73

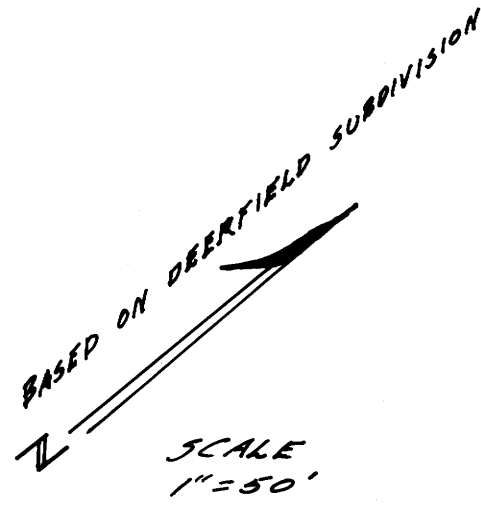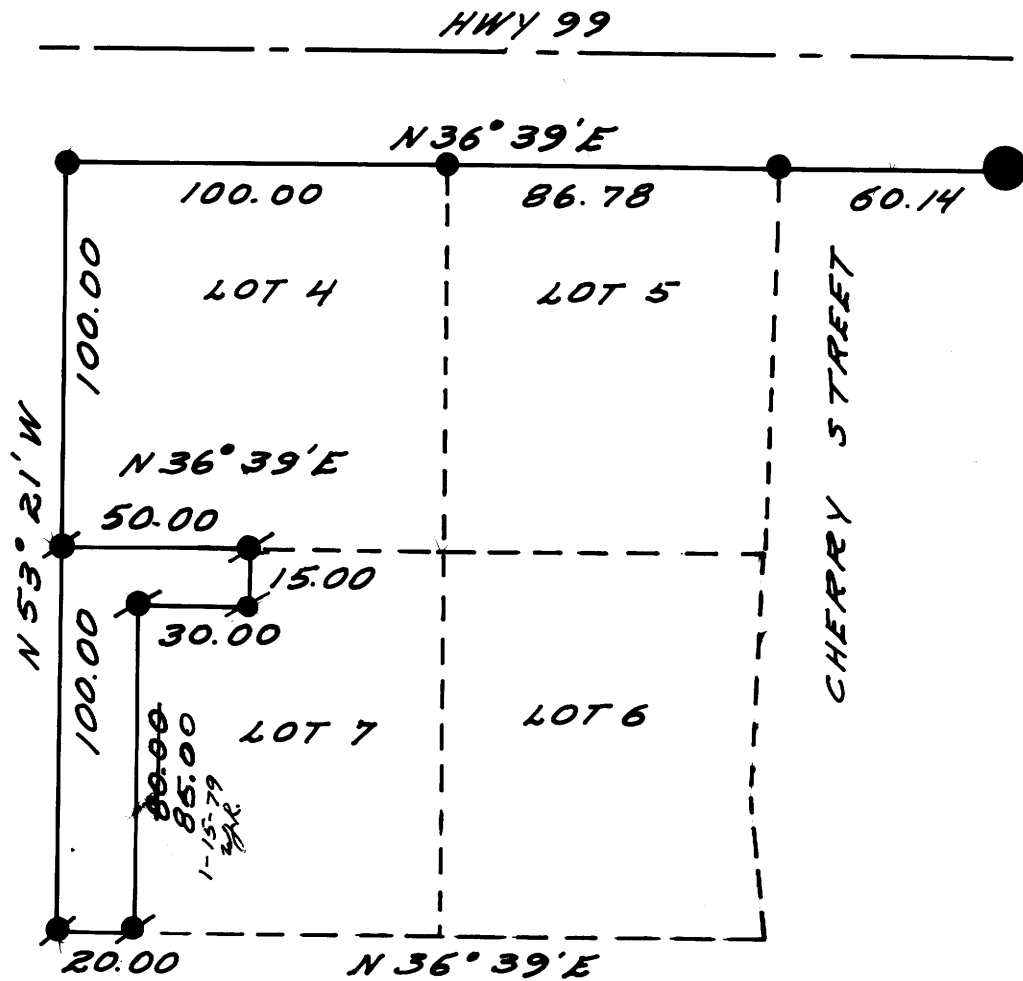

- LEGEND
- FOUND 1/2" IRON PIPE
 - FOUND 1" IRON PIPE
 - ✕ SET 1/2" IRON ROD

UMPQUA SURVEYING CO.
MYRTLE CREEK OR.
JUNE 1978

REGISTERED
DEEDS
CLERK
William J. ...