

# CORNER RESTORATION SURVEY


COUNTY SURVEYORS FILE DATA  
DO NOT REMOVE FROM OFFICE

FOR CHUCK JONES  
IN THE PERKINS TRACTS  
LAZARUS WRIGHT DLC # 45  
SEC. 27, T29S, R5W, W.M.  
CITY OF MYRTLE CREEK  
DOUGLAS COUNTY, OREGON  
BY ALPHA & OMEGA ENGINEERS  
JULY 20, 1978 SCALE: 1"=50'

FILED *JHH*  
RECEIVED

AUG 7 1978

COUNTY SURVEYOR  
DOUGLAS COUNTY, ORE.

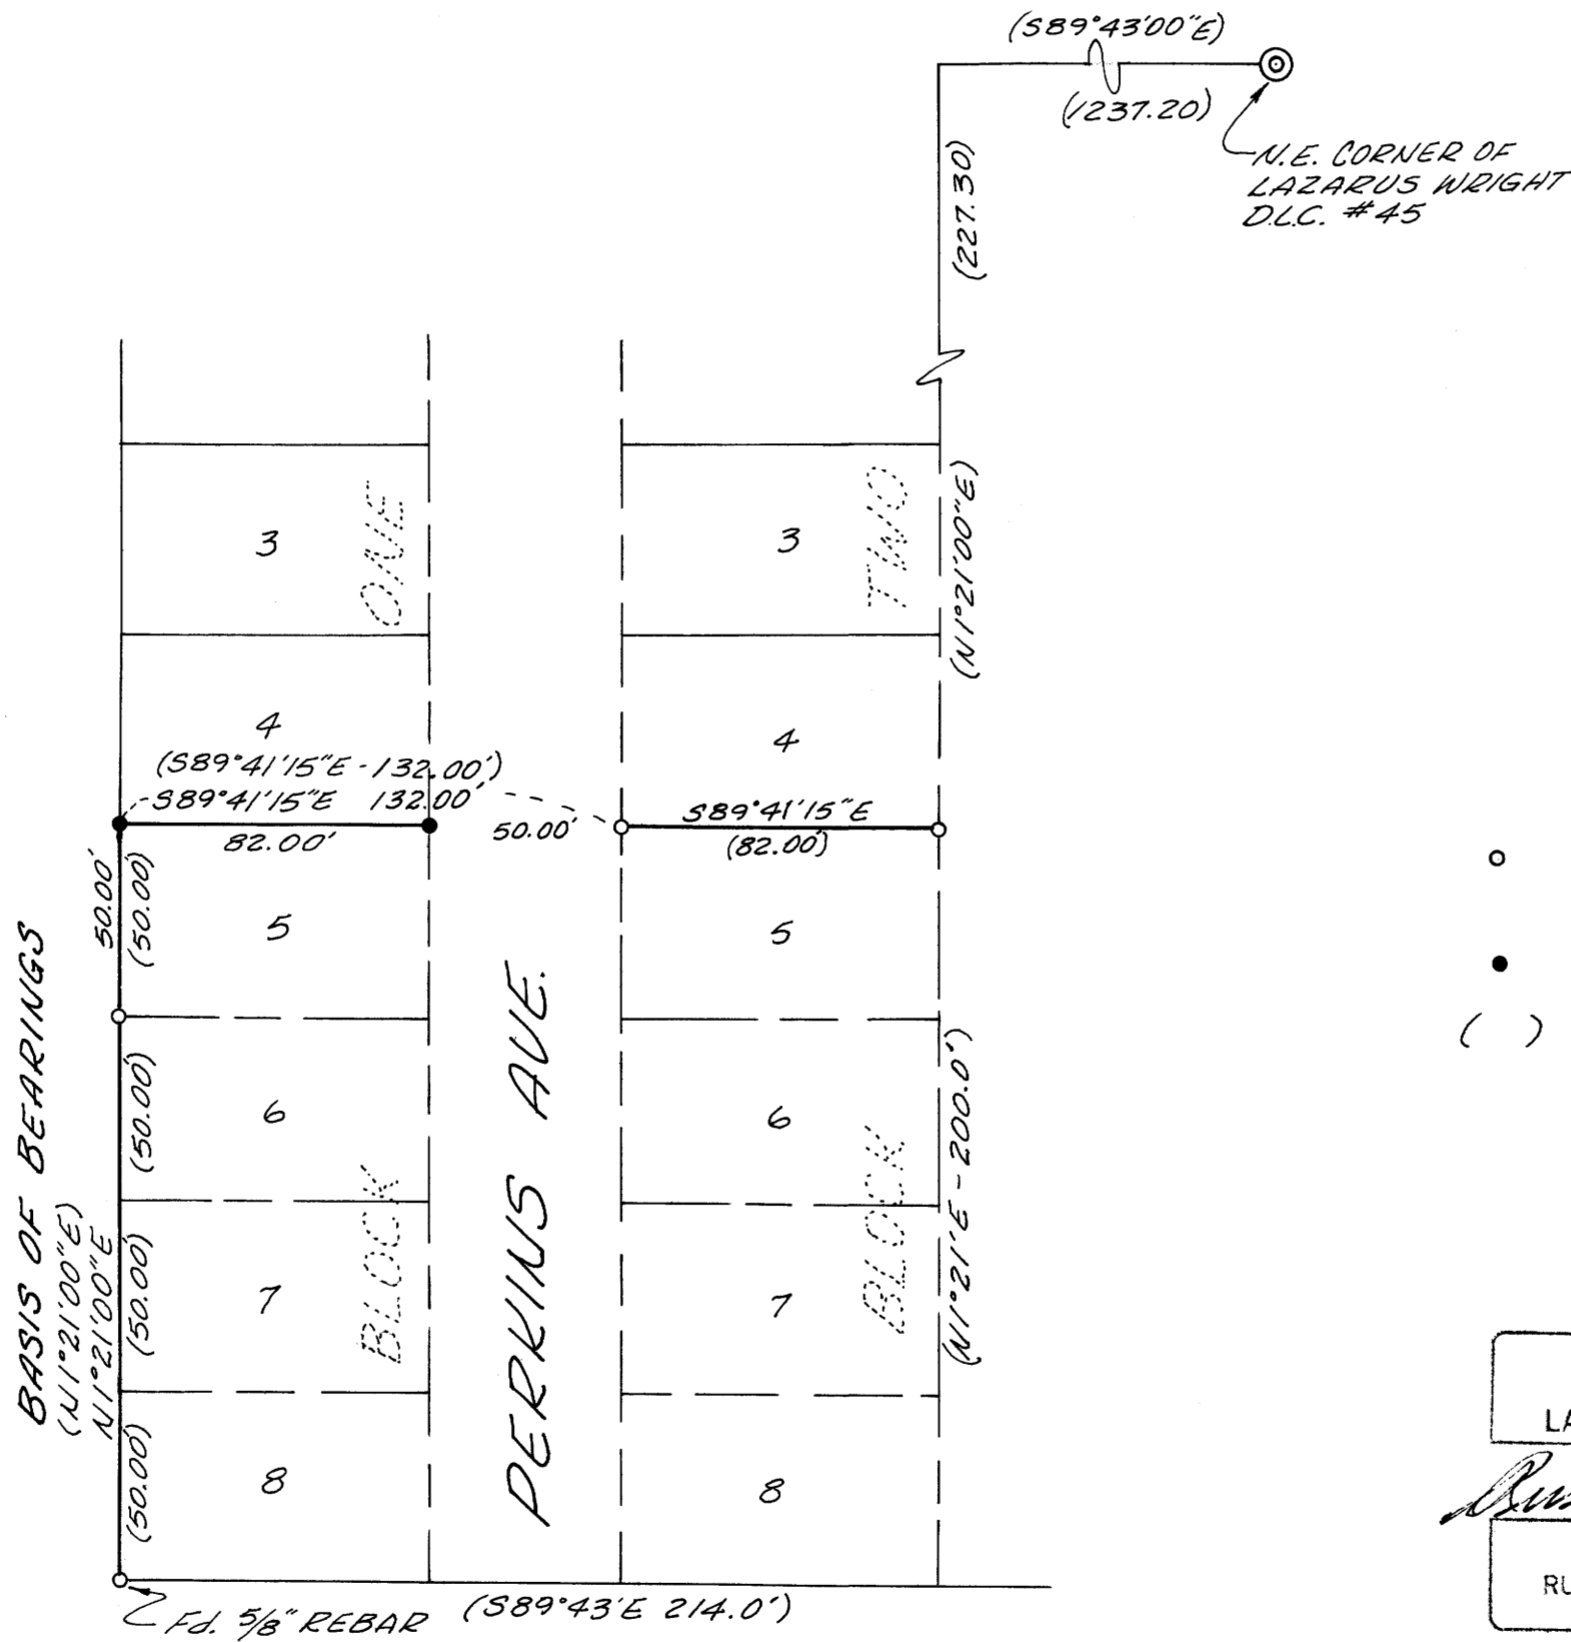

## LEGEND:

- FOUND 1/2" IRON PIPE OR AS INDICATED
- SET 5/8" X 30" REBAR
- ( ) RECORD DATA

REGISTERED  
PROFESSIONAL  
LAND SURVEYOR

*Russell T. Pinard*

OREGON  
JULY 16, 1971  
RUSSELL T. PINARD  
958

8-3-78