


FILED
RECEIVED

AUG 16 1978

COUNTY SURVEYOR
DOUGLAS COUNTY, ORE.
J (TB)

COUNTY SURVEYORS FILE DATA
DO NOT REMOVE FROM OFFICE

SURVEY FOR DEED DESCRIPTION
IN SECTION 18, T. 29S., R. 4W. W.M.
FOR HARMON WALKER
by BRUCE ROGERS
AUG., 1973
1" = 100'

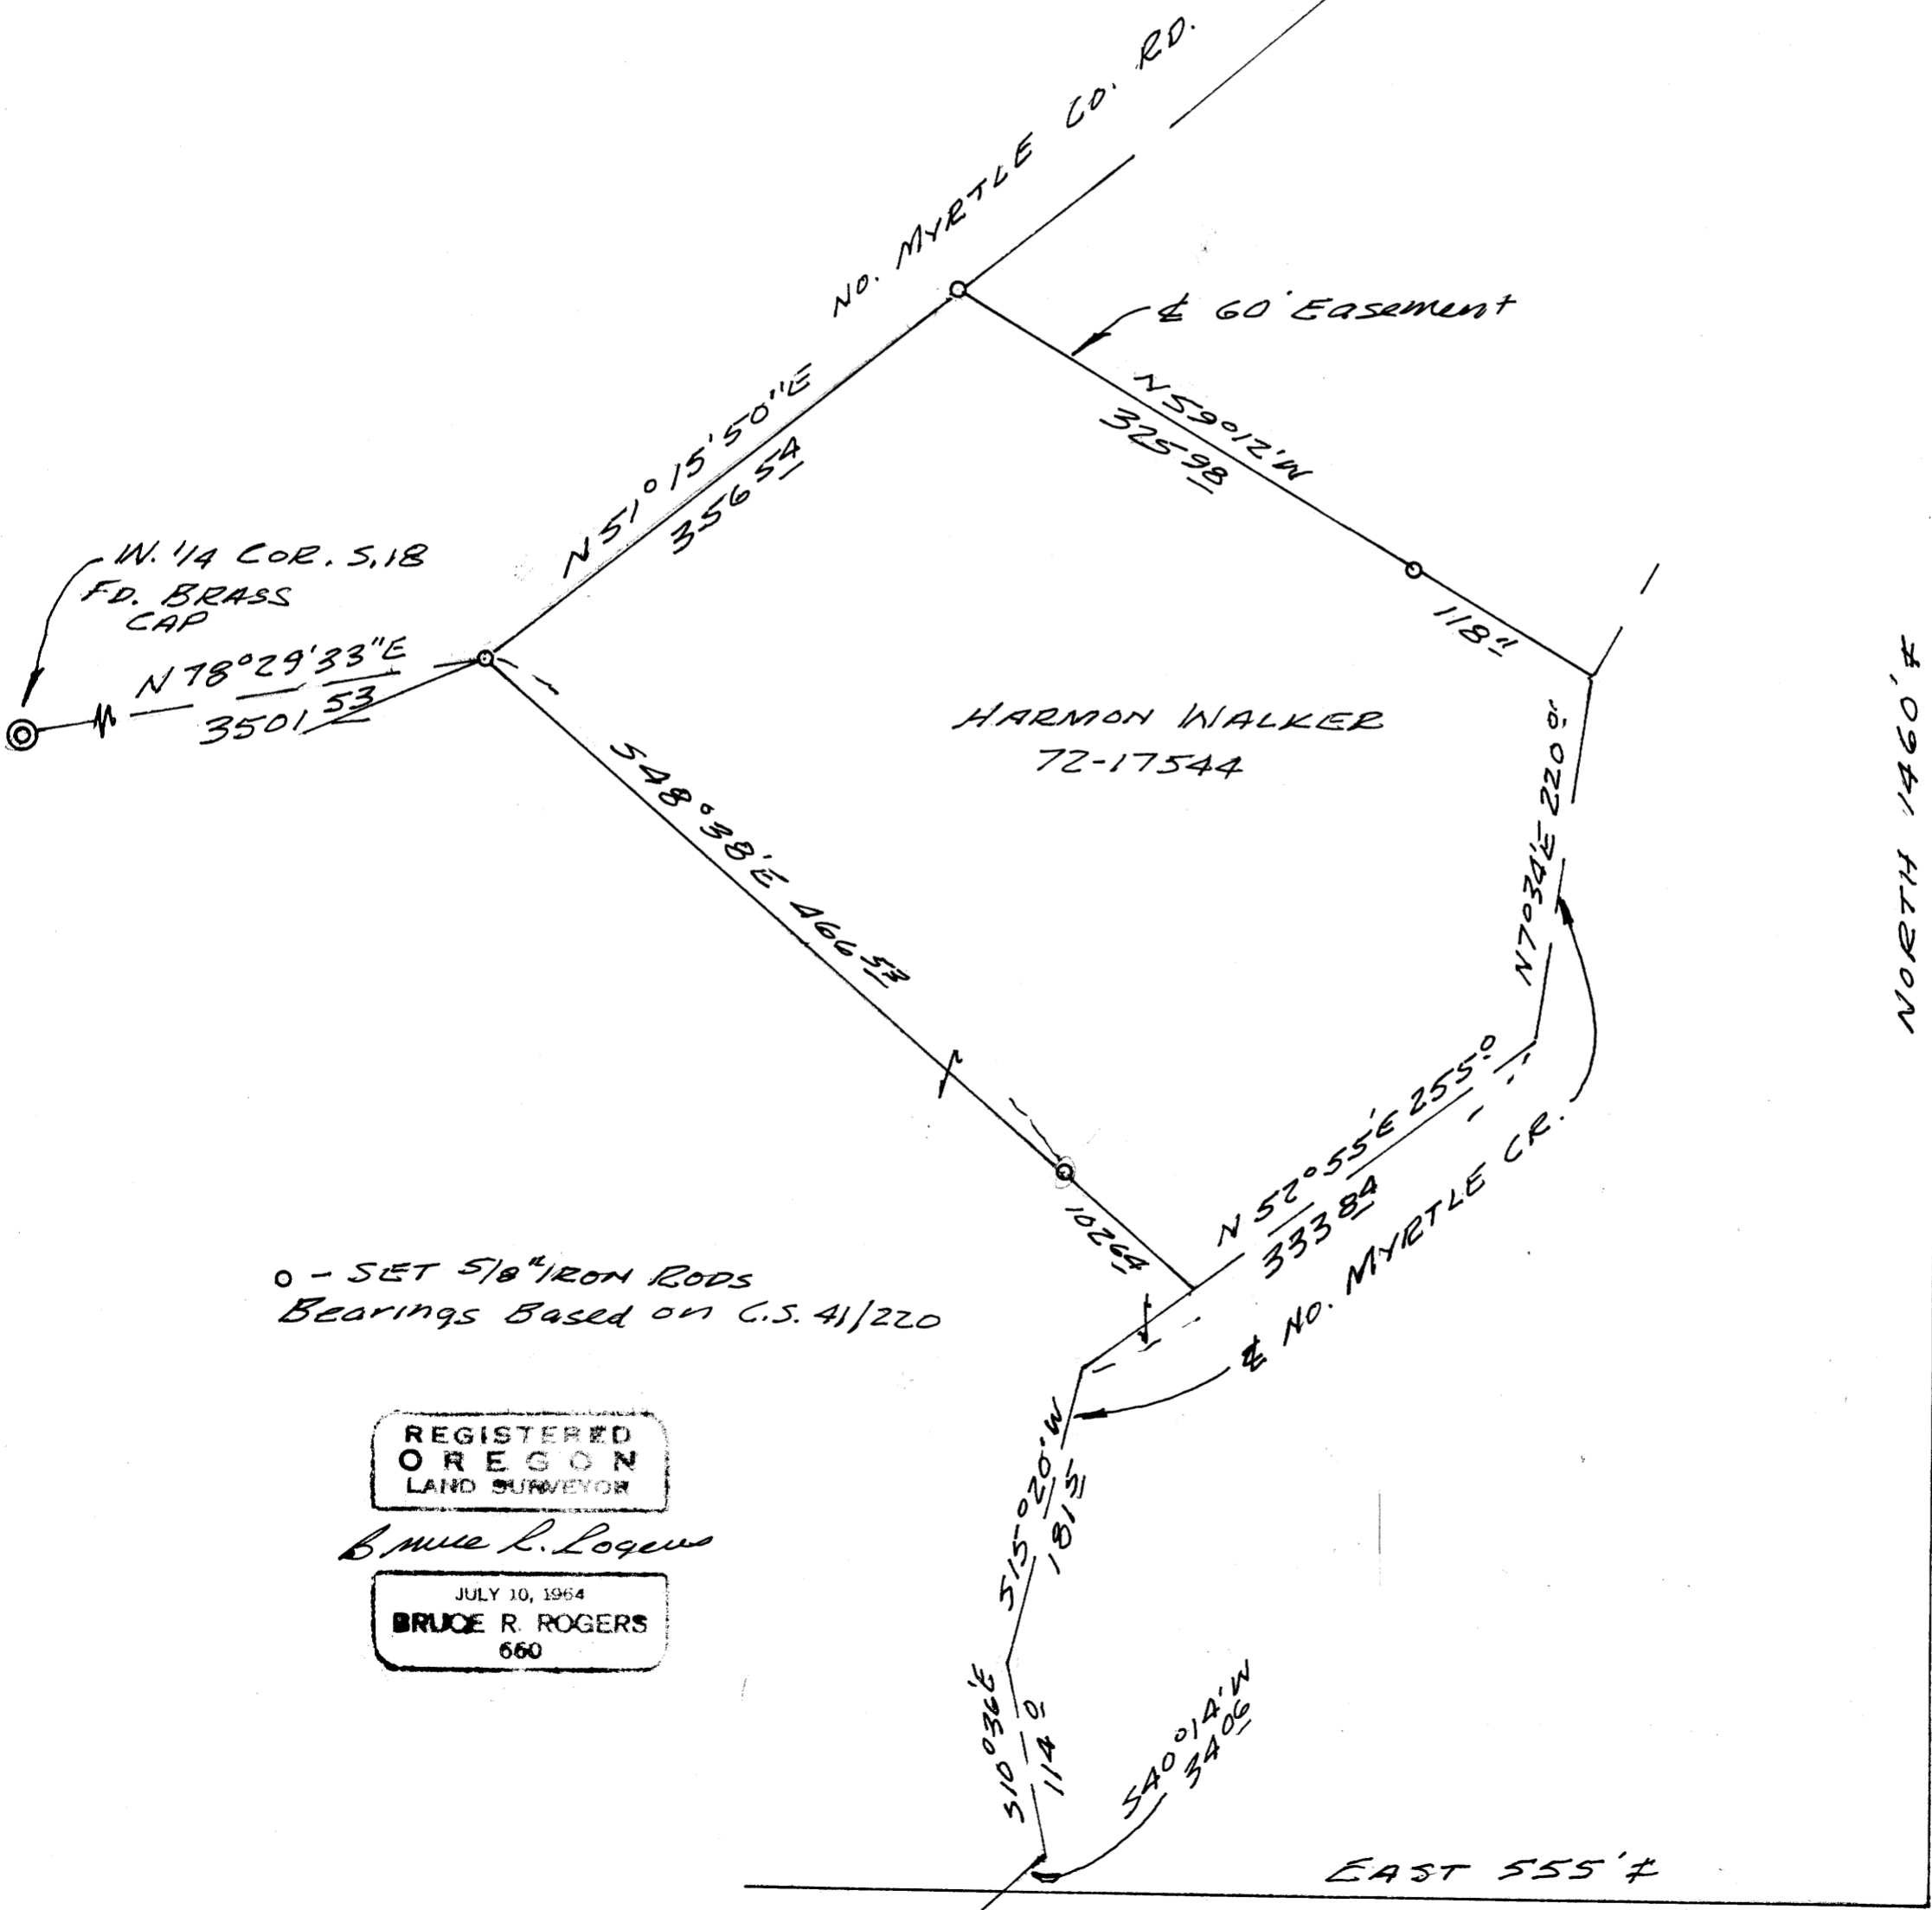

0 - SET 5/8" IRON RODS
Bearings Based on C.S. 41/220

REGISTERED
OREGON
LAND SURVEYOR

Bruce R. Rogers

JULY 10, 1964
BRUCE R. ROGERS
660