


COUNTY SURVEYORS FILE DATA
DO NOT REMOVE FROM OFFICE

FILED
RECEIVED JUN

JUL 13 1978

COUNTY SURVEYOR
DOUGLAS COUNTY, ORE.
TB

VICINITY SKETCH

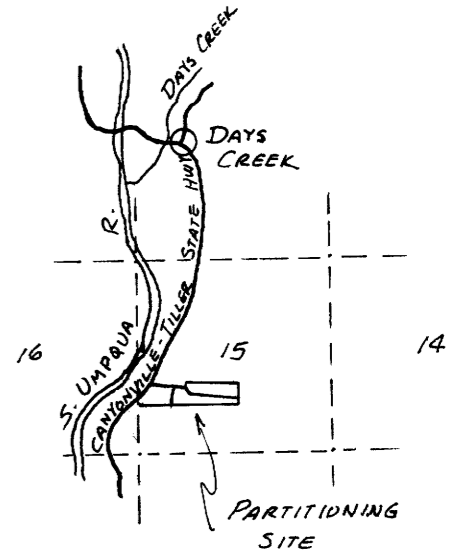

SURVEY IN S.W. 1/4 SEC. 15, T30S, R4W, W.M.
Surveyed for Roy & Donna May, Star Rt., Box 6-A, Days Creek, OR.
Surveyed by Victor M. McLind
July, 1978

Scale: 1" = 200'

LEGEND

- ~ Set 5/8" x 30" Iron Rod
- ~ Found 1/2" Iron Pipe, unless otherwise noted

REGISTERED
PROFESSIONAL
LAND SURVEYOR

Victor M. McLind

OREGON
JULY 17, 1970
VICTOR M. MCLIND
934

PARTITIONER: ROY & DONNA MAY, STAR RT. BOX 6-A, DAYS CREEK, OR. 97429 Ph. 825-3610

LEGAL OWNER OF RECORD: SAME AS ABOVE

TOTAL NUMBER OF LOTS: THREE

WATER SUPPLY: WELLS AND/OR SPRINGS

SEWER SUPPLY: SEPTIC TANKS

