


SURVEY TO LOCATE SEPTIC PIT FOR JAMES LACKEY in Sec. 30, T. 30 S., R. 5 W., W.M.

Scale: 1" = 30'

August 7, 1978

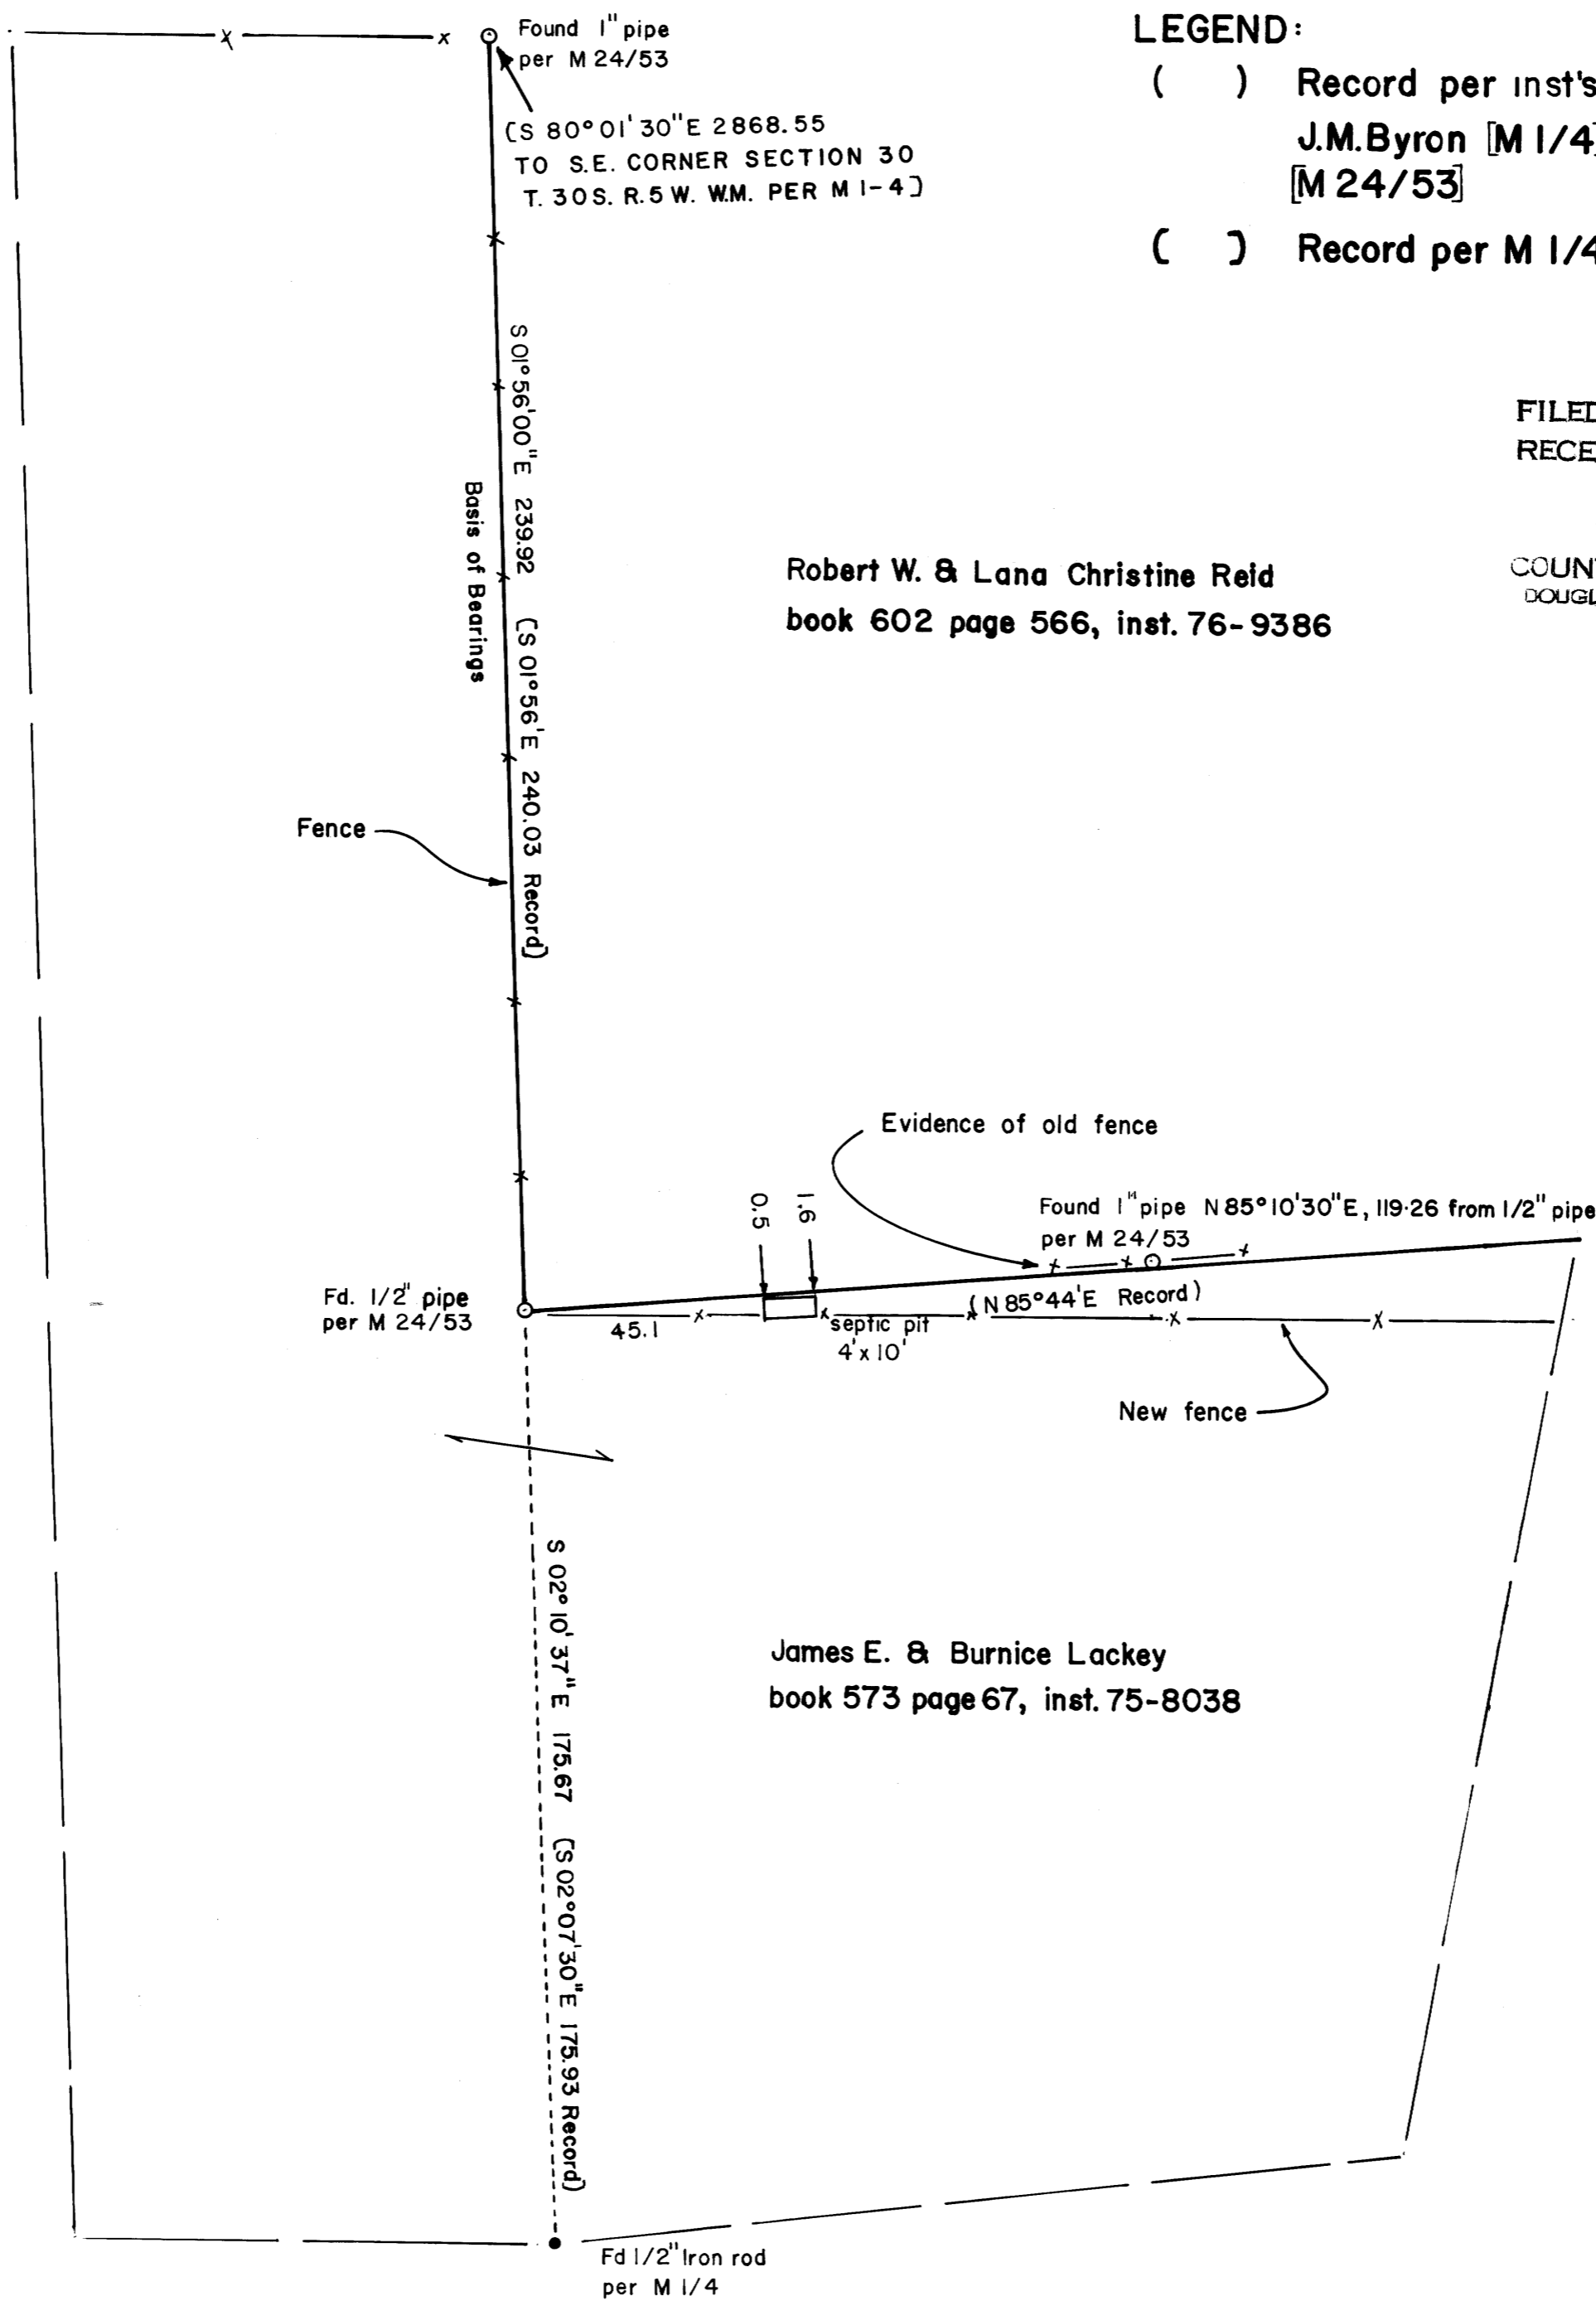

LEGEND:

- ( ) Record per inst's 76-9386 & 75-8038, J.M. Byron [M 1/4], and G.J. Wenderoth [M 24/53]
- ( ) Record per M 1/4

FILED *d*  
RECEIVED *dh*  
AUG 21 1978  
COUNTY SURVEYOR  
DOUGLAS COUNTY, ORE.  
*JB*

Robert W. & Lana Christine Reid  
book 602 page 566, inst. 76-9386

James E. & Burnice Lackey  
book 573 page 67, inst. 75-8038

*Whitcomb*