

SURVEY IN SEC. 20, T.28S.R.6W.W.M. FOR PROPERTY DESCRIPTION

FOR: NICHOLS
BY: BAUGHMAN TECHNICAL SERVICES INC

AUGUST 1978

SCALE: 1" = 20'


FILED
RECEIVED

AUG 23 1978

COUNTY SURVEYOR
DOUGLAS COUNTY, ORE.

JB

NE Cor. D.L.C. 51
T28S R6W WM
(Loc. calc. from M42-2)

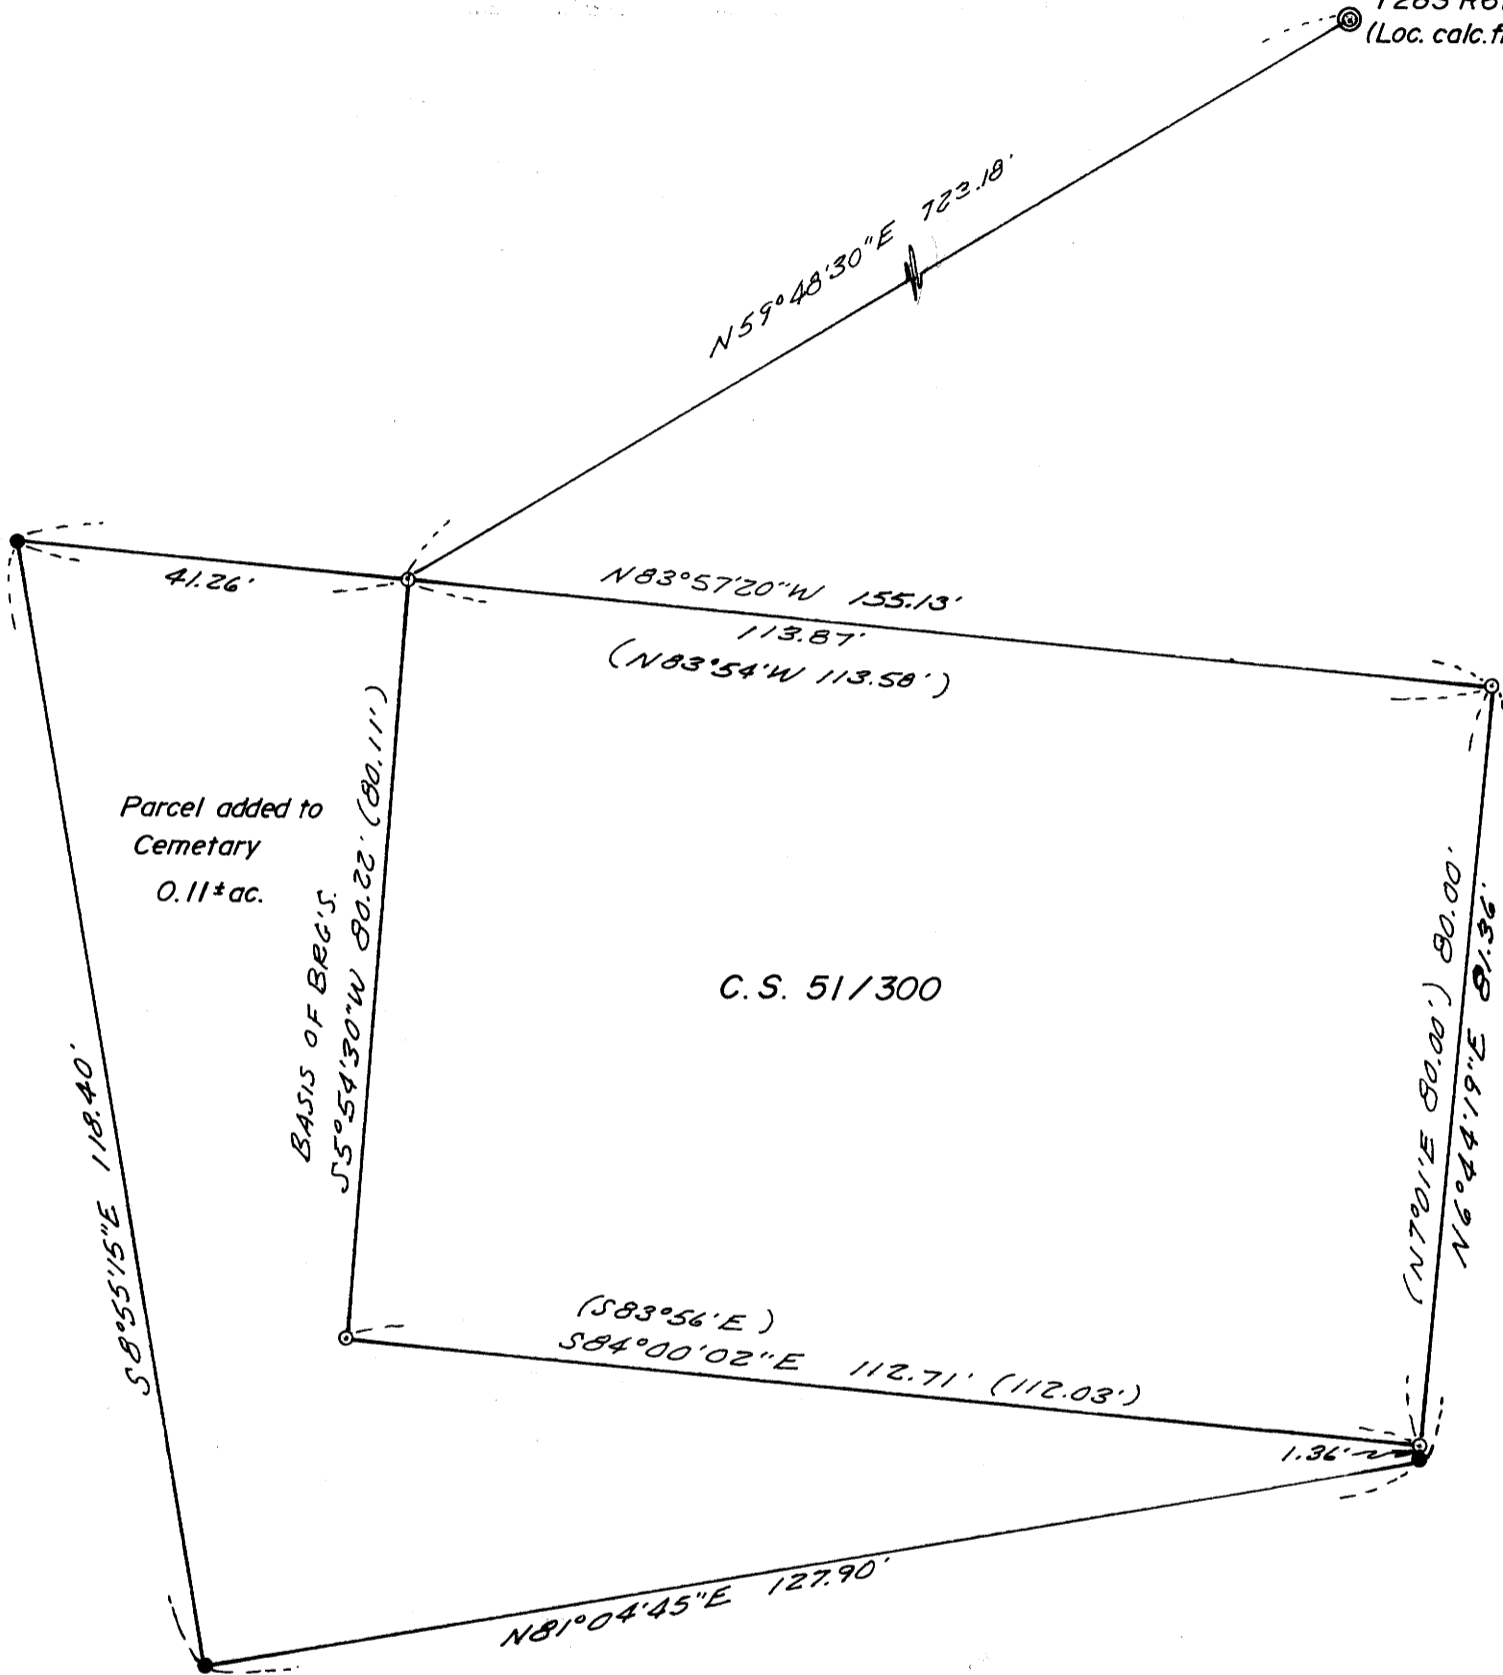

LEGEND

- — Set 1/2" iron rod
- — Found 1-1/2" iron pipe

REGISTERED
PROFESSIONAL
LAND SURVEYOR

Glenn S. Baughman

OREGON
JULY 14, 1961
GLENN S. BAUGHMAN
536

COUNTY SURVEYORS FILE DATA
DO NOT REMOVE FROM OFFICE

FM4-803