

SURVEY FOR DESCRIPTION

IN SECTION 24, T.30S.R.6W.W.M.

FOR: DARRELL CARTER

BY: BAUGHMAN TECHNICAL SERVICES INC.

FILED
RECEIVED JAH

SEP 8 1978

COUNTY SURVEYOR
DOUGLAS COUNTY, ORE.


SEPTEMBER 1978 - SCALE: 1" = 50'

COUNTY SURVEYORS FILE DATA
DO NOT REMOVE FROM OFFICE

NE Cor. DLC No. 47
T30S R6WWM
calc. from CS 58/106

REGISTERED
PROFESSIONAL
LAND SURVEYOR

OREGON
JULY 14, 1961
GLENN S. BAUGHMAN
536

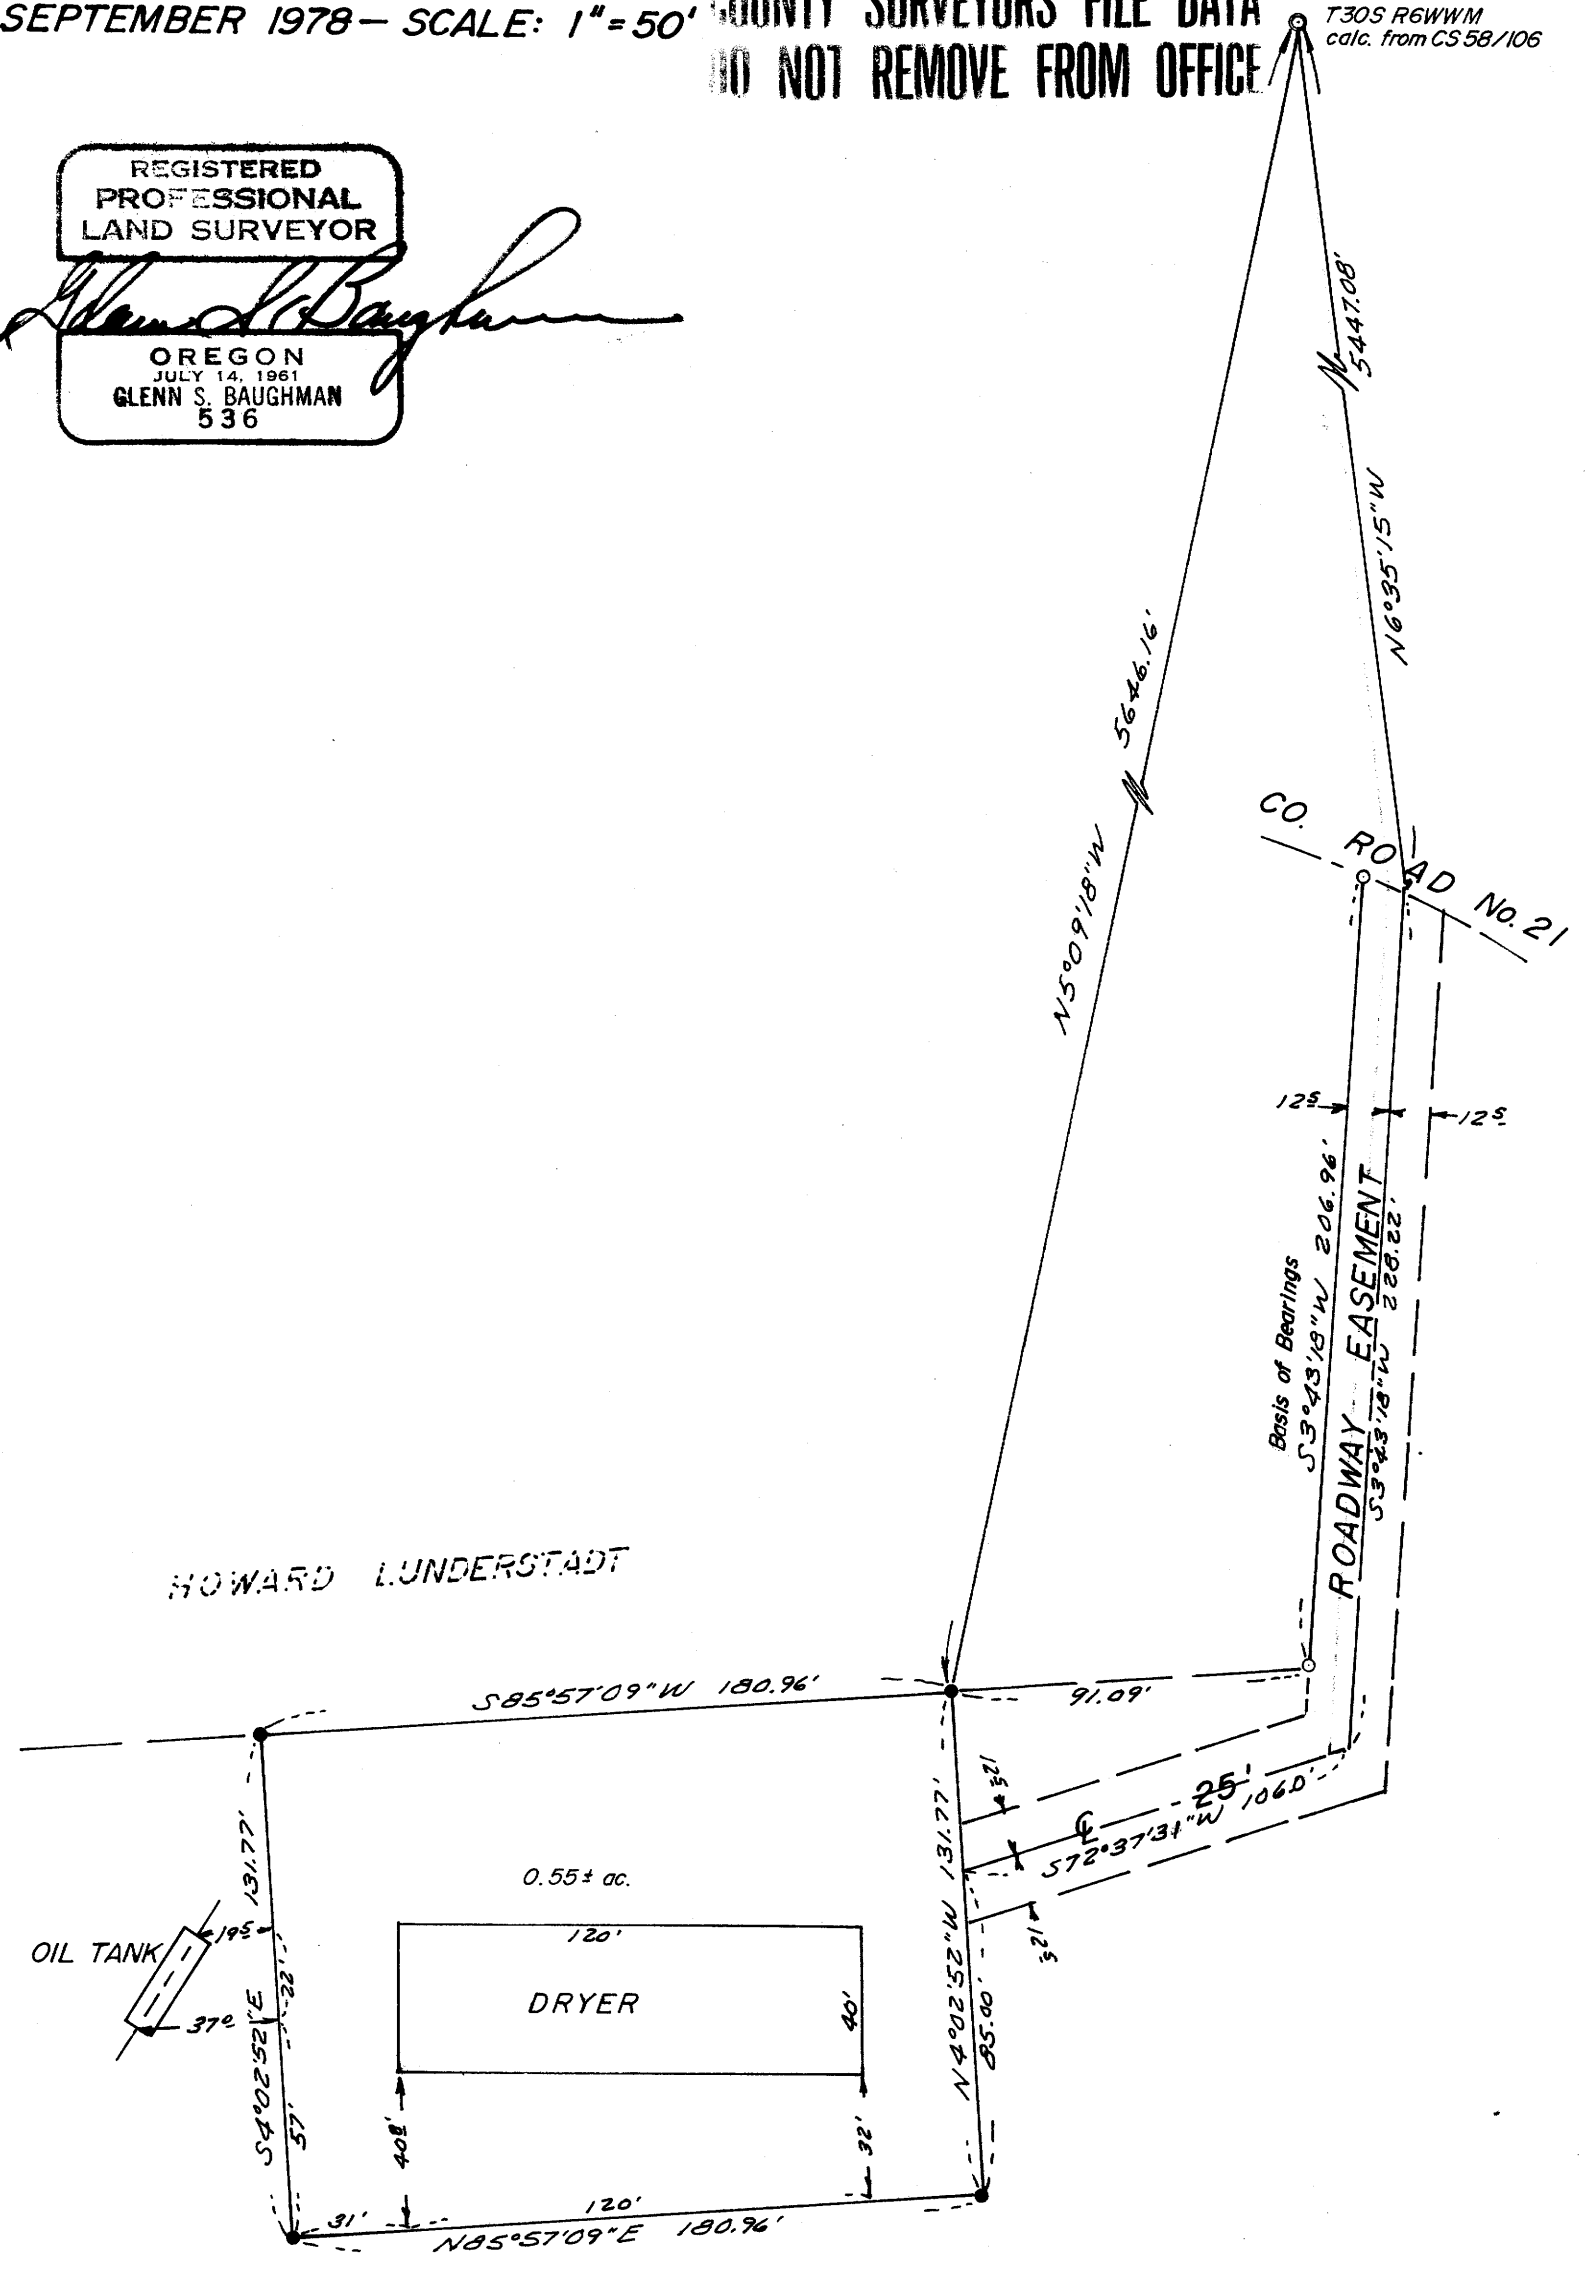

HOWARD LUNDERSTADT

LEGEND

- — Found 5/8" iron rod
- — Set 1/2" iron rod