

COUNTY SURVEYORS FILE DATA
DO NOT REMOVE FROM OFFICE

FILED ✓
RECEIVED ✓

SEP 16 1978

COUNTY SURVEYOR
DOUGLAS COUNTY, ORE.


TH

SURVEY of DEED DESCRIPTION FOR RODNEY V. BOQUA

SECTION 26, T29S, R5W, W4E

SEPT. 1978

BY - HAROLD V. STOCKHOFF R.L.S.

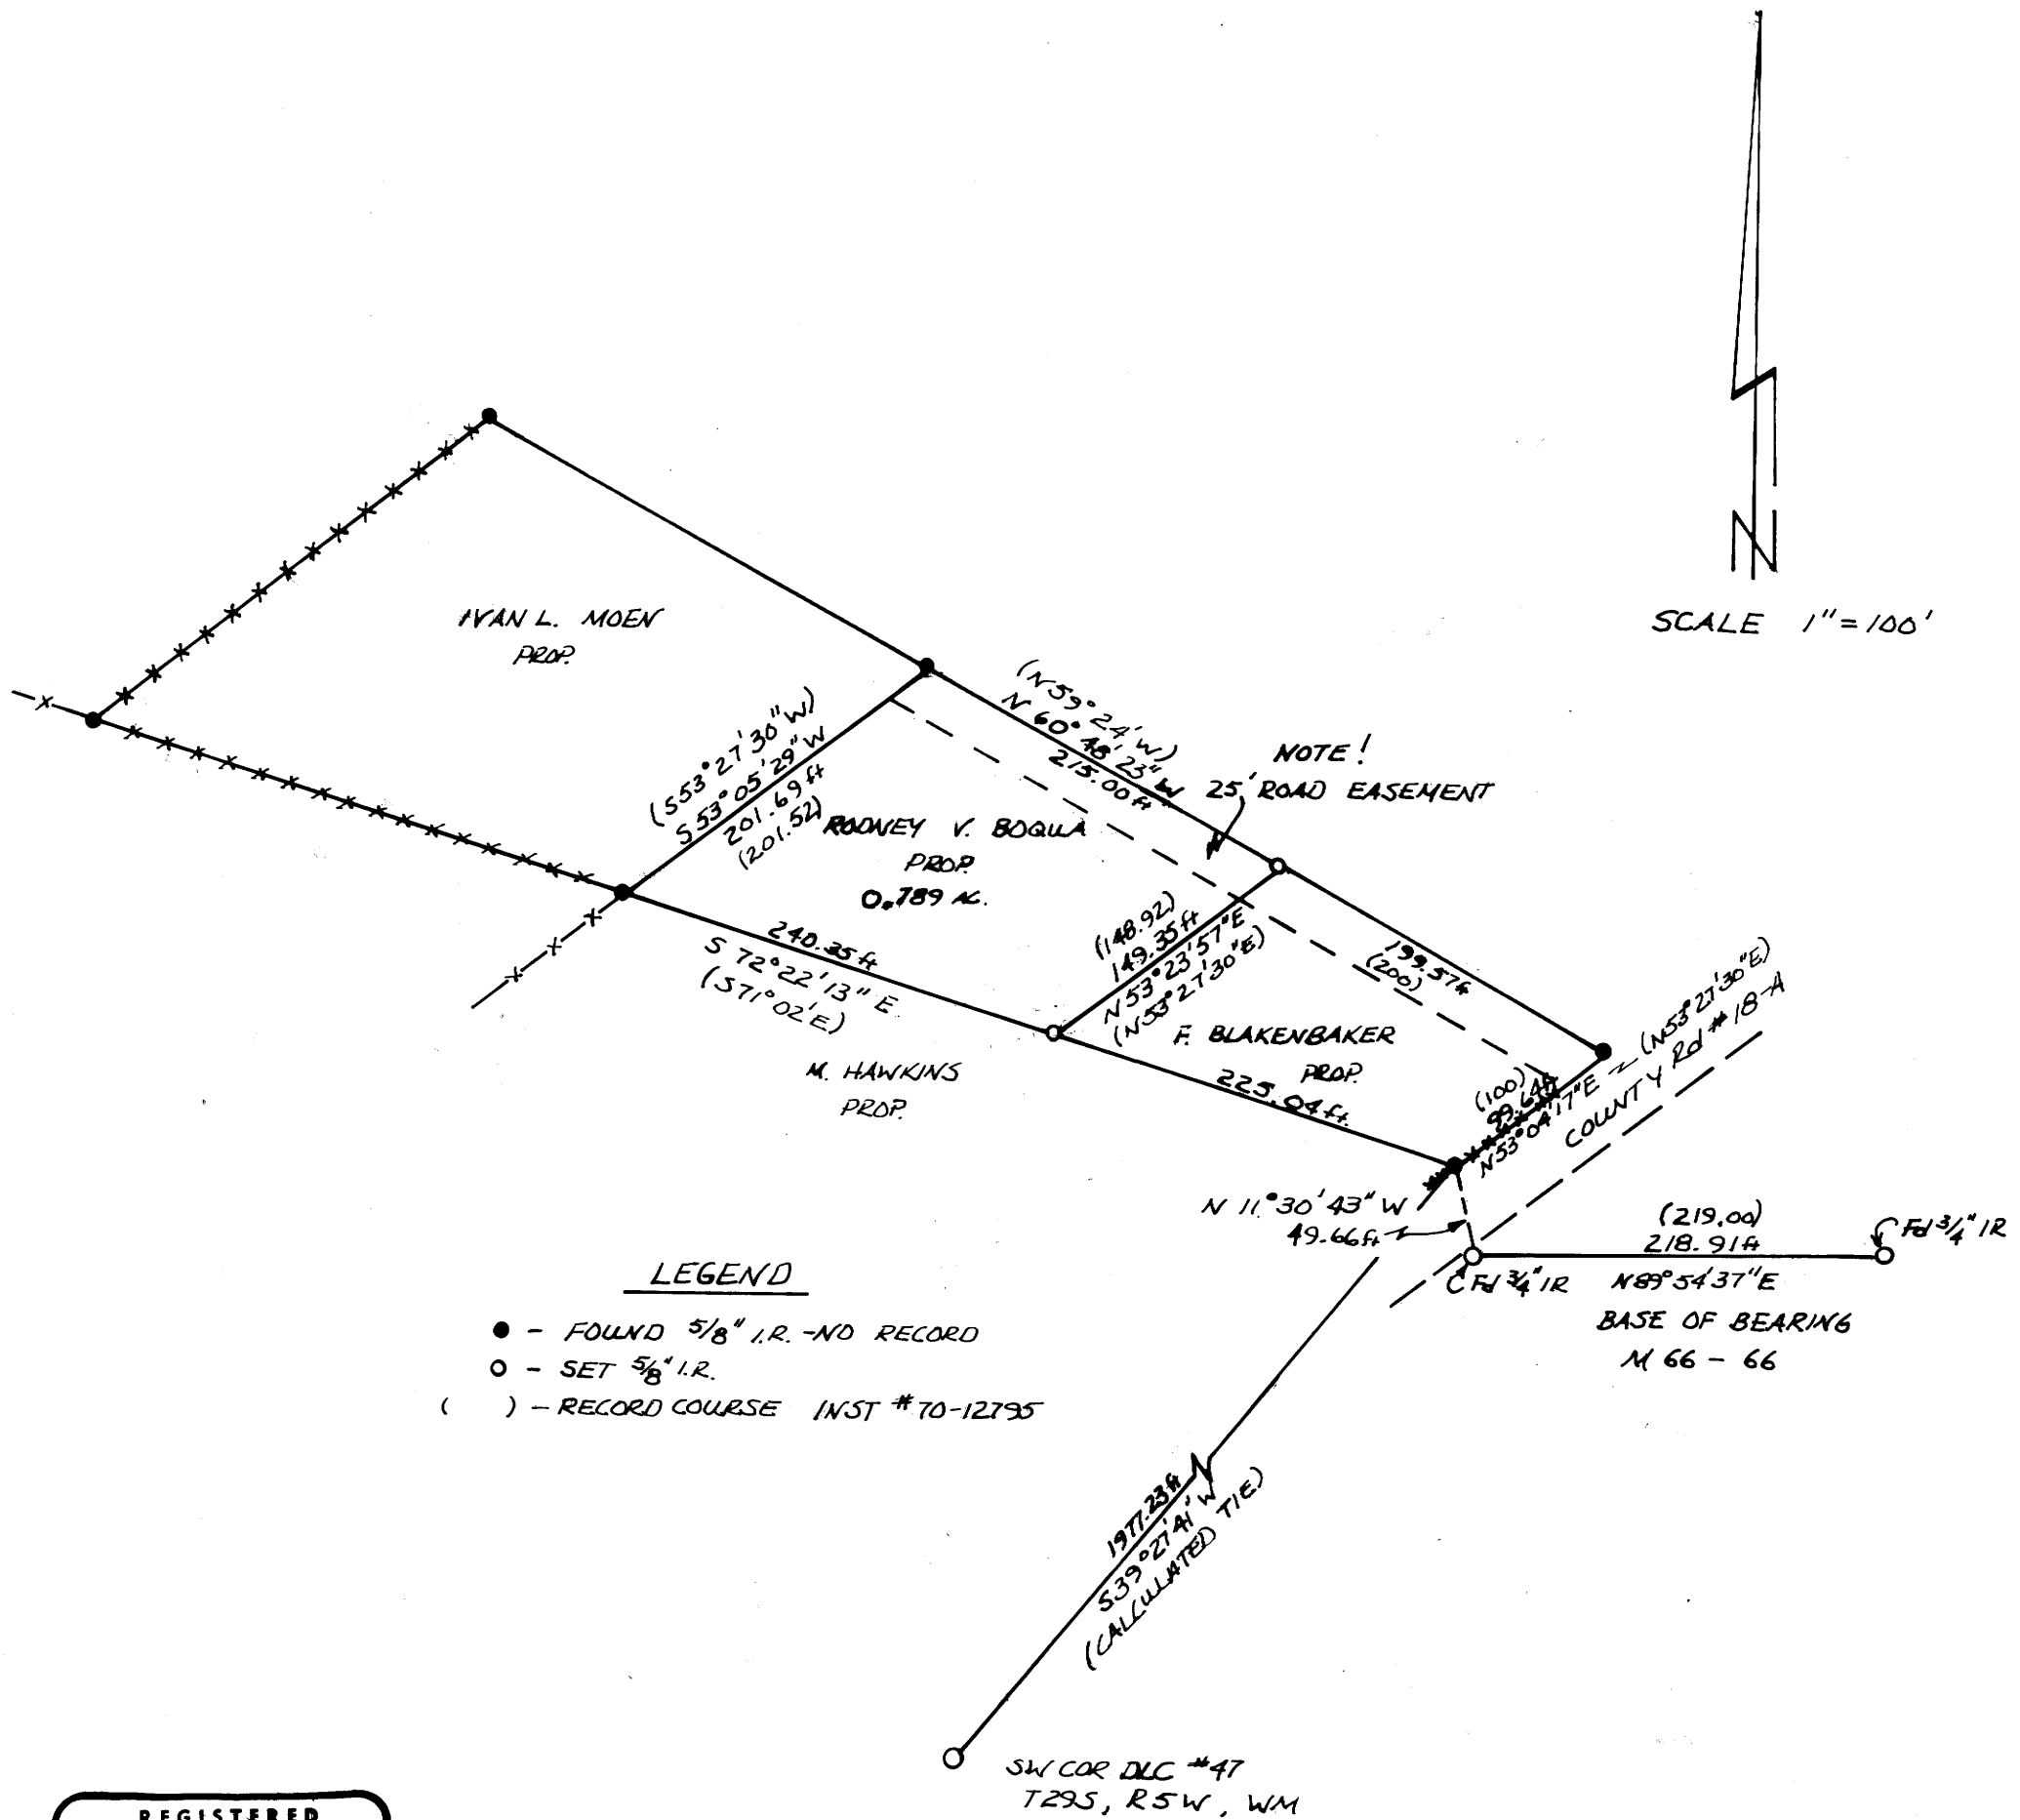

LEGEND

- - FOUND 5/8" I.R. - NO RECORD
- - SET 5/8" I.R.
- () - RECORD COURSE INST # 70-12795

REGISTERED
PROFESSIONAL
LAND SURVEYOR

Harold V. Stockhoff

OREGON
JULY 14, 1978
MAROLD V. STOCKHOFF
1663