

SURVEY FOR DESCRIPTION

IN SECTION 19, T.28S. R.6W.W.M. - JULY 1978

FOR: KURT OEHLER

BY: BAUGHMAN TECHNICAL SERVICES INC.


FILED
RECEIVED

SEP 15 1978

COUNTY SURVEYOR
DOUGLAS COUNTY, ORE.

JOINT SURVEYORS FILE DATA SCALE: 1"=100'
DO NOT REMOVE FROM OFFICE

1/4 cor. loc. calc. from
M36-27

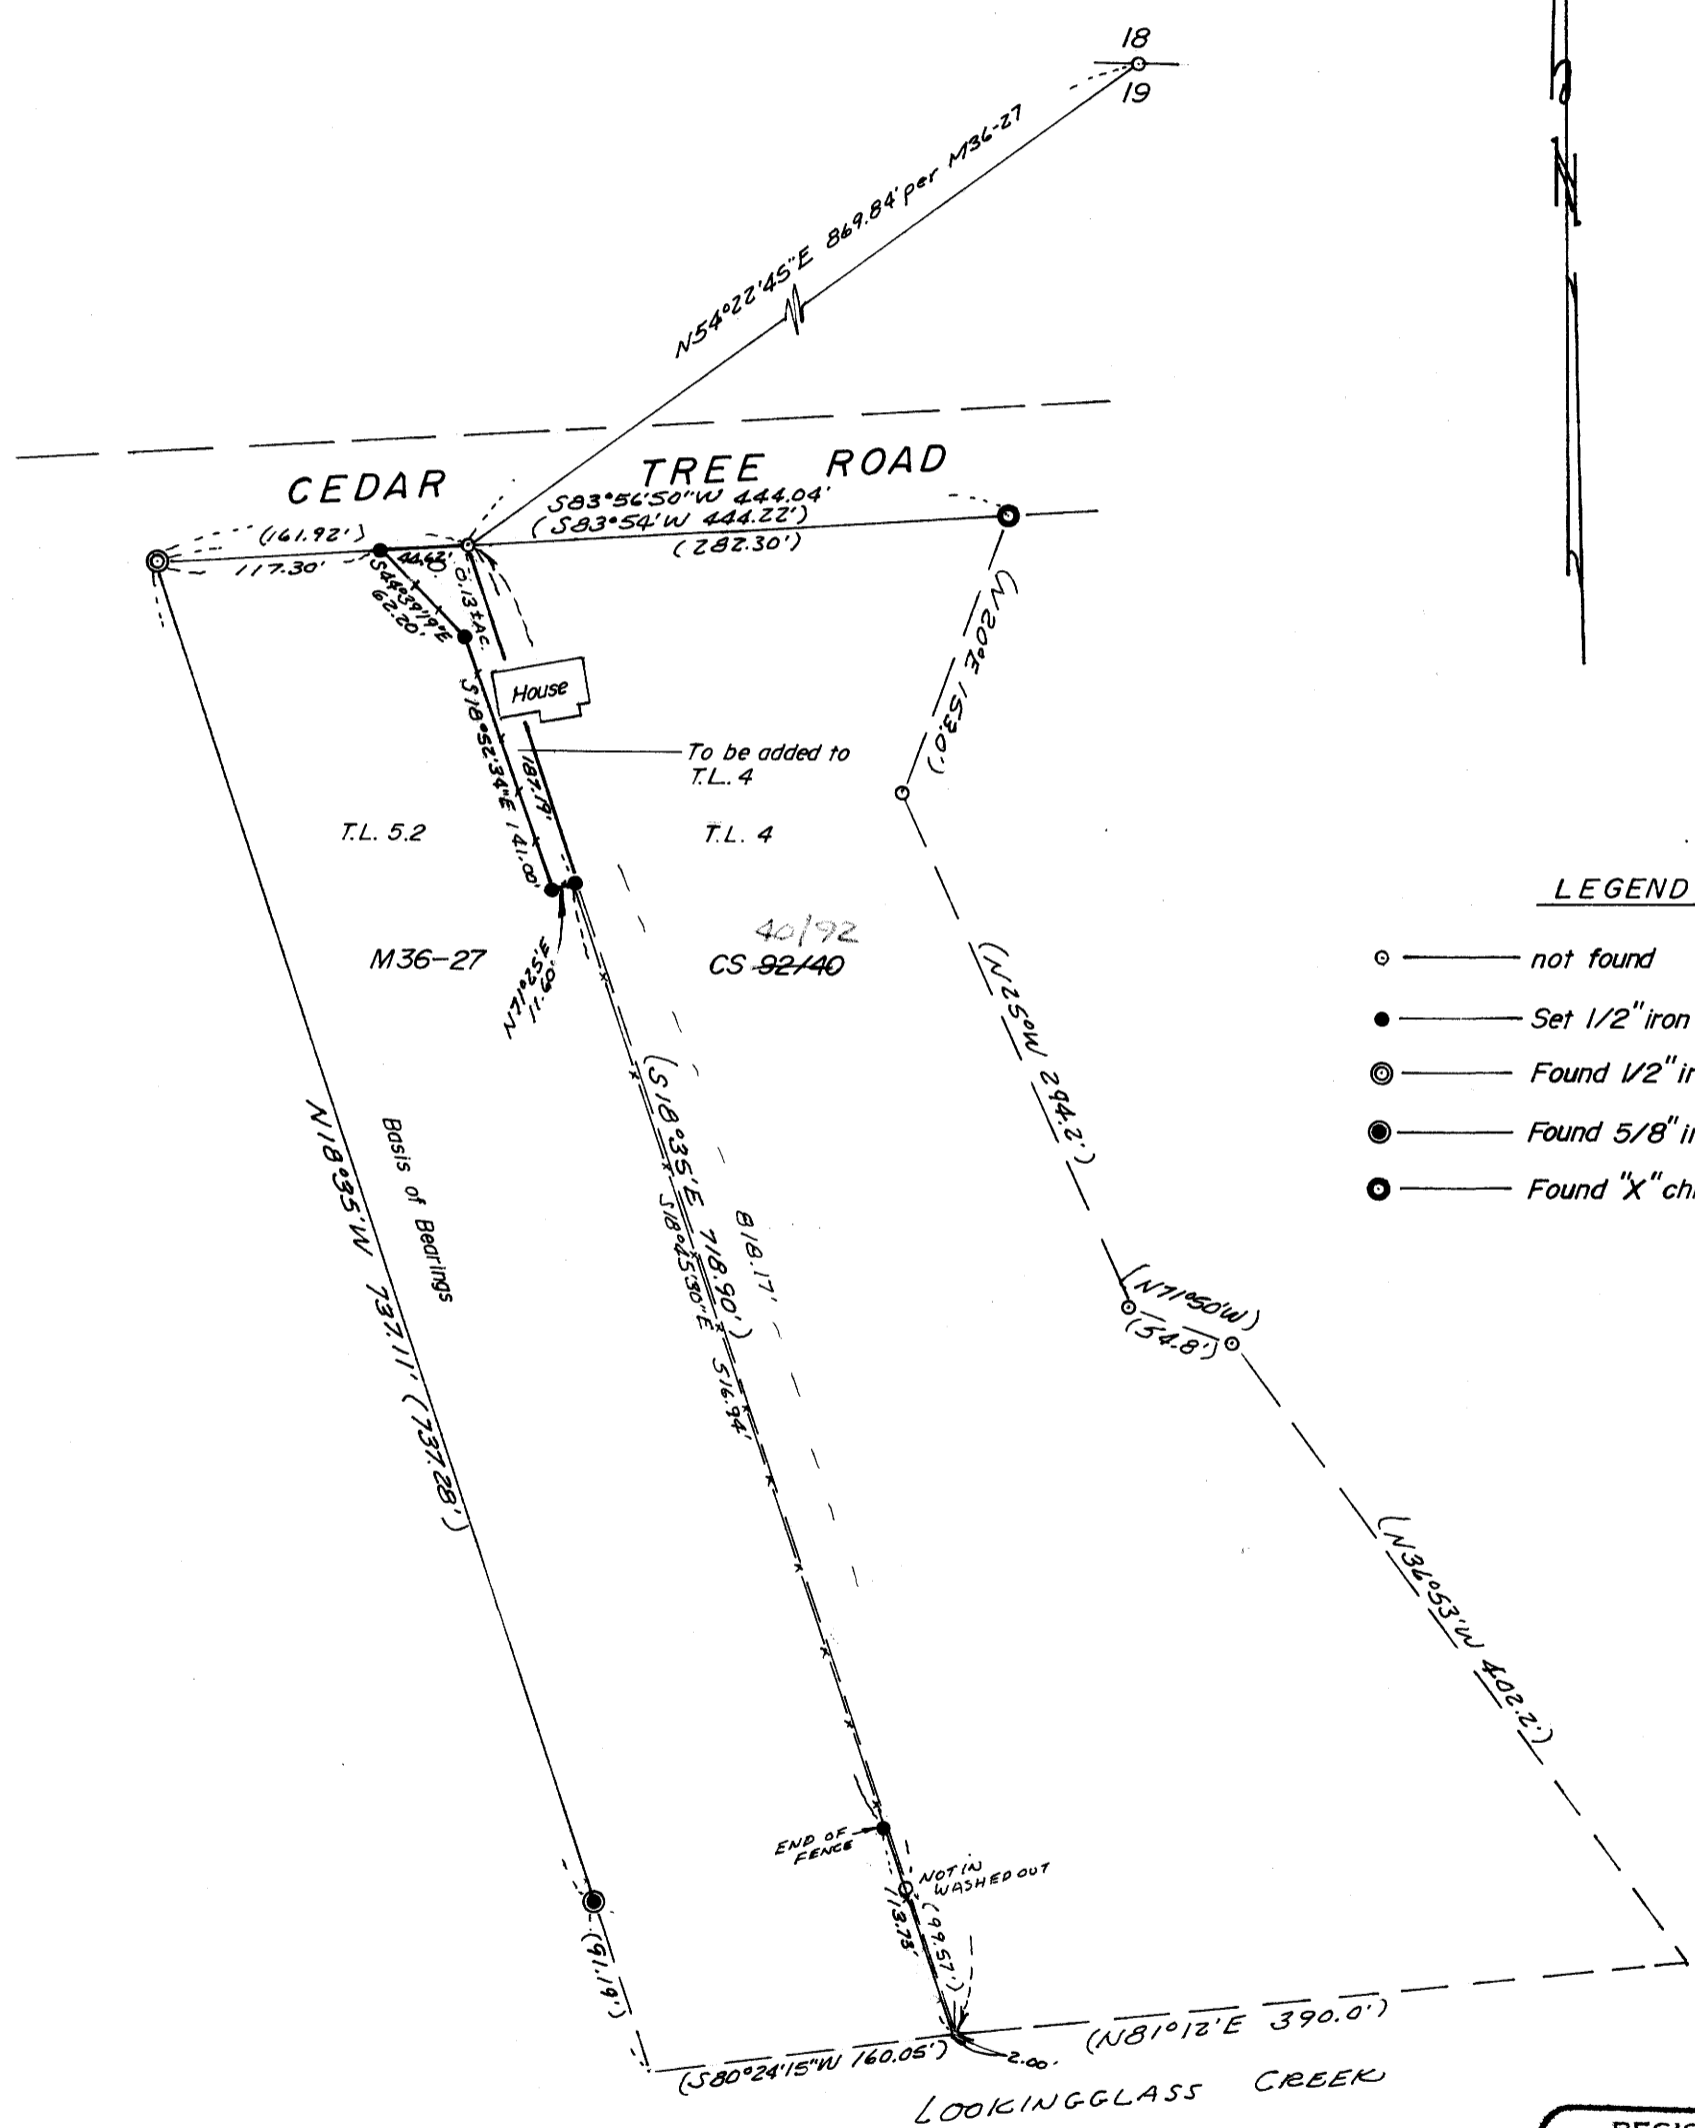

LEGEND

- — not found
- — Set 1/2" iron rod
- ⊙ — Found 1/2" iron rod
- ⊗ — Found 5/8" iron rod
- ⊕ — Found "X" chiseled in rock

REGISTERED
PROFESSIONAL
LAND SURVEYOR

Glenn S. Baughman

OREGON
JULY 14, 1961
GLENN S. BAUGHMAN
536