


FILED ✓
RECEIVED dh

OCT 5 1978

COUNTY SURVEYOR
DOUGLAS COUNTY, ORE.
TB

MAP FILE M 73-52

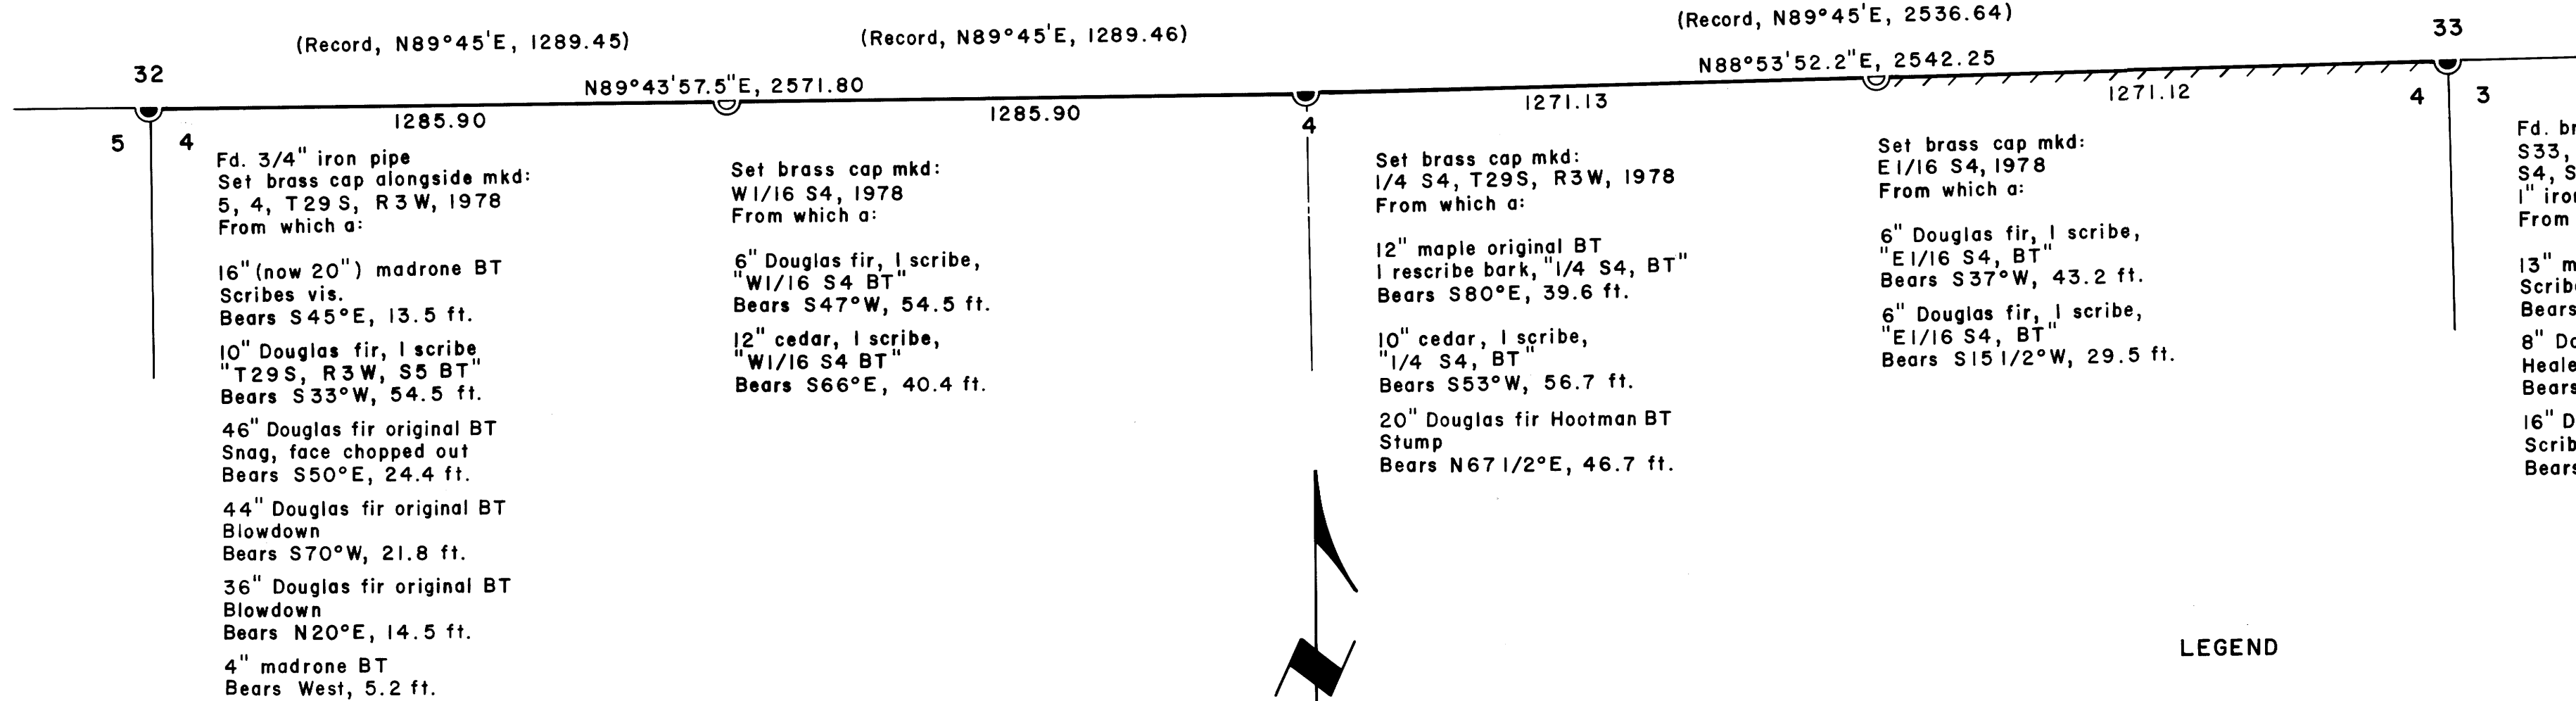

**SURVEY OF THE NORTH LINE OF
SEC. 4, T29S, R3W, W. M.**


For: Longview Fibre
Longview, Washington
By: Shaner Engineering, Inc.
Roseburg, Oregon 97470

September 25, 1978

**COUNTY SURVEYORS FILE DATA
DO NOT REMOVE FROM OFFICE**

REGISTERED
PROFESSIONAL
LAND SURVEYOR
BA Shaner
OREGON
OCT. 4, 1957
BRUCE A SHANER
430

Basis of bearings:
Mag. decl. 20°E

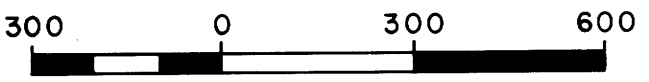

Scale: 1" = 300'

LEGEND

- Corner found
- Corner set
- Line blazed and painted

Note:
See County Surveyor's Map File, M 20-5.