

SURVEY TO SET PROPERTY CORNERS

IN SECTION 27, T.30S.R.5W.W.M.

FOR: FRED HARDER

BY: BAUGHMAN SURVEYING SERVICES INC.

OCTOBER 1978 — SCALE 1" = 50'

COUNTY SURVEYORS FILE DATA
DO NOT REMOVE FROM OFFICE

FILED *J*
RECEIVED *JHH*


OCT 23 1978

COUNTY SURVEYOR
DOUGLAS COUNTY, ORE.
JHH

REGISTERED
PROFESSIONAL
LAND SURVEYOR

Glenn S. Baughman

OREGON
JULY 14, 1961
GLENN S. BAUGHMAN
536

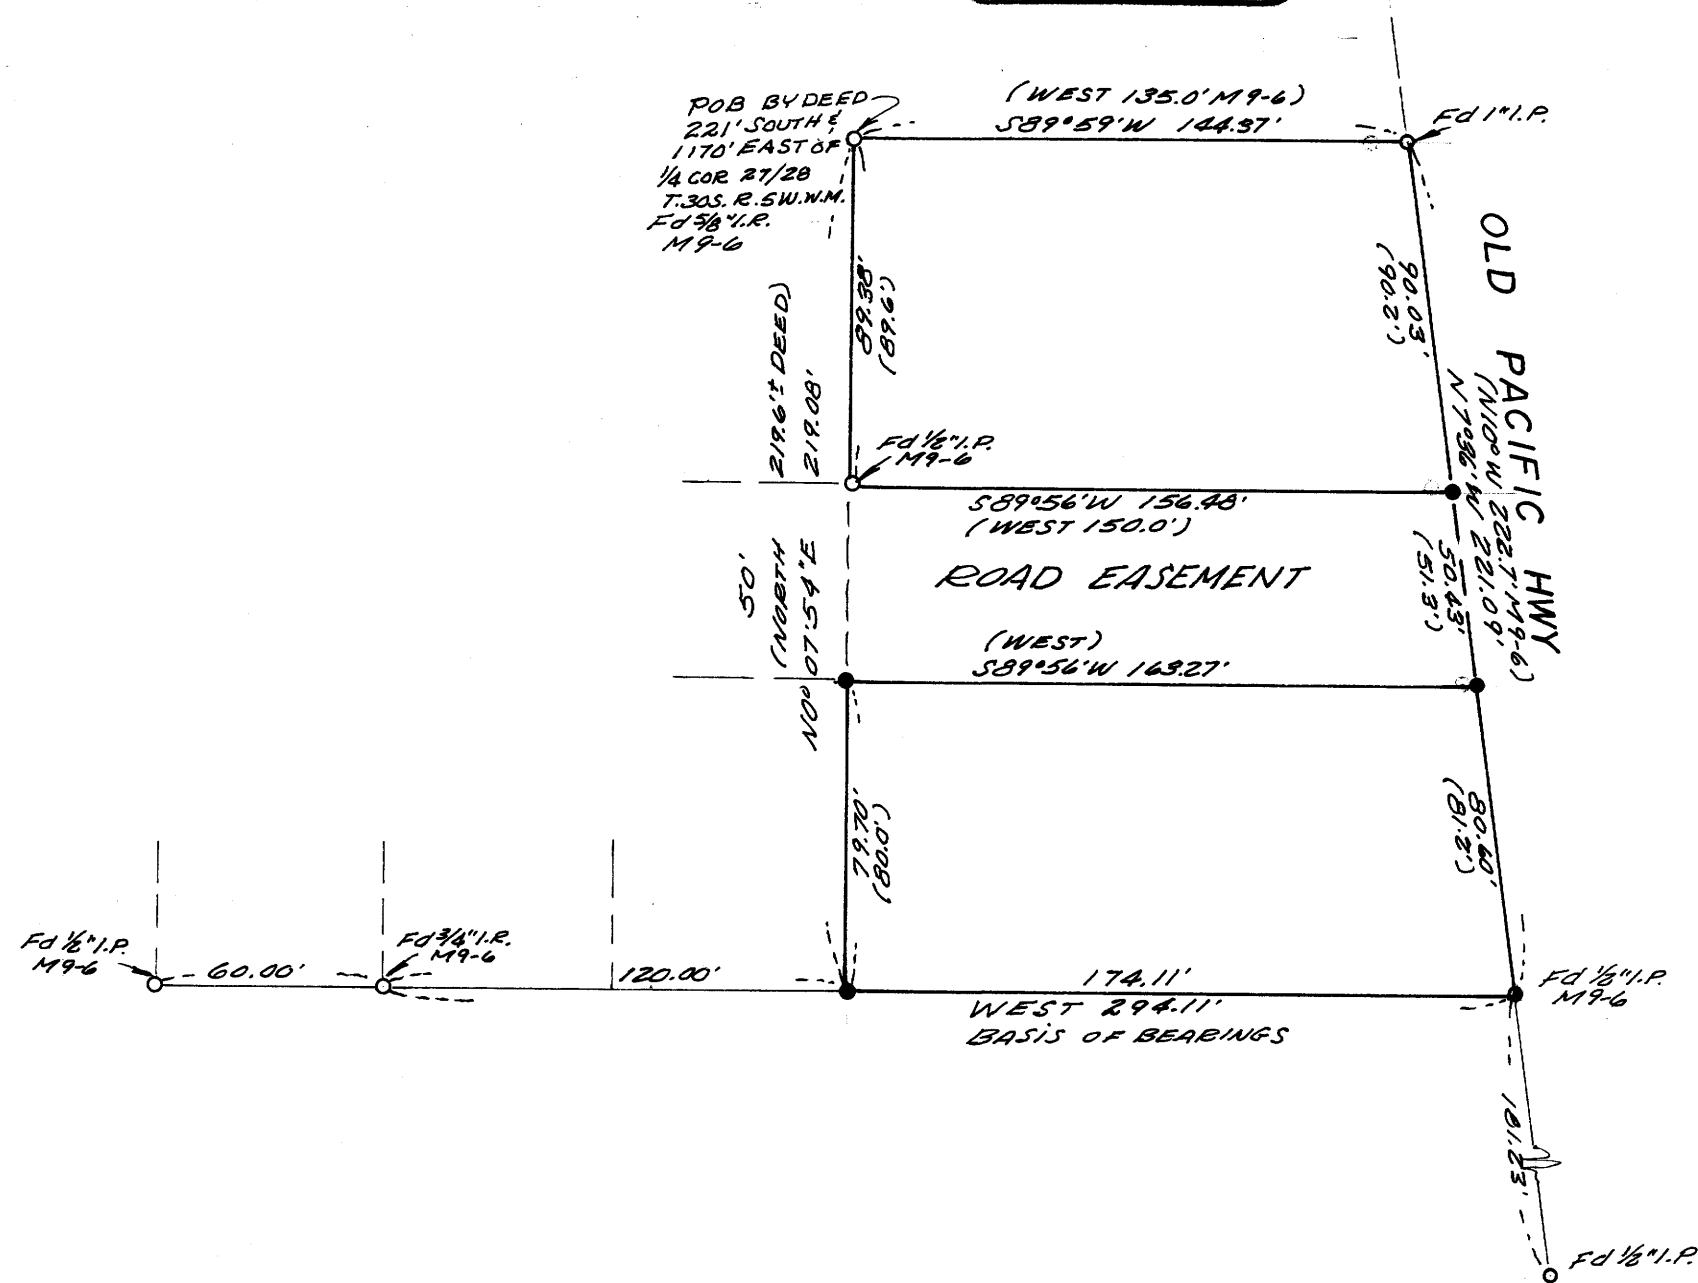

LEGEND

- — Set 5/8" iron rod
- — Point found, is as shown

MAP FILE M 73-70

MAP FILE M 73-70