

SURVEY TO SET PROPERTY CORNERS

LOT 8, TOWER SUBDIVISION - SECTION 21 T.28S. R.6W.W.M.

FOR: JANINE TICHY
BY: BAUGHMAN TECHNICAL SERVICES INC.

COUNTY SURVEYORS FILE
DO NOT REMOVE FROM OFFICE

OCTOBER 1978 — SCALE: 1" = 20'

REGISTERED
PROFESSIONAL
LAND SURVEYOR

Glenn S. Baughman

OREGON
JULY 14, 1961
GLENN S. BAUGHMAN
536

FILED
RECEIVED


NOV 16 1978

COUNTY SURVEYOR
DOUGLAS COUNTY, ORE.

TH

LOT 7

TOWER STREET

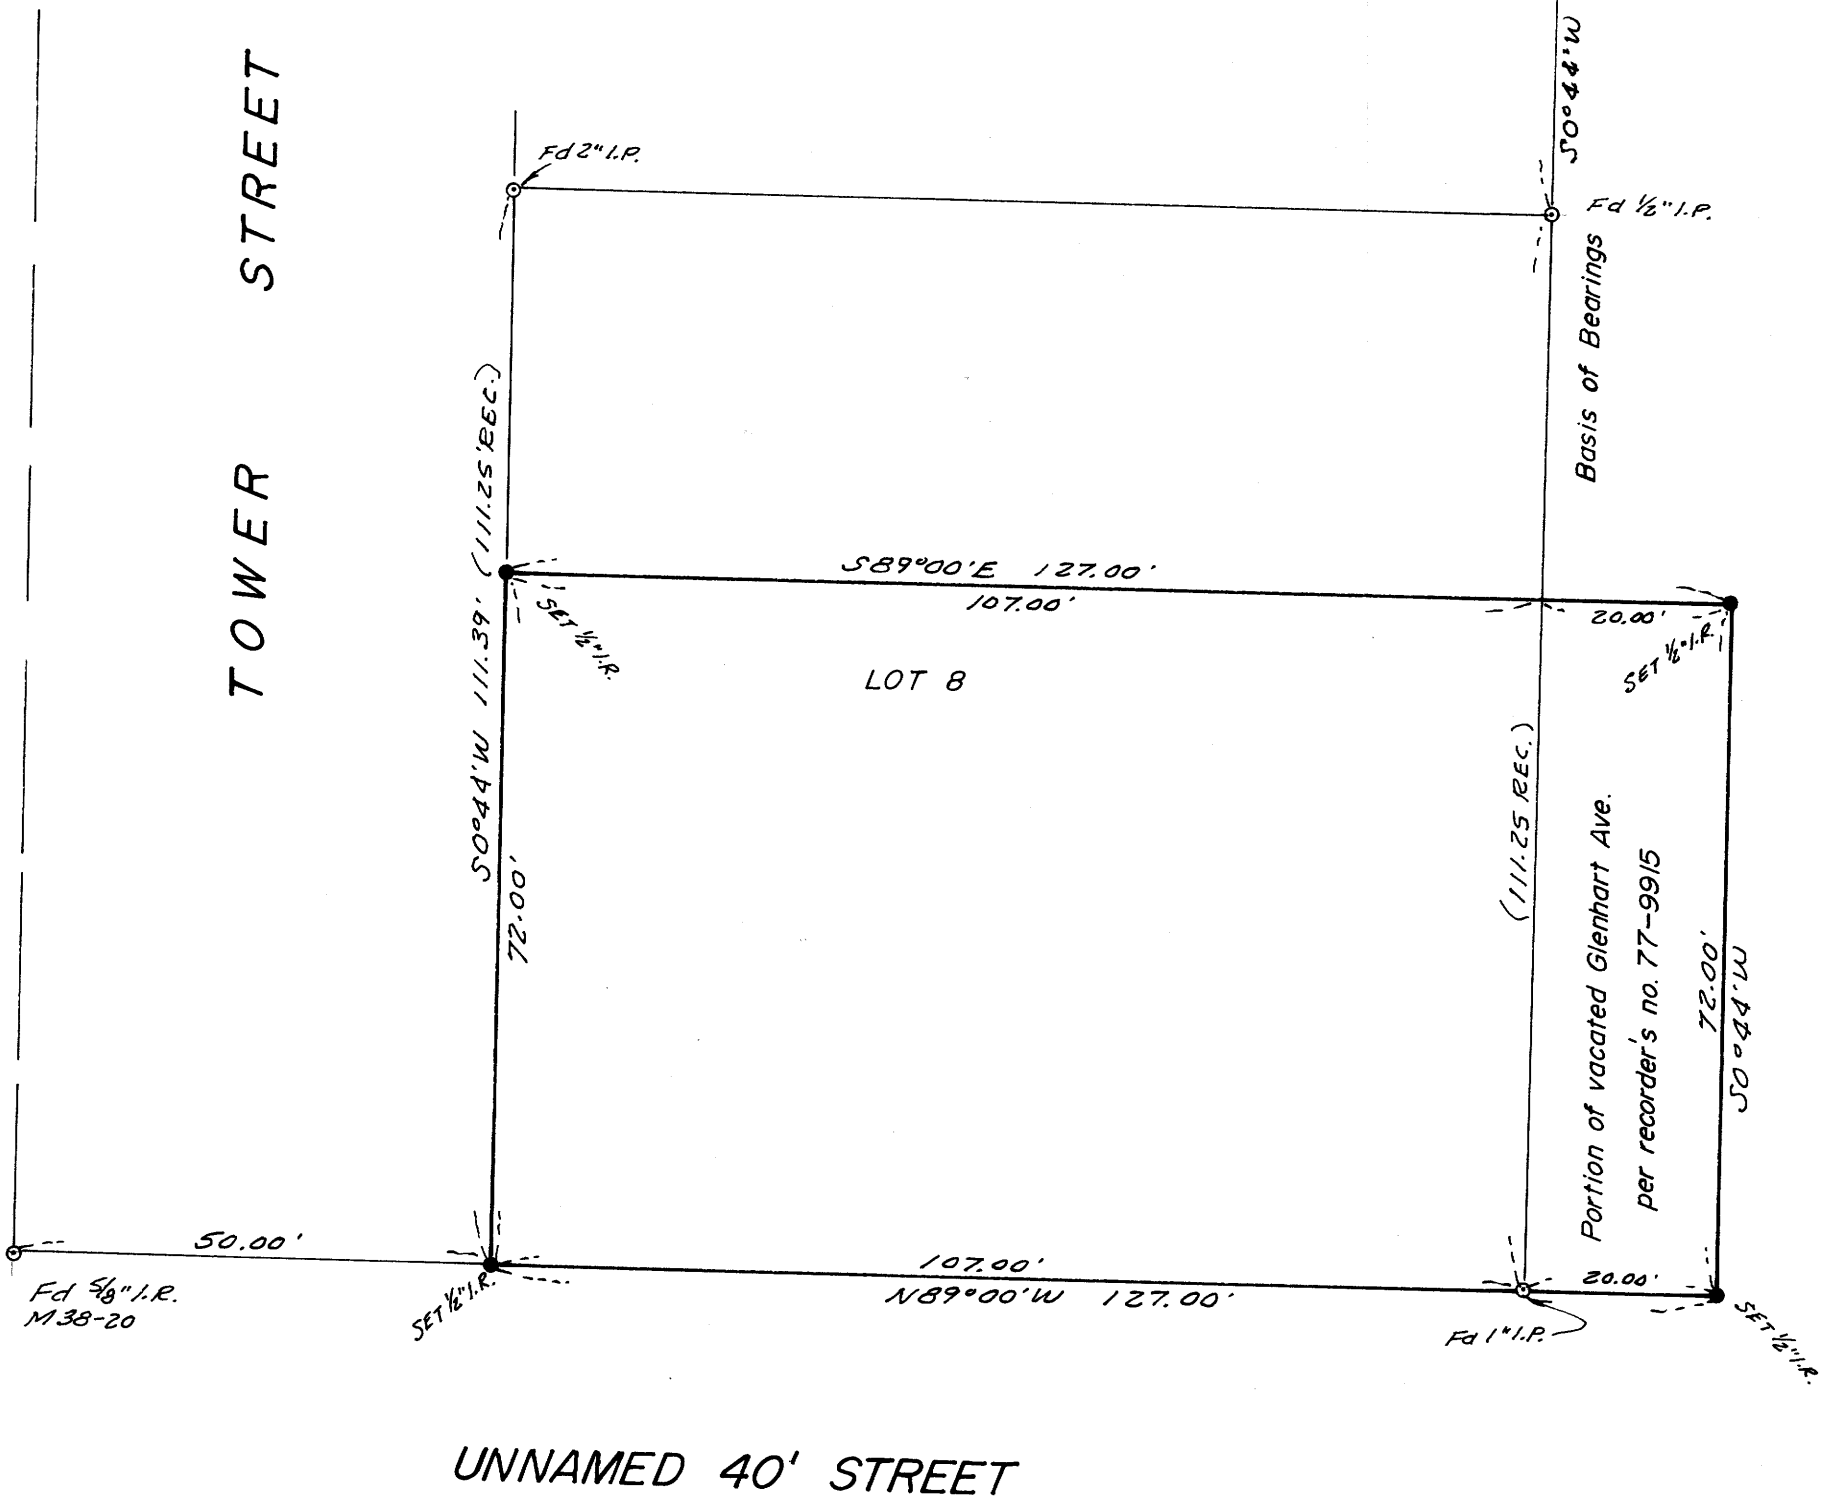

UNNAMED 40' STREET