


COUNTY SURVEYORS FILE DATA
DO NOT REMOVE FROM OFFICE

FILED *JHW*
RECEIVED

JAN 5 1979

COUNTY SURVEYOR
DOUGLAS COUNTY, ORE.
TB

MAP FILE M 74 - 76

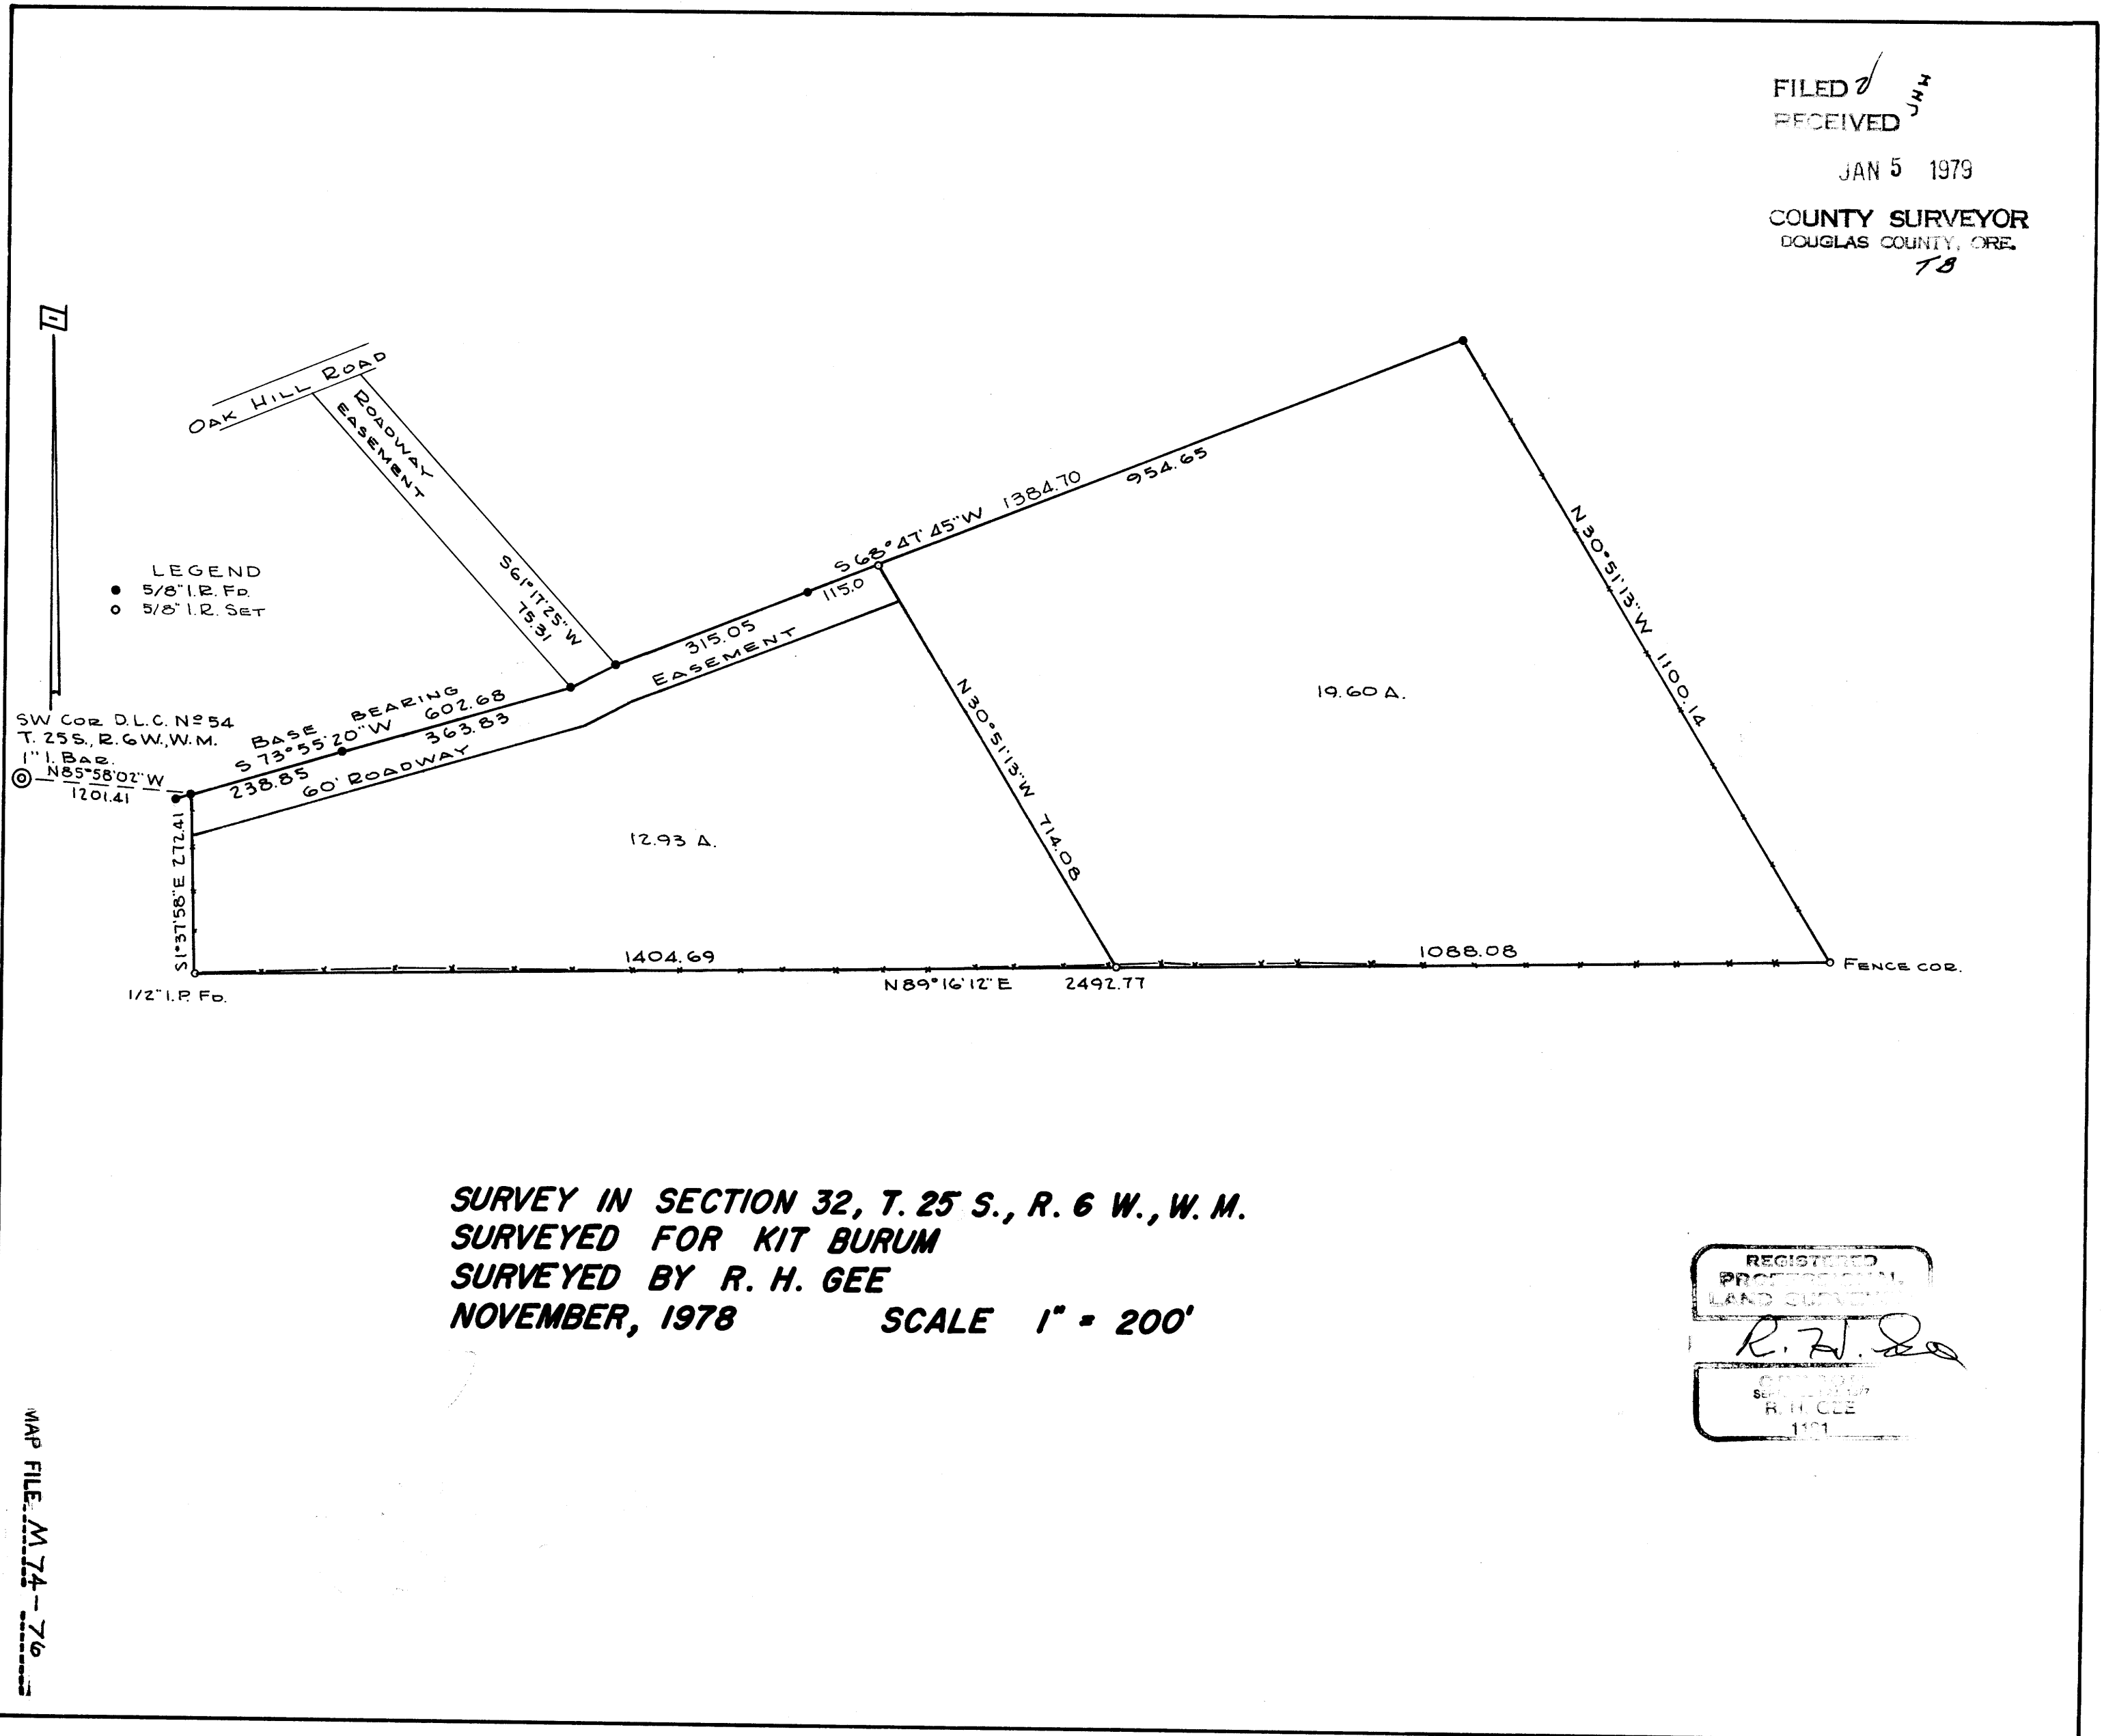

MAP FILE M 74 - 76