



SURVEY IN BLOCK 2, AMENDED PLAT OF DIXONS ADD. TO FRUITVALE.

SEC. 12, T 27 S, R 6 W. W.M.

SURVEYED FOR - BUZZ DESBIENS
SURVEYED BY - W.S. BARNES

COUNTY SURVEYORS FILE DATA
DO NOT REMOVE FROM OFFICE

OCT. 1978
SCALE 1" = 40'

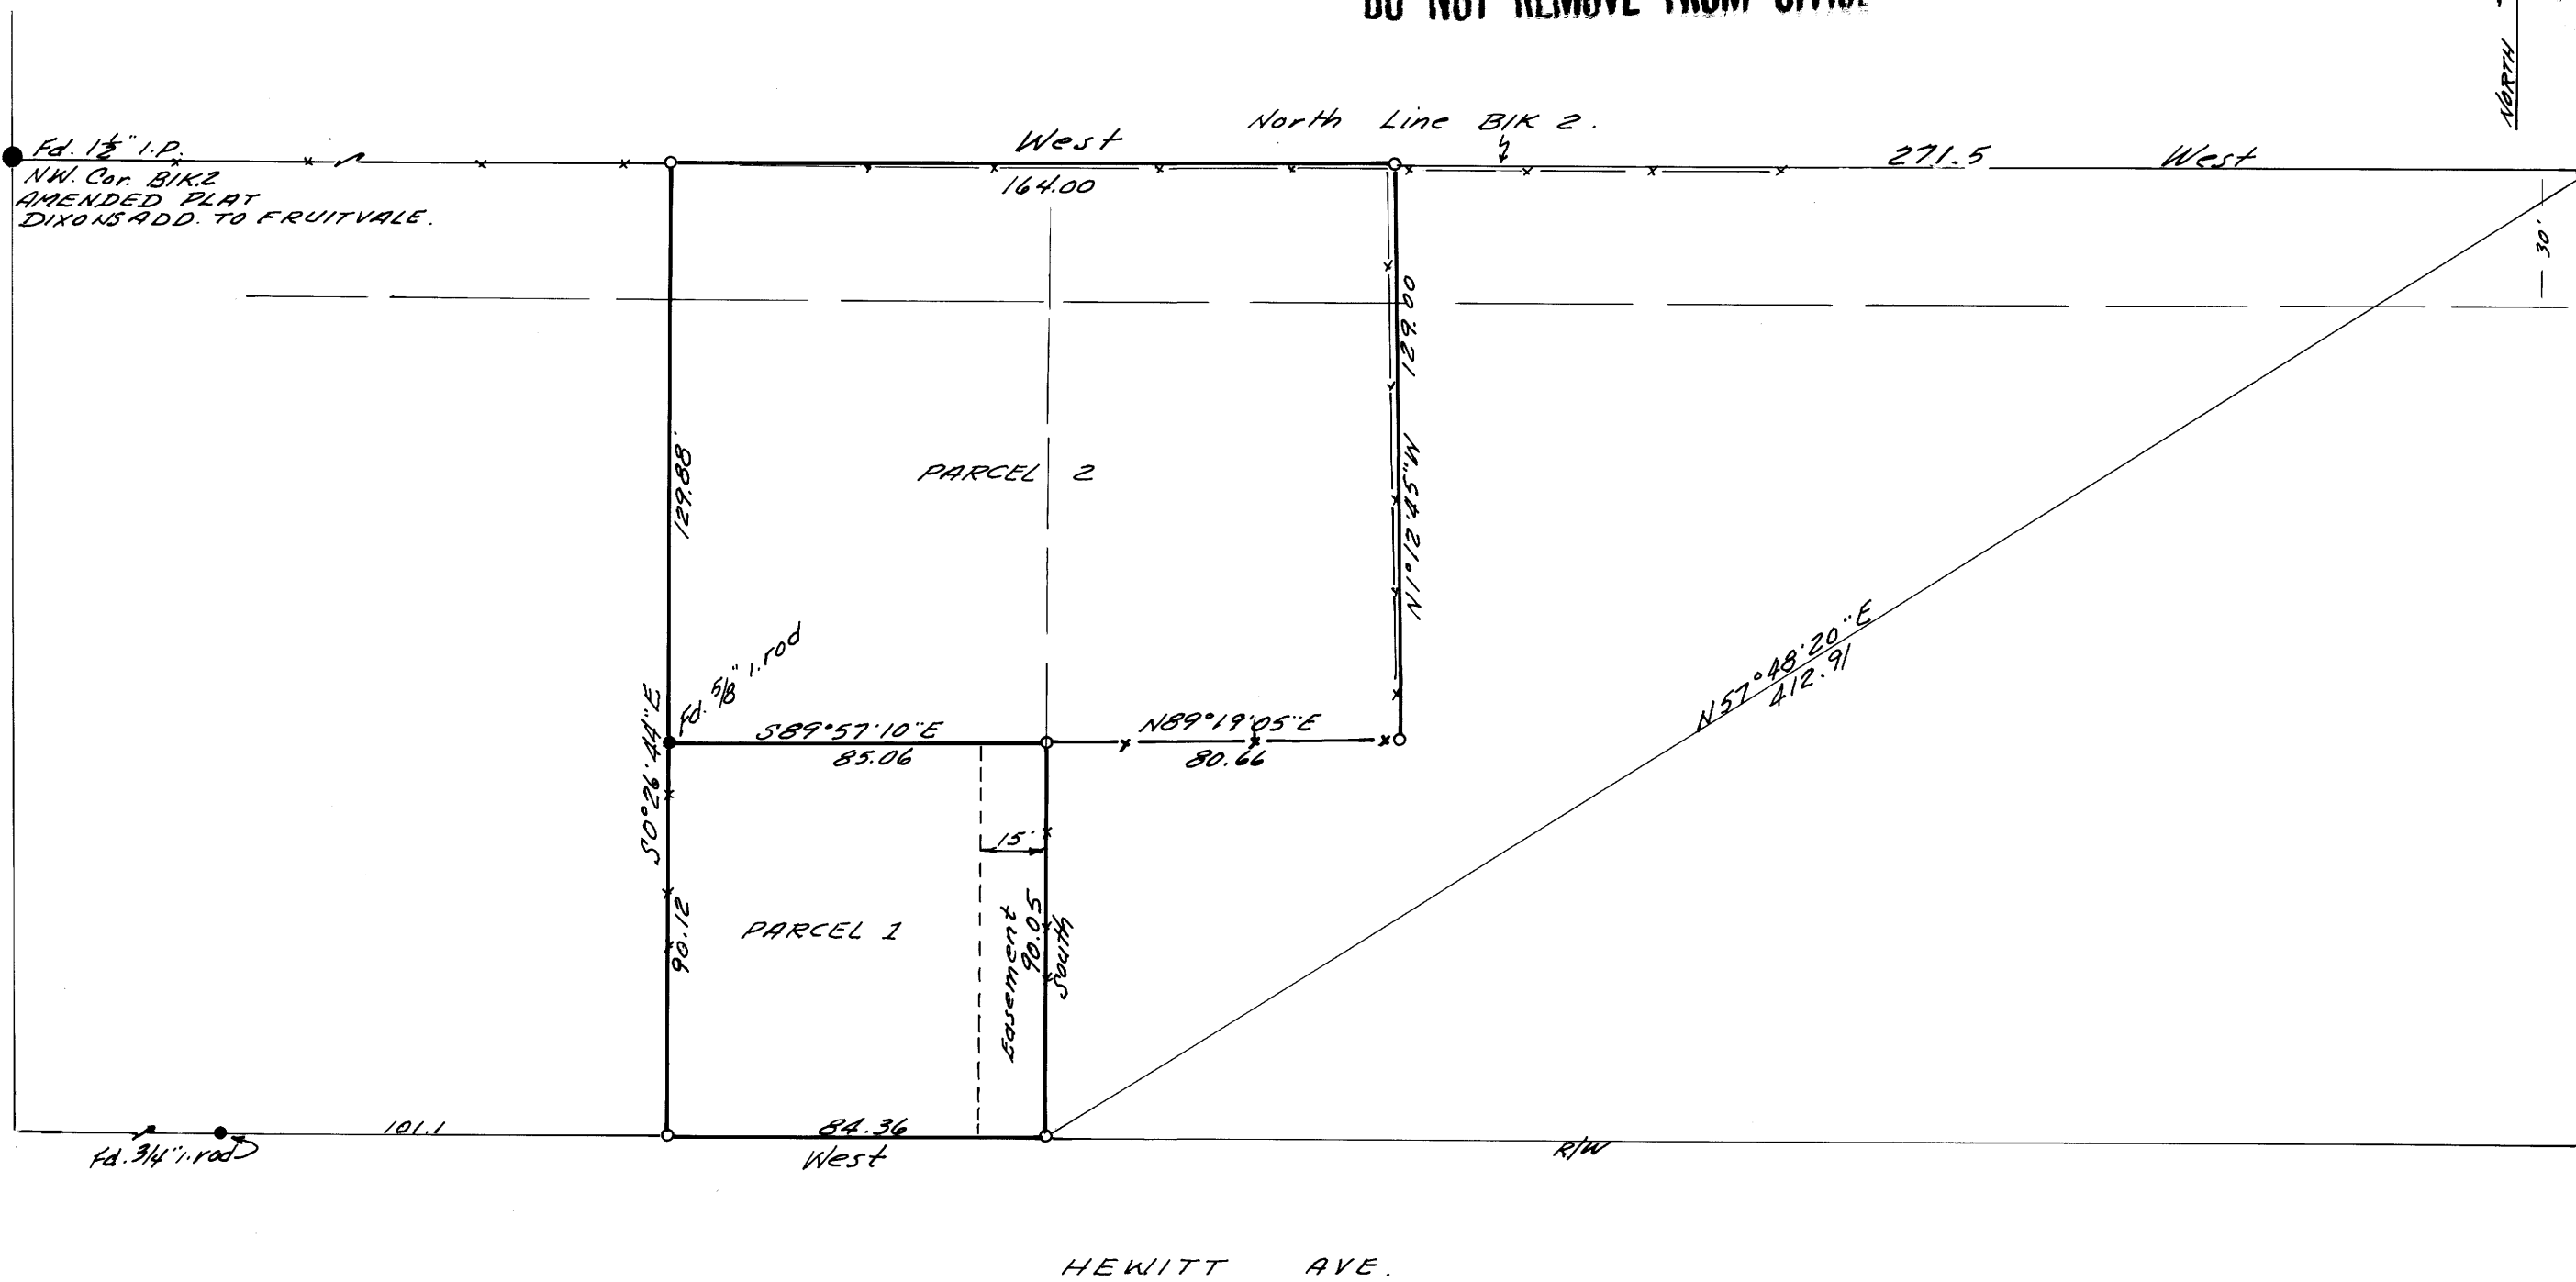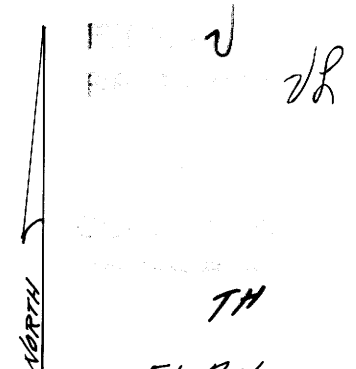

Fd. 1 1/2" I.P.
NW. Cor. BIK 2
AMENDED PLAT
DIXONS ADD. TO FRUITVALE.

Fd. Axis
N.E. Cor. BIK. 2
AMENDED PLAT
DIXONS ADD.
TO FRUITVALE

M 77-9

N.E. STEPHENS ST.

KERR ST.

HEWITT AVE.

o Denotes 5/8" rods set.

REGISTERED
PROFESSIONAL
LAND SURVEYOR

W.S. Barnes

OREGON
SEPT. 20, 1977
WILLIAM S. BARNES
1931

MAP NO. M77-9