

SURVEY FOR PROPERTY CORNERS

IN LOT 15 BLOCK 2 PLAT C, SUTHERLIN LAND & WATER CO.
SECTION 20, T.25S. R.5W.W.M.— JANUARY 1979— SCALE: 1"=100'

FOR: HOLIDAY BUILDERS
BY: BAUGHMAN TECHNICAL SERVICES INC.

COUNTY SURVEYORS FILE DATA
DO NOT REMOVE FROM OFFICE

FILED *d*
RECEIVED *dh*


JAN 11 1979

COUNTY SURVEYOR
DOUGLAS COUNTY, ORE.
TH

REGISTERED
PROFESSIONAL
LAND SURVEYOR

Glenn S. Baughman

OREGON
GLENN S. BAUGHMAN
536

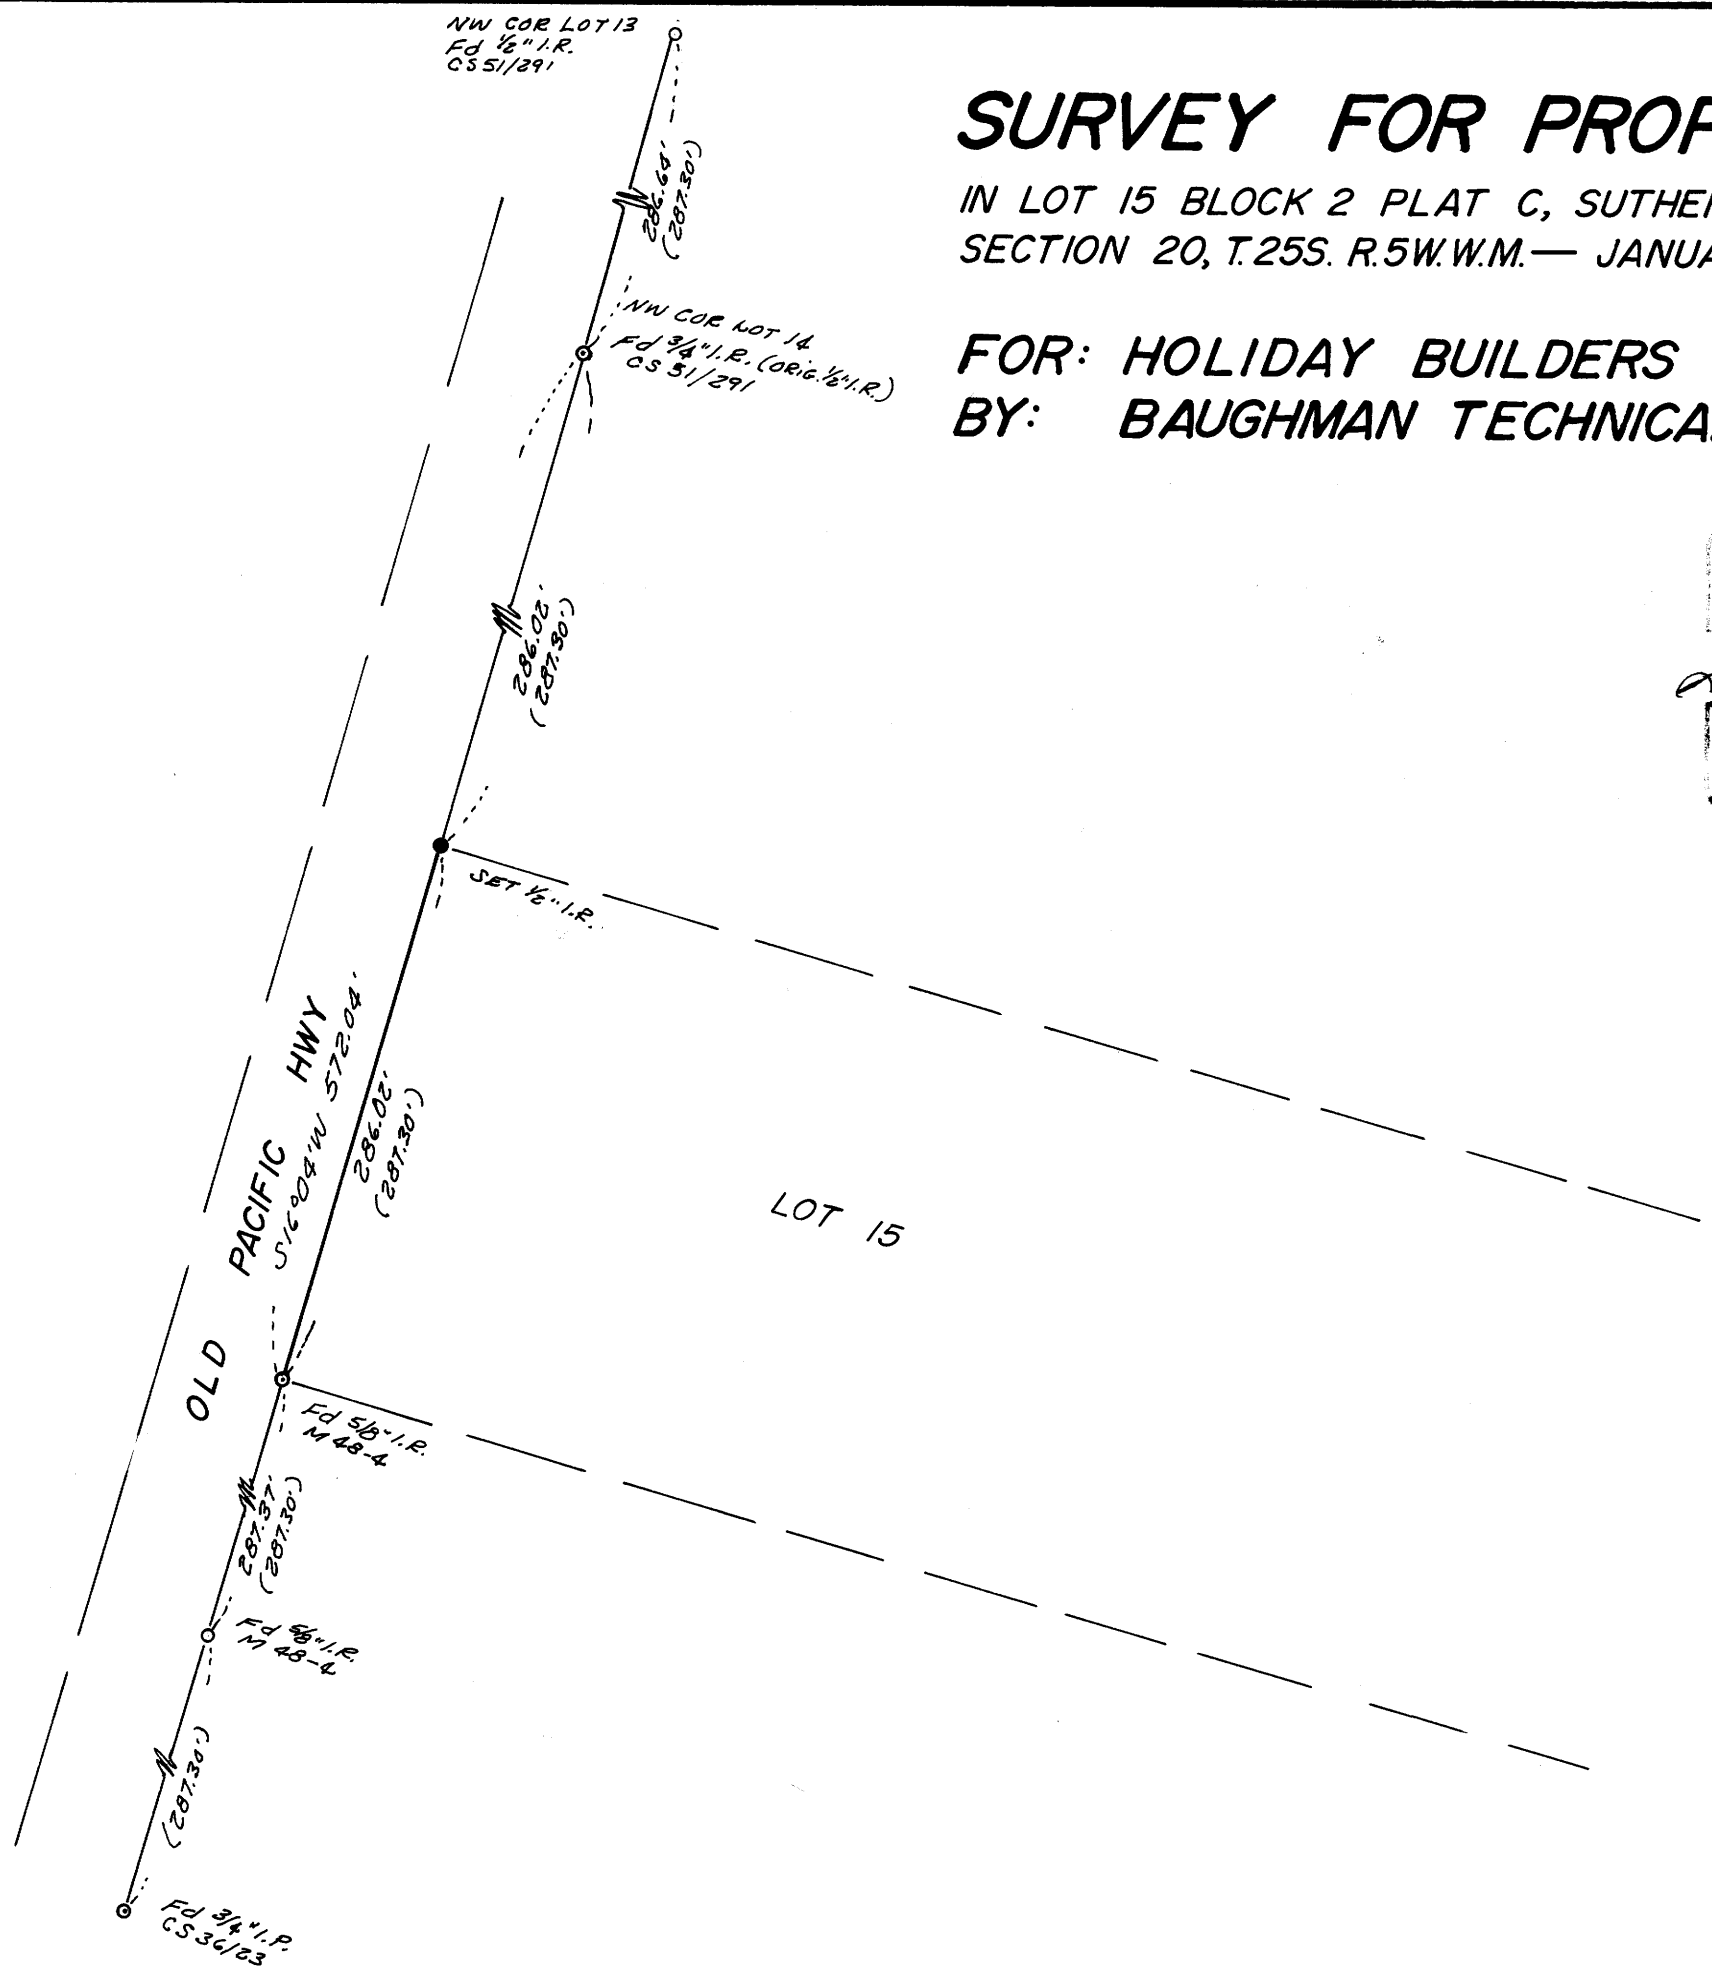

MAP FILE M 75-1

MAP FILE M 75-1