

# SURVEY FOR DESCRIPTION

IN LOT 9 DEER CREEK ORCHARD TRACTS, PLAT A-SEC. 14 T27S.R.5W.W.M.

FOR: STARNES BROS.  
BY: BAUGHMAN TECHNICAL SERVICES INC.

JANUARY 1979

SCALE: 1"=50'

REGISTERED  
PROFESSIONAL  
LAND SURVEYOR

*Glenn S. Baughman*


OREGON  
JULY 14, 1981  
GLENN S. BAUGHMAN  
536

FILED  
RECEIVED TB

JAN 21 1979

COUNTY SURVEYOR  
CLATSOP COUNTY, ORE.  
TB

MAP FILE M 75-12

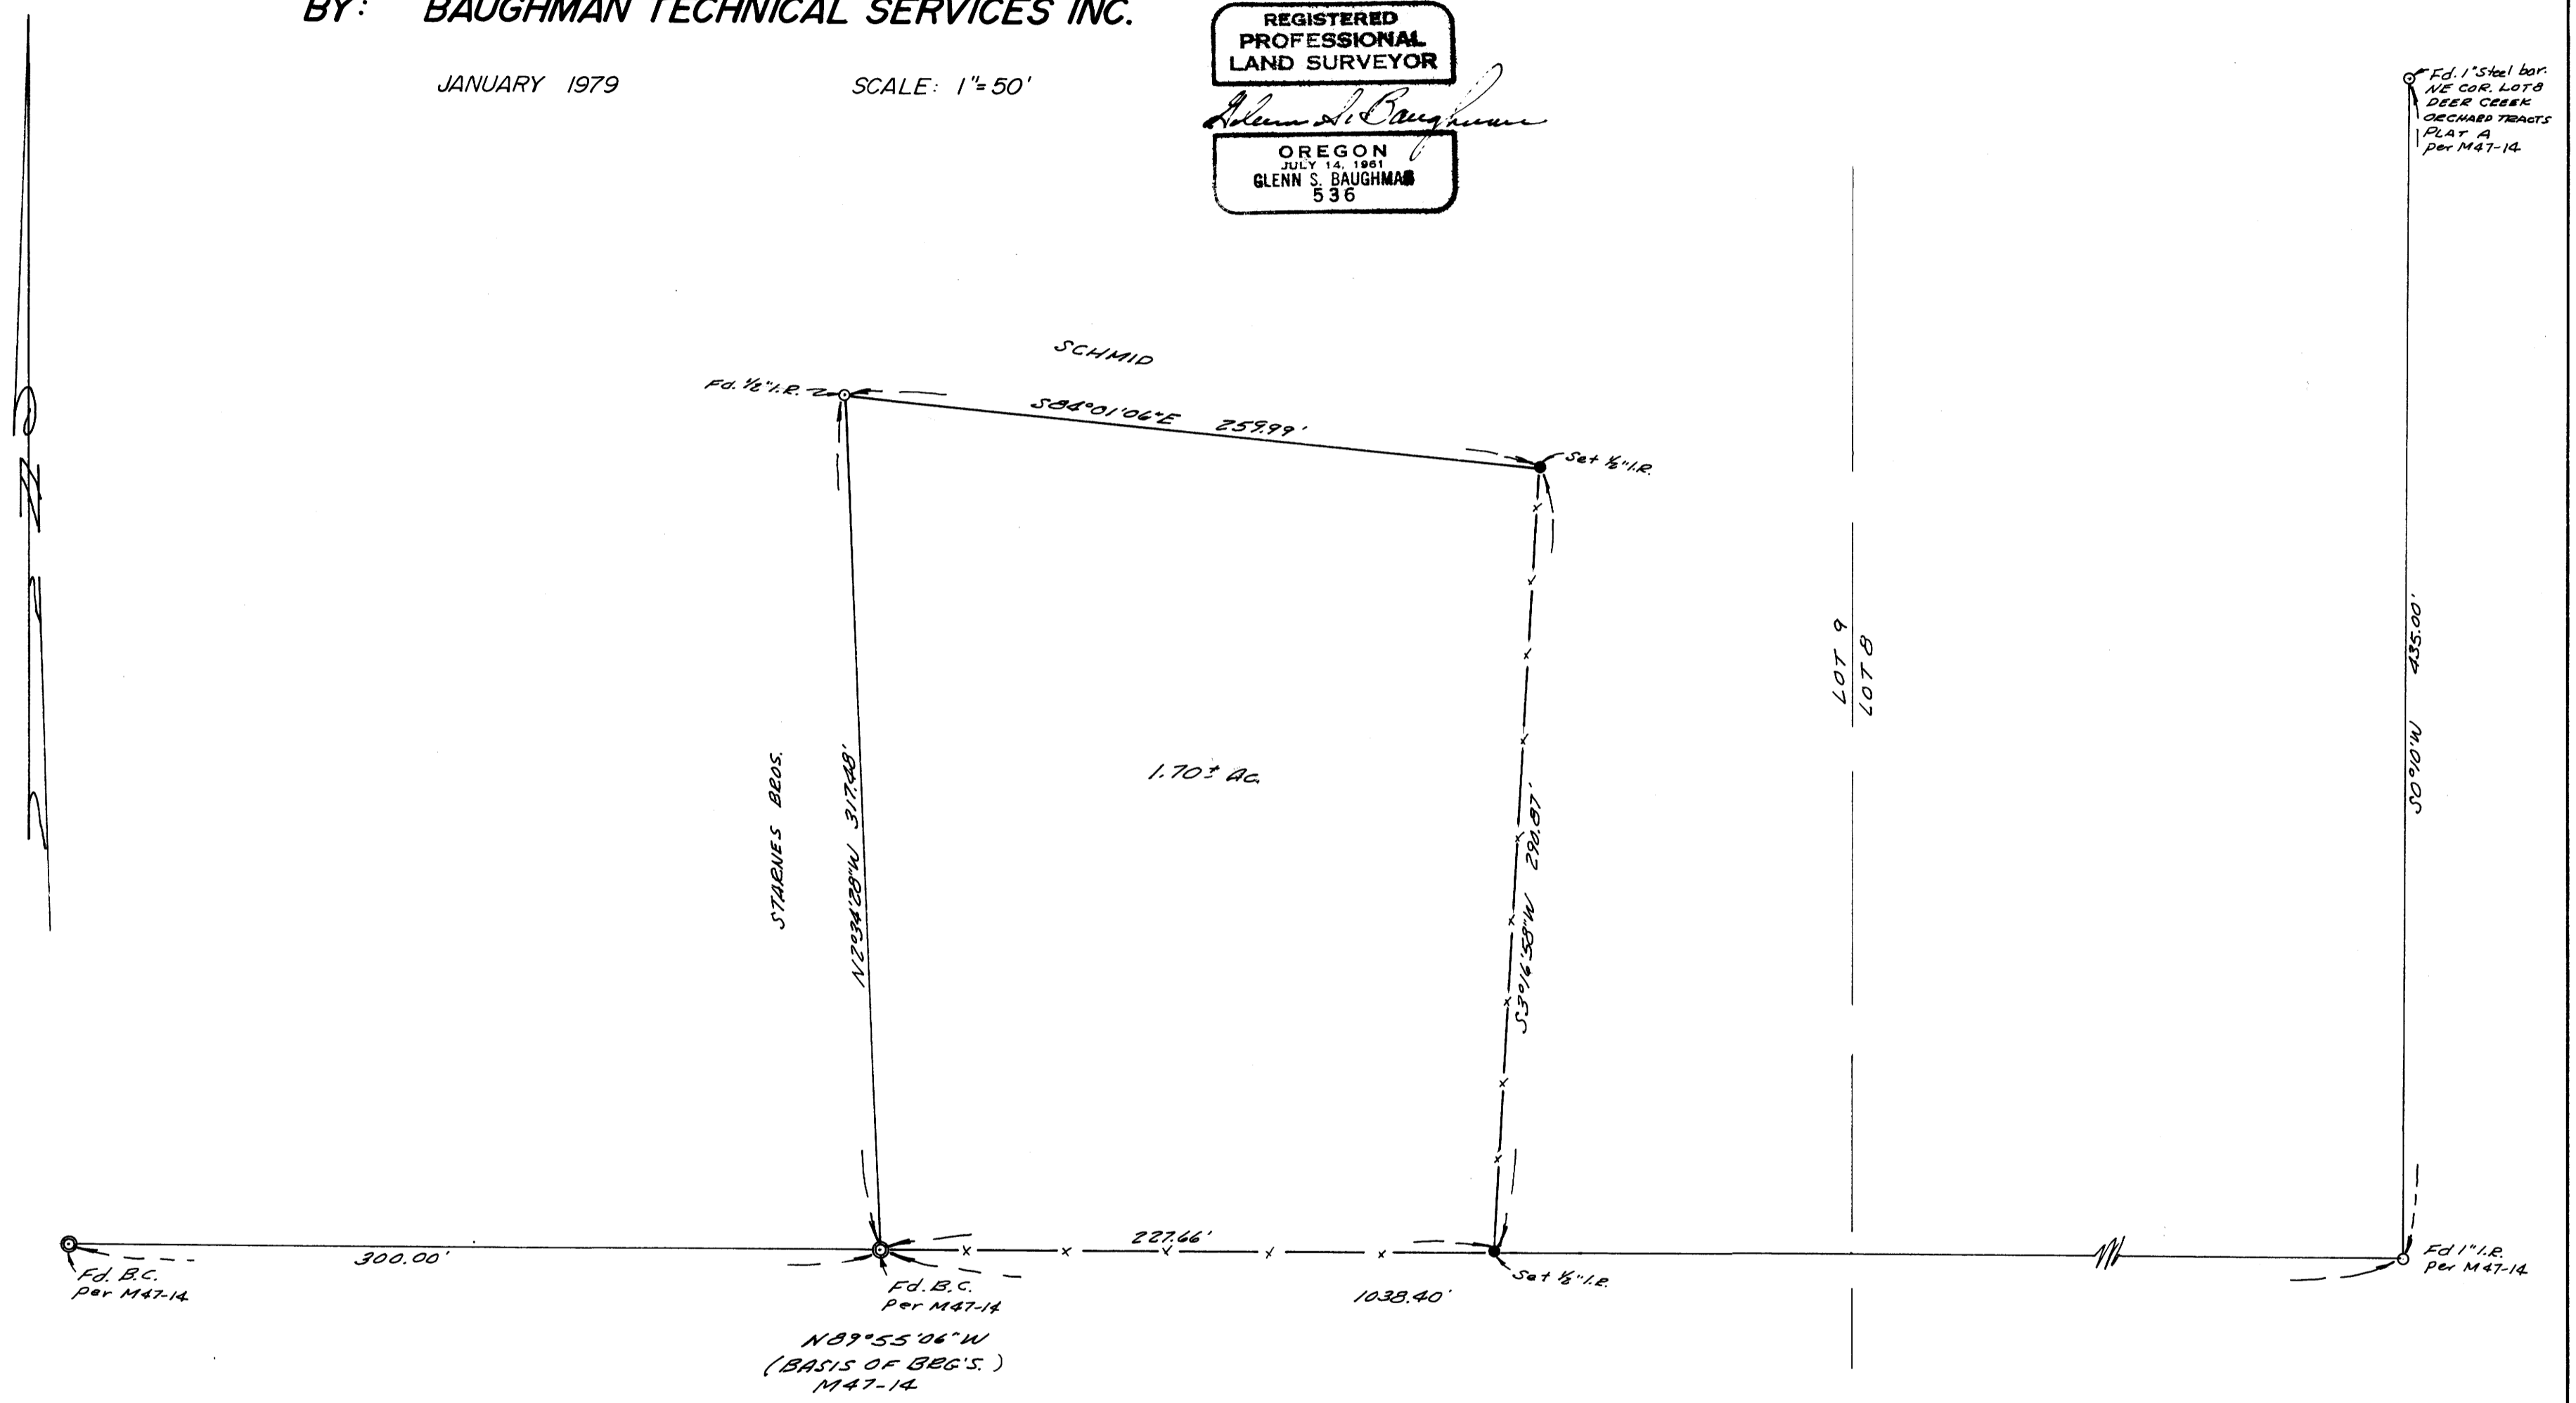

MAP FILE M 75-12

FM 3-76