

MAJOR LAND PARTITION

IN
S.W. 1/4, N.W. 1/4, SEC 4, T. 33 S., R. 6 W., WM. DOUGLAS CO. OREGON

COUNTY SURVEYORS FILE DATA
DO NOT REMOVE FROM OFFICE

FILED JHH

COUNTY SURVEYOR
18

REGISTERED
PROFESSIONAL
LAND SURVEYOR
Harold V. Stackhouse
JREED
HAROLD V. STACKHOUSE
1981


FOR: VERNON L. GENETT

BY: H.S. SURVEYING

OCT. to DEC. 1978

REFERENCES:

MAP FILE	M 58-15
" "	M 69-57
" "	M 49-21
C.S. FILE	55/256
" "	55/248
INST. NO.	77-15419
" "	313806
" "	66479
" "	78037
" "	75-16285
" "	206658
" "	343723
" "	72-10698

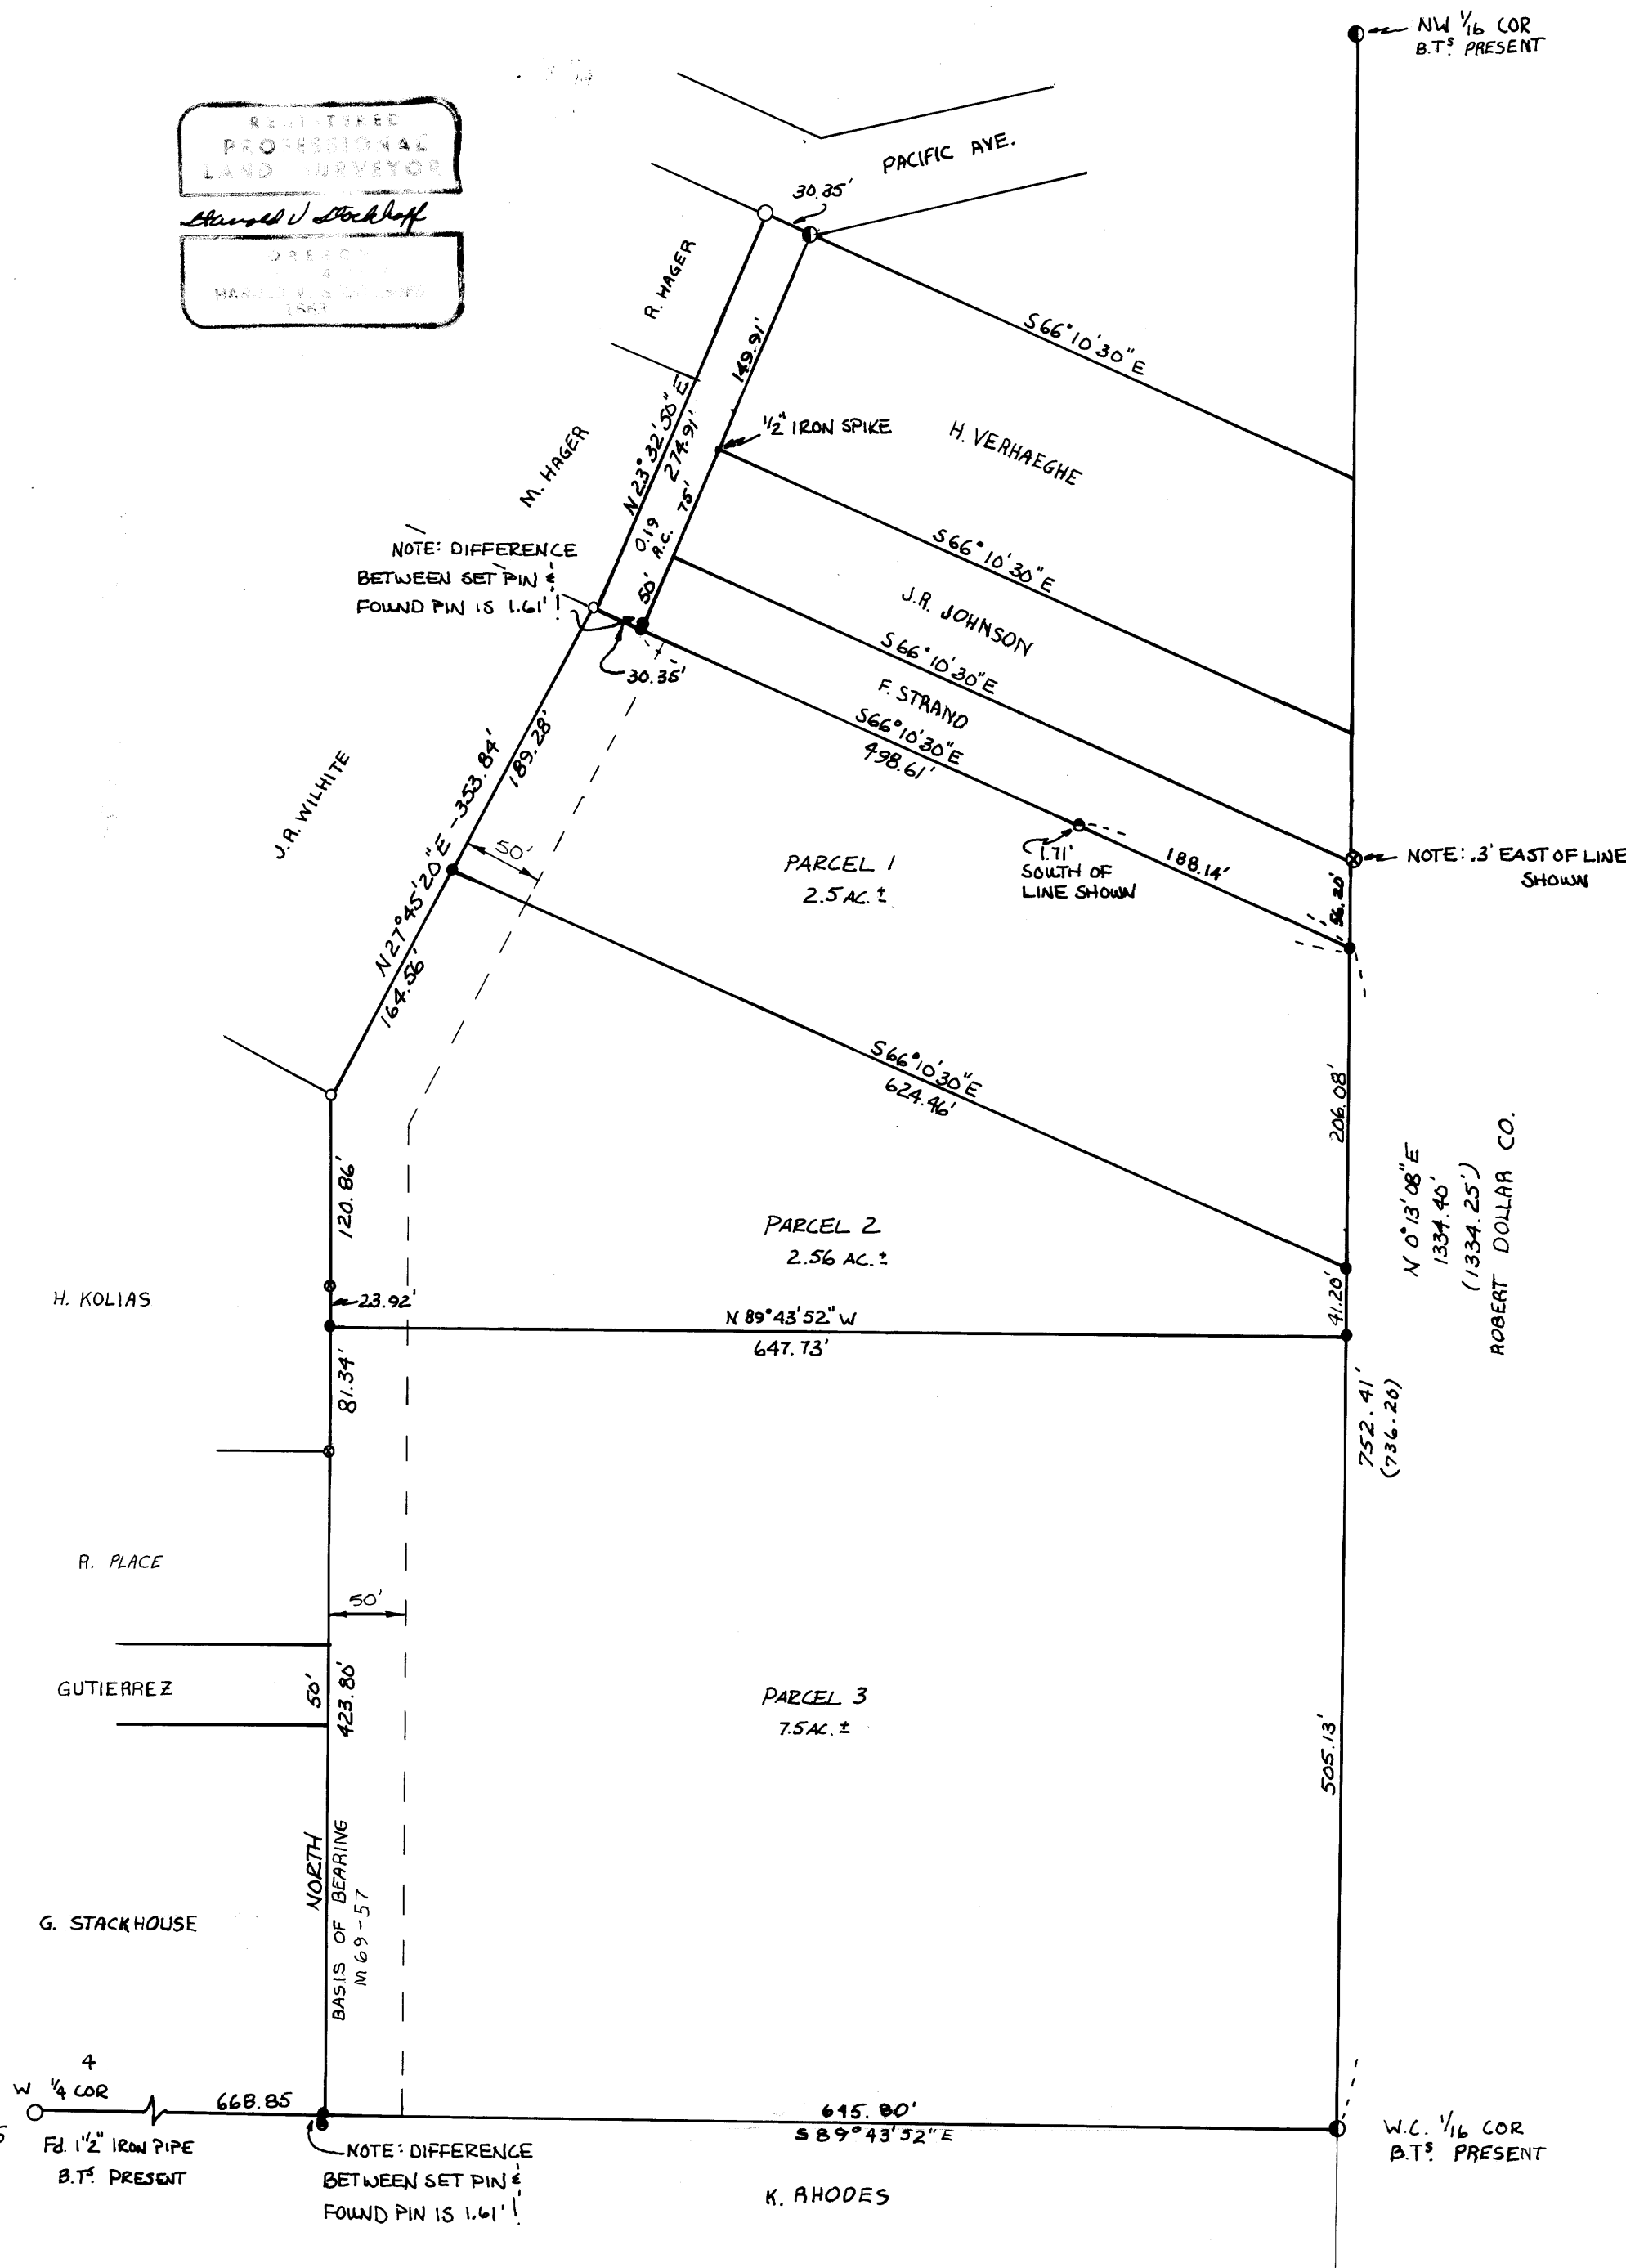

SCALE: 1" = 100'
LEGEND

- - Fd. 1/2" IRON PIPE
- - Fd. 3/4" IRON PIPE
- - SET 5/8" IRON ROD
- - Fd. 5/8" IRON ROD
- - Fd. 1" IRON ROD
- - Fd. 1 1/4" IRON PIPE
- ⊗ - Fd. SPIKE

Bl 4 19 65 B