


COUNTY SURVEYORS FILE DATA  
DO NOT REMOVE FROM OFFICE

**SURVEY TO ESTABLISH PROPERTY LINES FOR QUIT CLAIM DEEDS  
BETWEEN PROPERTIES DESCRIBED IN '68-12358 & '73-4581 IN SEC'S 33 & 34  
T.28S., R.7W., W.M., DOUGLAS CO., ORE. DATE - JAN, 1979  
FOR ISSAC & BETTY JAMES  
ST. RT. BOX  
WINSTON, ORE., 97496**

MAP FILE M 75-23

PL 12  
COUNTY SURVEYOR  
DOUGLAS COUNTY, ORE.  
T&TP

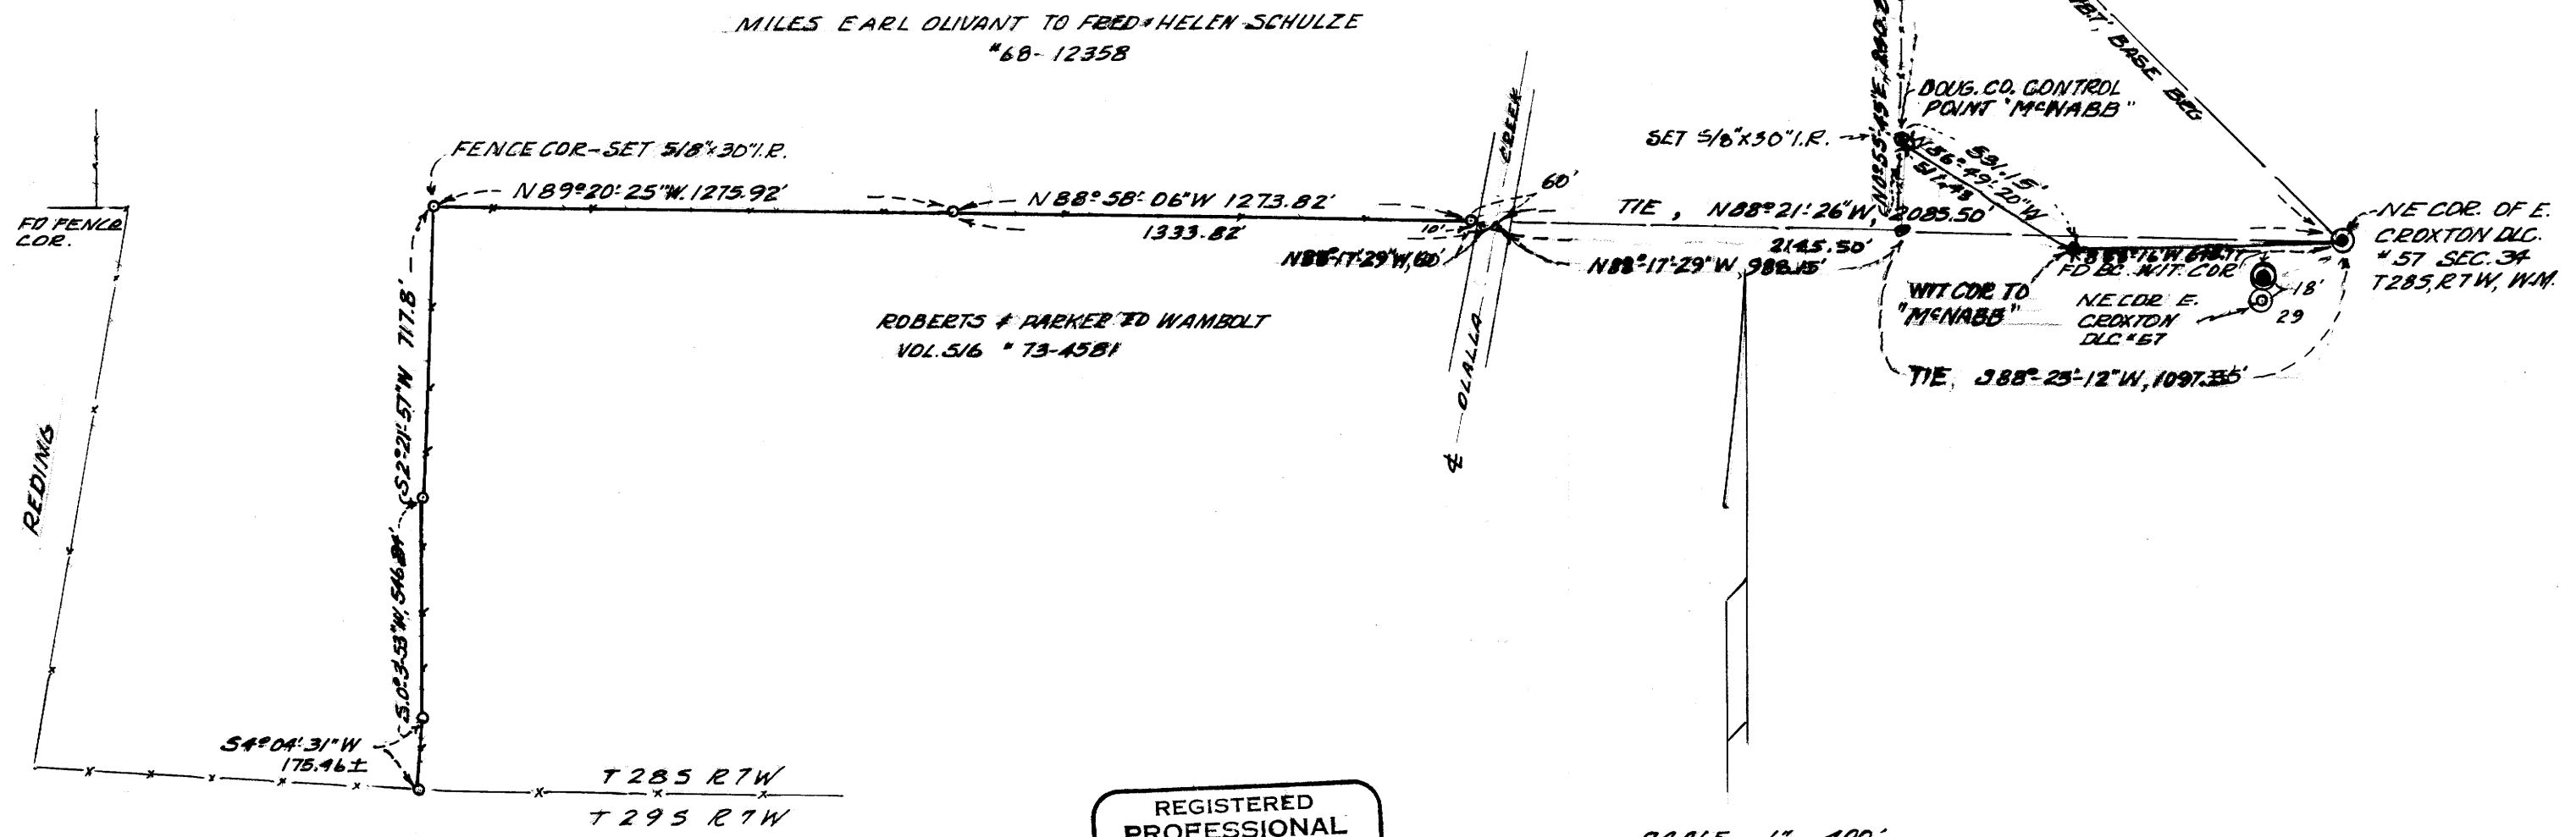

REGISTERED  
PROFESSIONAL  
LAND SURVEYOR

*Herbert L. Northcraft*

OREGON  
JULY 8, 1963  
HERBERT L. NORTHCRAFT  
750

SCALE 1" = 400'  
BASED ON SURVEY OF  
602/183 FOR BOB & ROBERTA JAMES 1969

- 5/8" x 30" I.R. SET
  - FD 5/8" I.E.
  - ⊕ BC DOUG. CO. CONTROL PT "MCNABB"
- TIE TO "MCNABB" & OTHER MEAS. BETWEEN PLC  
AND CREEK ADDED 2/2/78 H.R.Z.

MAP FILE M 75-23