


COUNTY SURVEYORS FILE DATA
DO NOT REMOVE FROM OFFICE

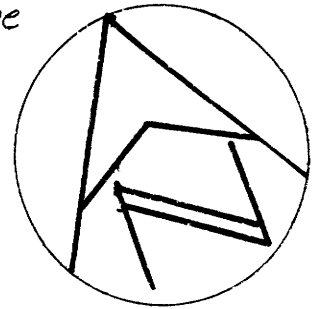

SCALE 1"=60'

LEGEND

- Set 5/8" I.R.
- ⊙ Fd. Mon.

FILED *✓*
RECEIVED *✓*

APR 9 1979

COUNTY SURVEYOR
DOUGLAS COUNTY, ORE.

TB

R=70.00'
Δ=39°00'
L.C.=577°02'30"W
46.73'

BASIS OF BEARING
577°56'45"W
298.75'
N83°27'30"W
114.99'

Fd. 3/4" I.P. See County Survey #58/7

R=130.00'
Δ=13°23'12"
L.C.=589°50'54"W
30.30'

SOUTH 50°38'51"
S34°16'30"W 85.34'

S34°16'30"W 137.23'

S41°46'30"W 137.00'

Δ=7°30'
R=70.0'
L=9.16'

S56°07'30"W 71.21'
N83°52'30"W 59.57'

P.O.B. Bears N86°08'39"E 2,740.81' from the
S.W. Cor. of Sec. 35, T.21S., R.12 W., W.M.

N19°42'W 450.28'

15.43' Fd. 3/4" I.P. Bears South 1.20' 569°18'30"E 474.97'
and 1.04' East of True Corner

PROPERTY SURVEY

FOR: RON SHEPHERD
A PARCEL OF LAND BEING A PORTION OF GOVERNMENT
LOT 7, SECTION 2, TOWNSHIP 22 SOUTH, RANGE 12 WEST,
W.M. AND THE SW 1/4 OF SECTION 35, TOWNSHIP 21 SOUTH,
RANGE 12 WEST, W.M., DOUGLAS COUNTY, OREGON
SCALE 1"=60'
3/19/79
K00S ENGINEERING 2561 BROADWAY NORTH BEND, ORE.

REGISTERED
PROFESSIONAL
LAND SURVEYOR

J. Gregory Solarz

OREGON
SEPTEMBER 23, 1977
J. GREGORY SOLARZ
1331

MAP FILE M.76-35

MAP FILE M.76-35