

COUNTY SURVEYORS FILE DATA  
DO NOT REMOVE FROM OFFICE

# GORDON BRUNTON SURVEY

FILED *vj*  
RECEIVED *kb*  
APR 20 1979  
COUNTY SURVEYOR  
LOUGLAS COUNTY, ORE.  
*w*

## SURVEY OF LOTS 1, 8 & PART OF 7 BLOCK 3, CITY OF DRAIN IN SECTION 8, T22S, R5W, W.M.

BY: BHW ENGINEERING & SURVEYING


APRIL 1979

SCALE: 1" = 50'

REGISTERED  
PROFESSIONAL  
LAND SURVEYOR

*Romanso E. Ware*

OREGON  
NOV. 16, 1973  
ROMANSO E. WARE  
1005

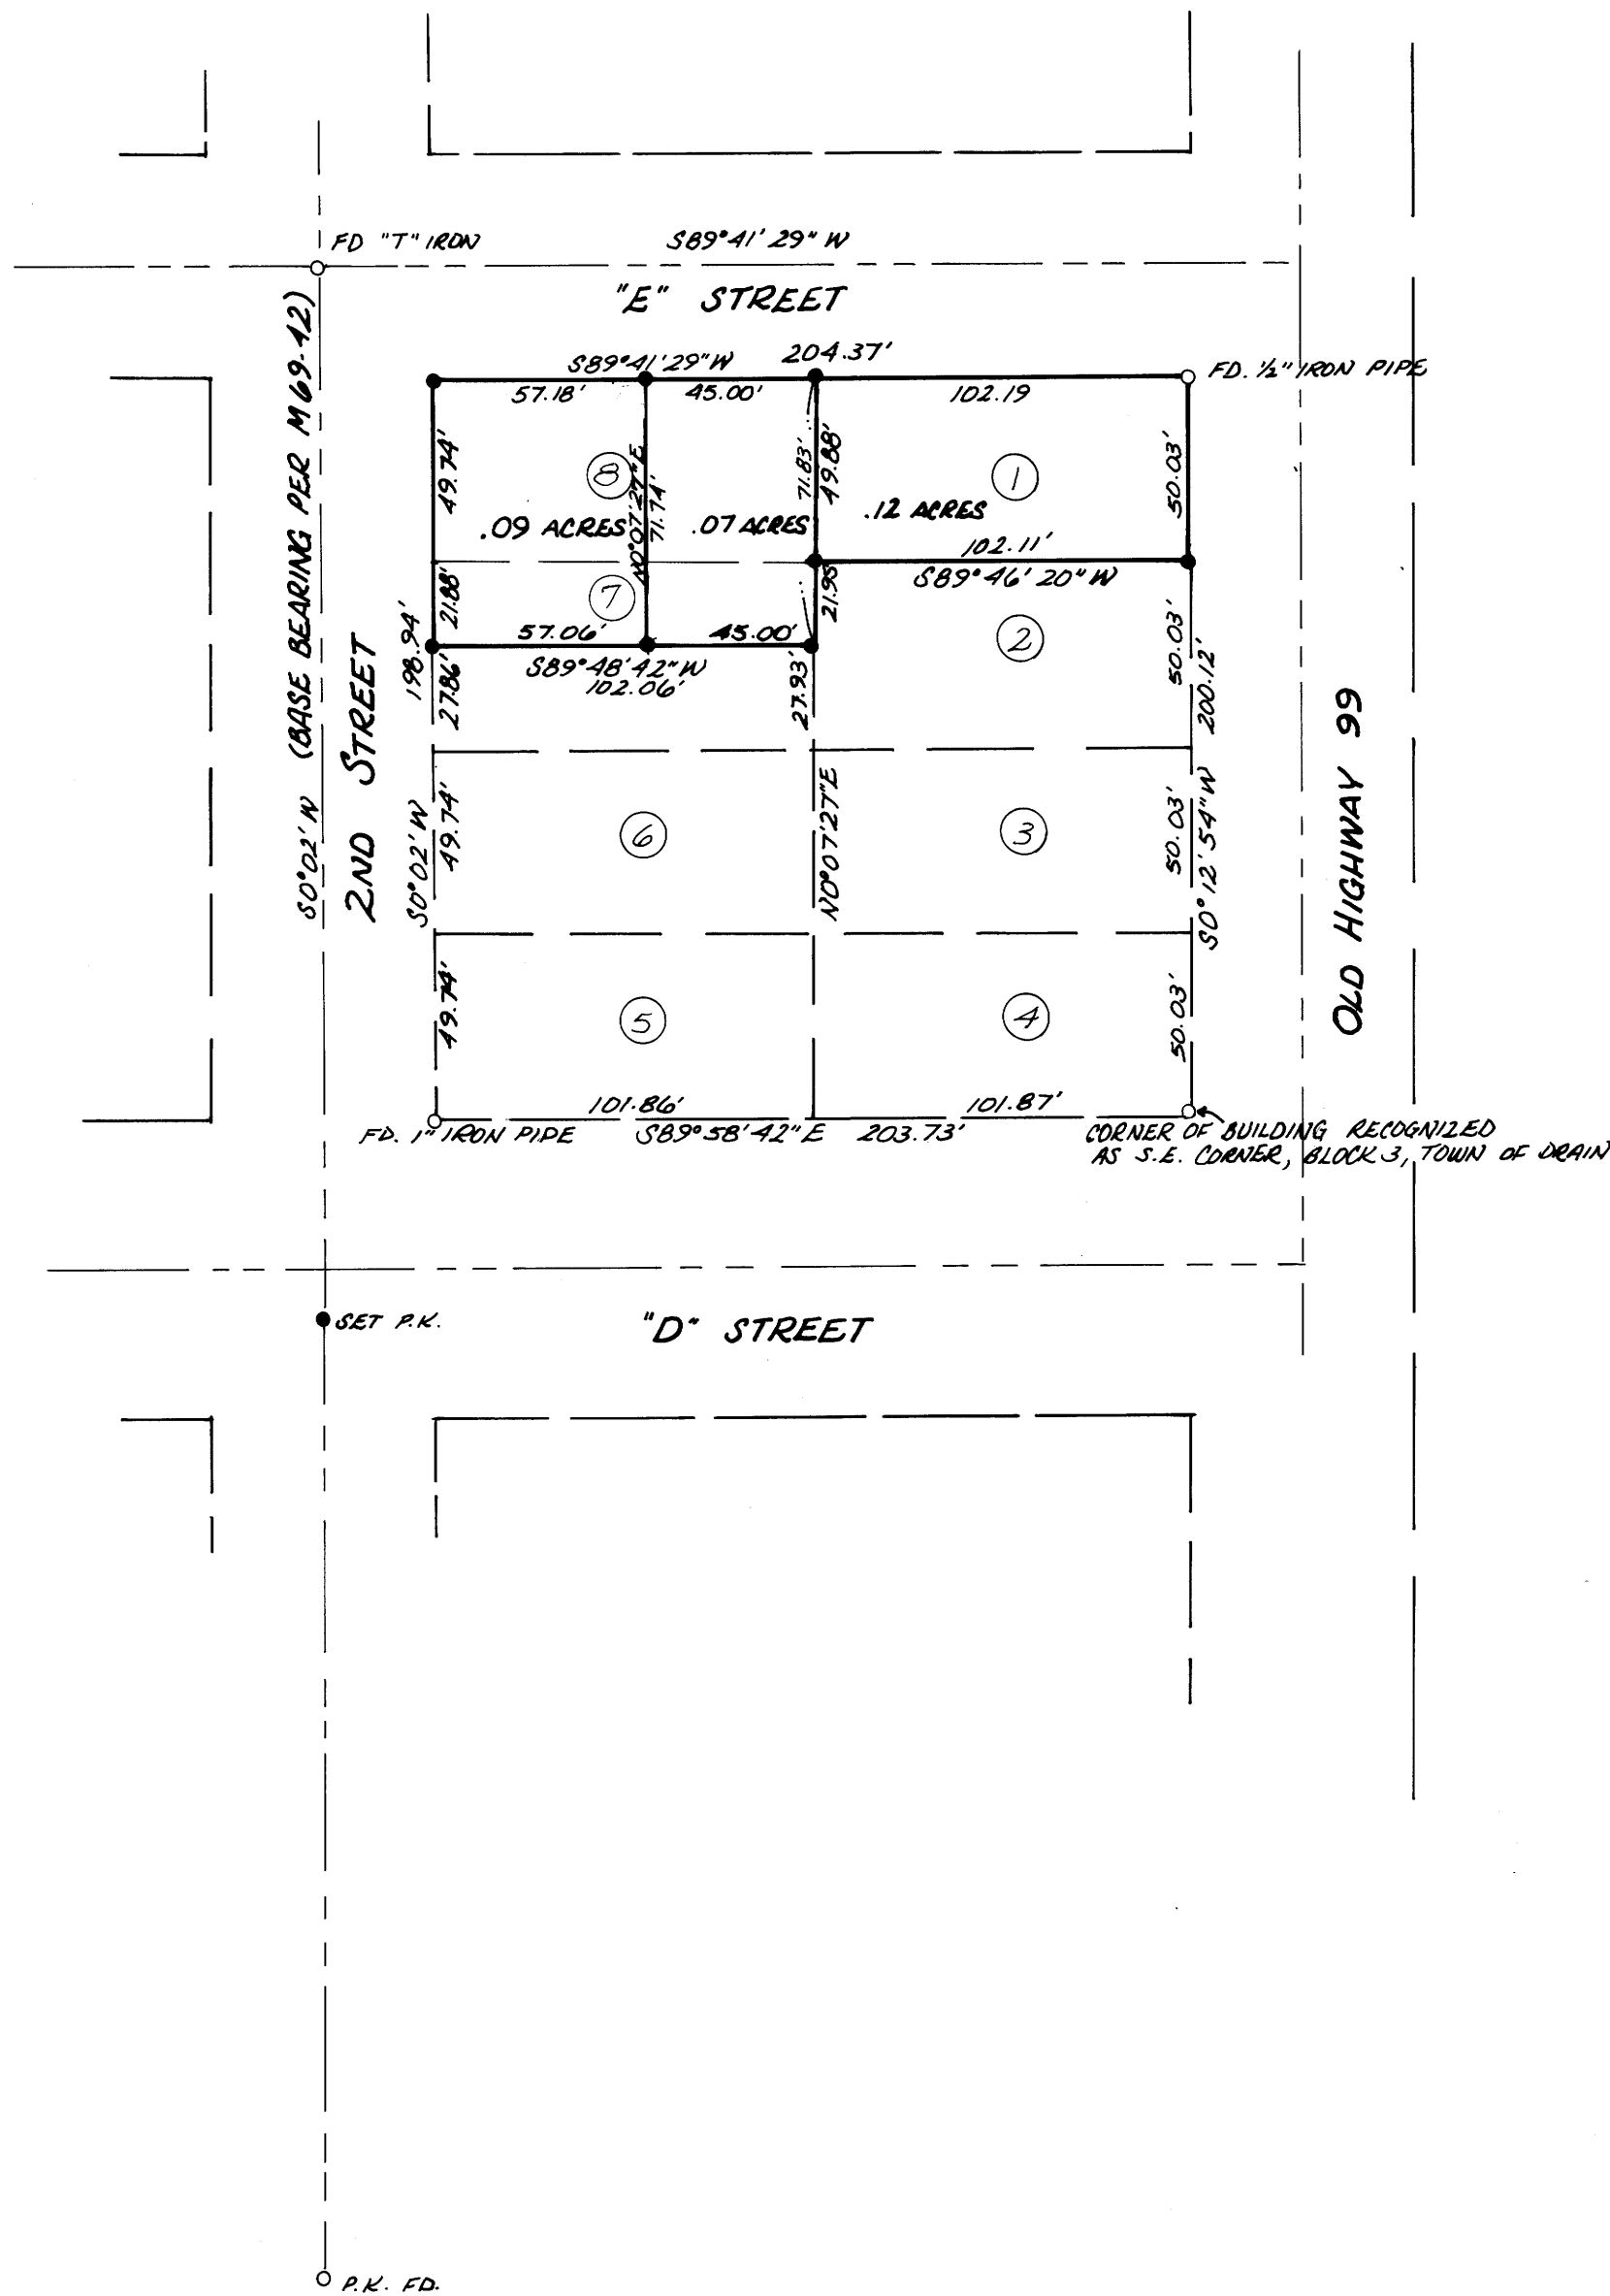

LEGEND

- - SET 5/8" IRON ROD
- - FOUND MONUMENT