

SURVEY TO ESTABLISH PROPERTY LINE

COUNTY SURVEYORS FILE DATA
DO NOT REMOVE FROM OFFICE

IN SECTION 32, T26S, R4W, W.M.

FOR: LUTHER ELLISON


BY: BHW ENGINEERING & SURVEYING

APRIL 1979

SCALE: 1" = 200'

FILED *d*
RECEIVED *KB*
APR 20 1979
COUNTY SURVEYOR
DOUGLAS COUNTY, ORE.
78

SEE ROLL MAP 3-15

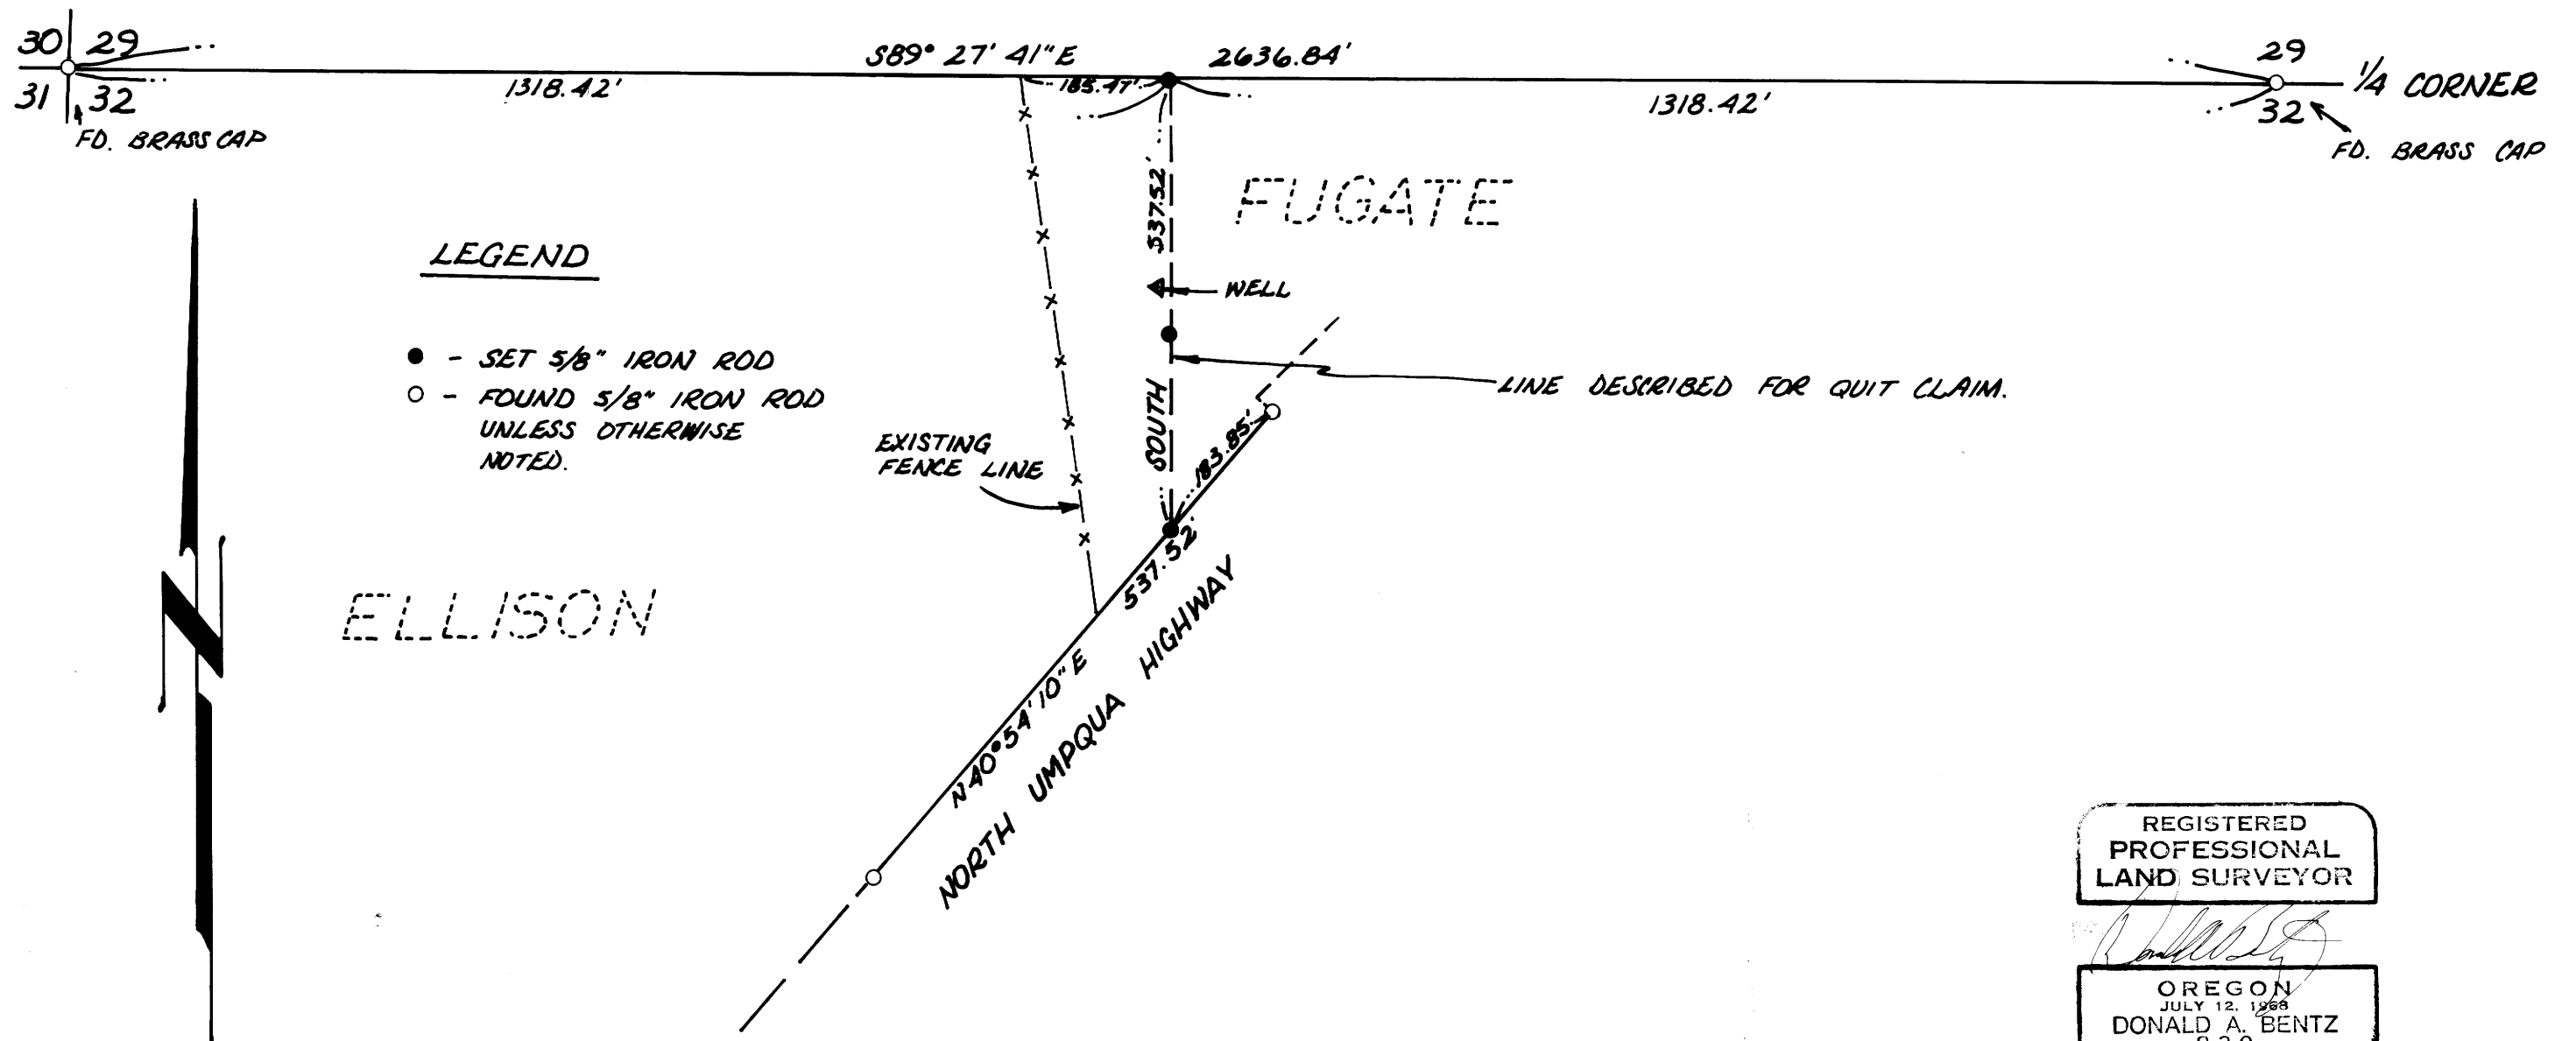

REGISTERED
PROFESSIONAL
LAND SURVEYOR

Donald A. Bentz
OREGON
JULY 12, 1968
DONALD A. BENTZ
839

MAP FILE M76-61