


COUNTY ROAD NO 24

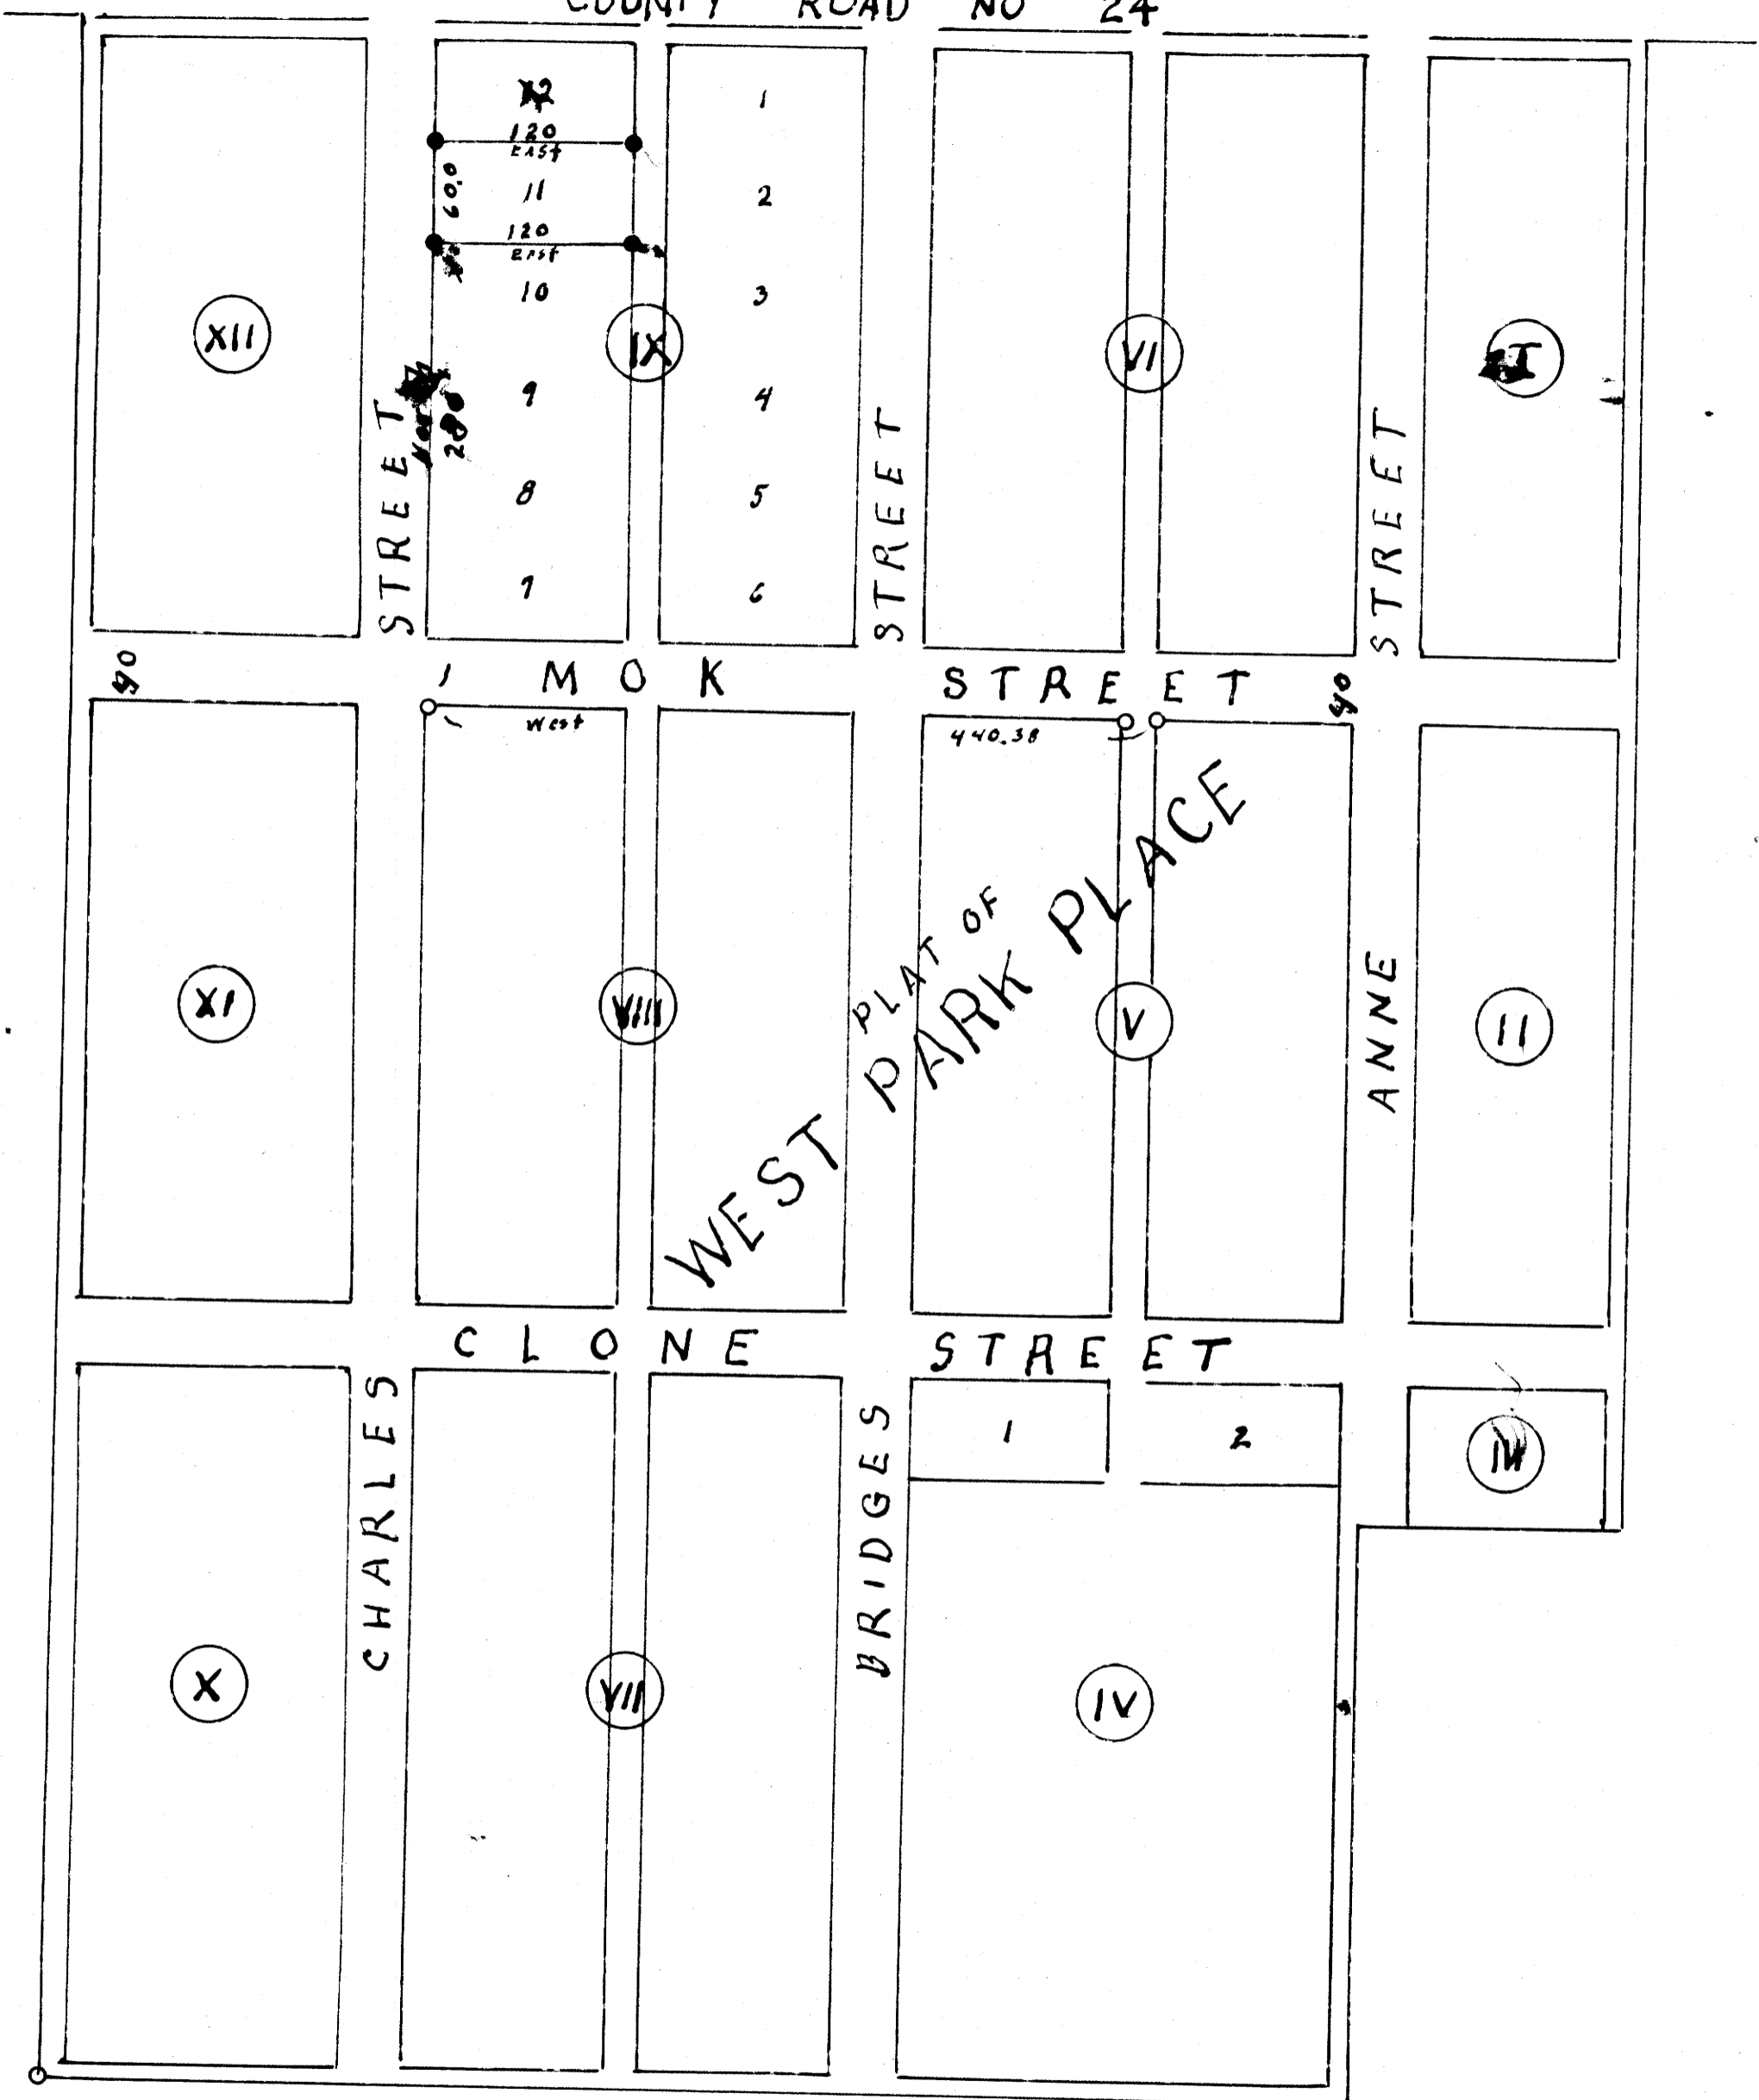

REGISTERED
OREGON
 LAND SURVEYOR
Wilford N. Haines
 MAY 7, 1948
 WILFORD N. HAINES
 239

FILED 1
 RECEIVED TB
 APR 30 1979
 COUNTY SURVEYOR
 CLATSOP COUNTY, ORE.
 TB

S.4, T.23S., R.5W. W.M.
 Scale 1"=100'
 April 24, 1979
 William Ramey phone 849 2487
 Rt. 1 Box 118 youcalla, Oregon

North ↑
 Based on original plat

- Set 5/8" Rebar
- Found iron pipe

COUNTY SURVEYORS FILE DATA
 DO NOT REMOVE FROM OFFICE

MAP FILE M 76-70

MAP FILE 76-70