


PROPERTY SURVEY IN A PORTION OF D.L.C. No. 37 & D.L.C. No. 46 IN SECTIONS 25 & 36, T27S, R7W, W.M. AND SECTIONS 30 & 31, T27S, R6W, W.M., DOUGLAS COUNTY, OREGON

JUNIOR SURVEYORS FILE DATA
DO NOT REMOVE FROM OFFICE

FOR: JOHN W. RESNER
BY: ROBERT L. DOLAN
DATE: APRIL 1979

FILED *d*
RECEIVED *JRL*
MAY 4 1979
COUNTY SURVEYOR
DOUGLAS COUNTY, OREGON
W

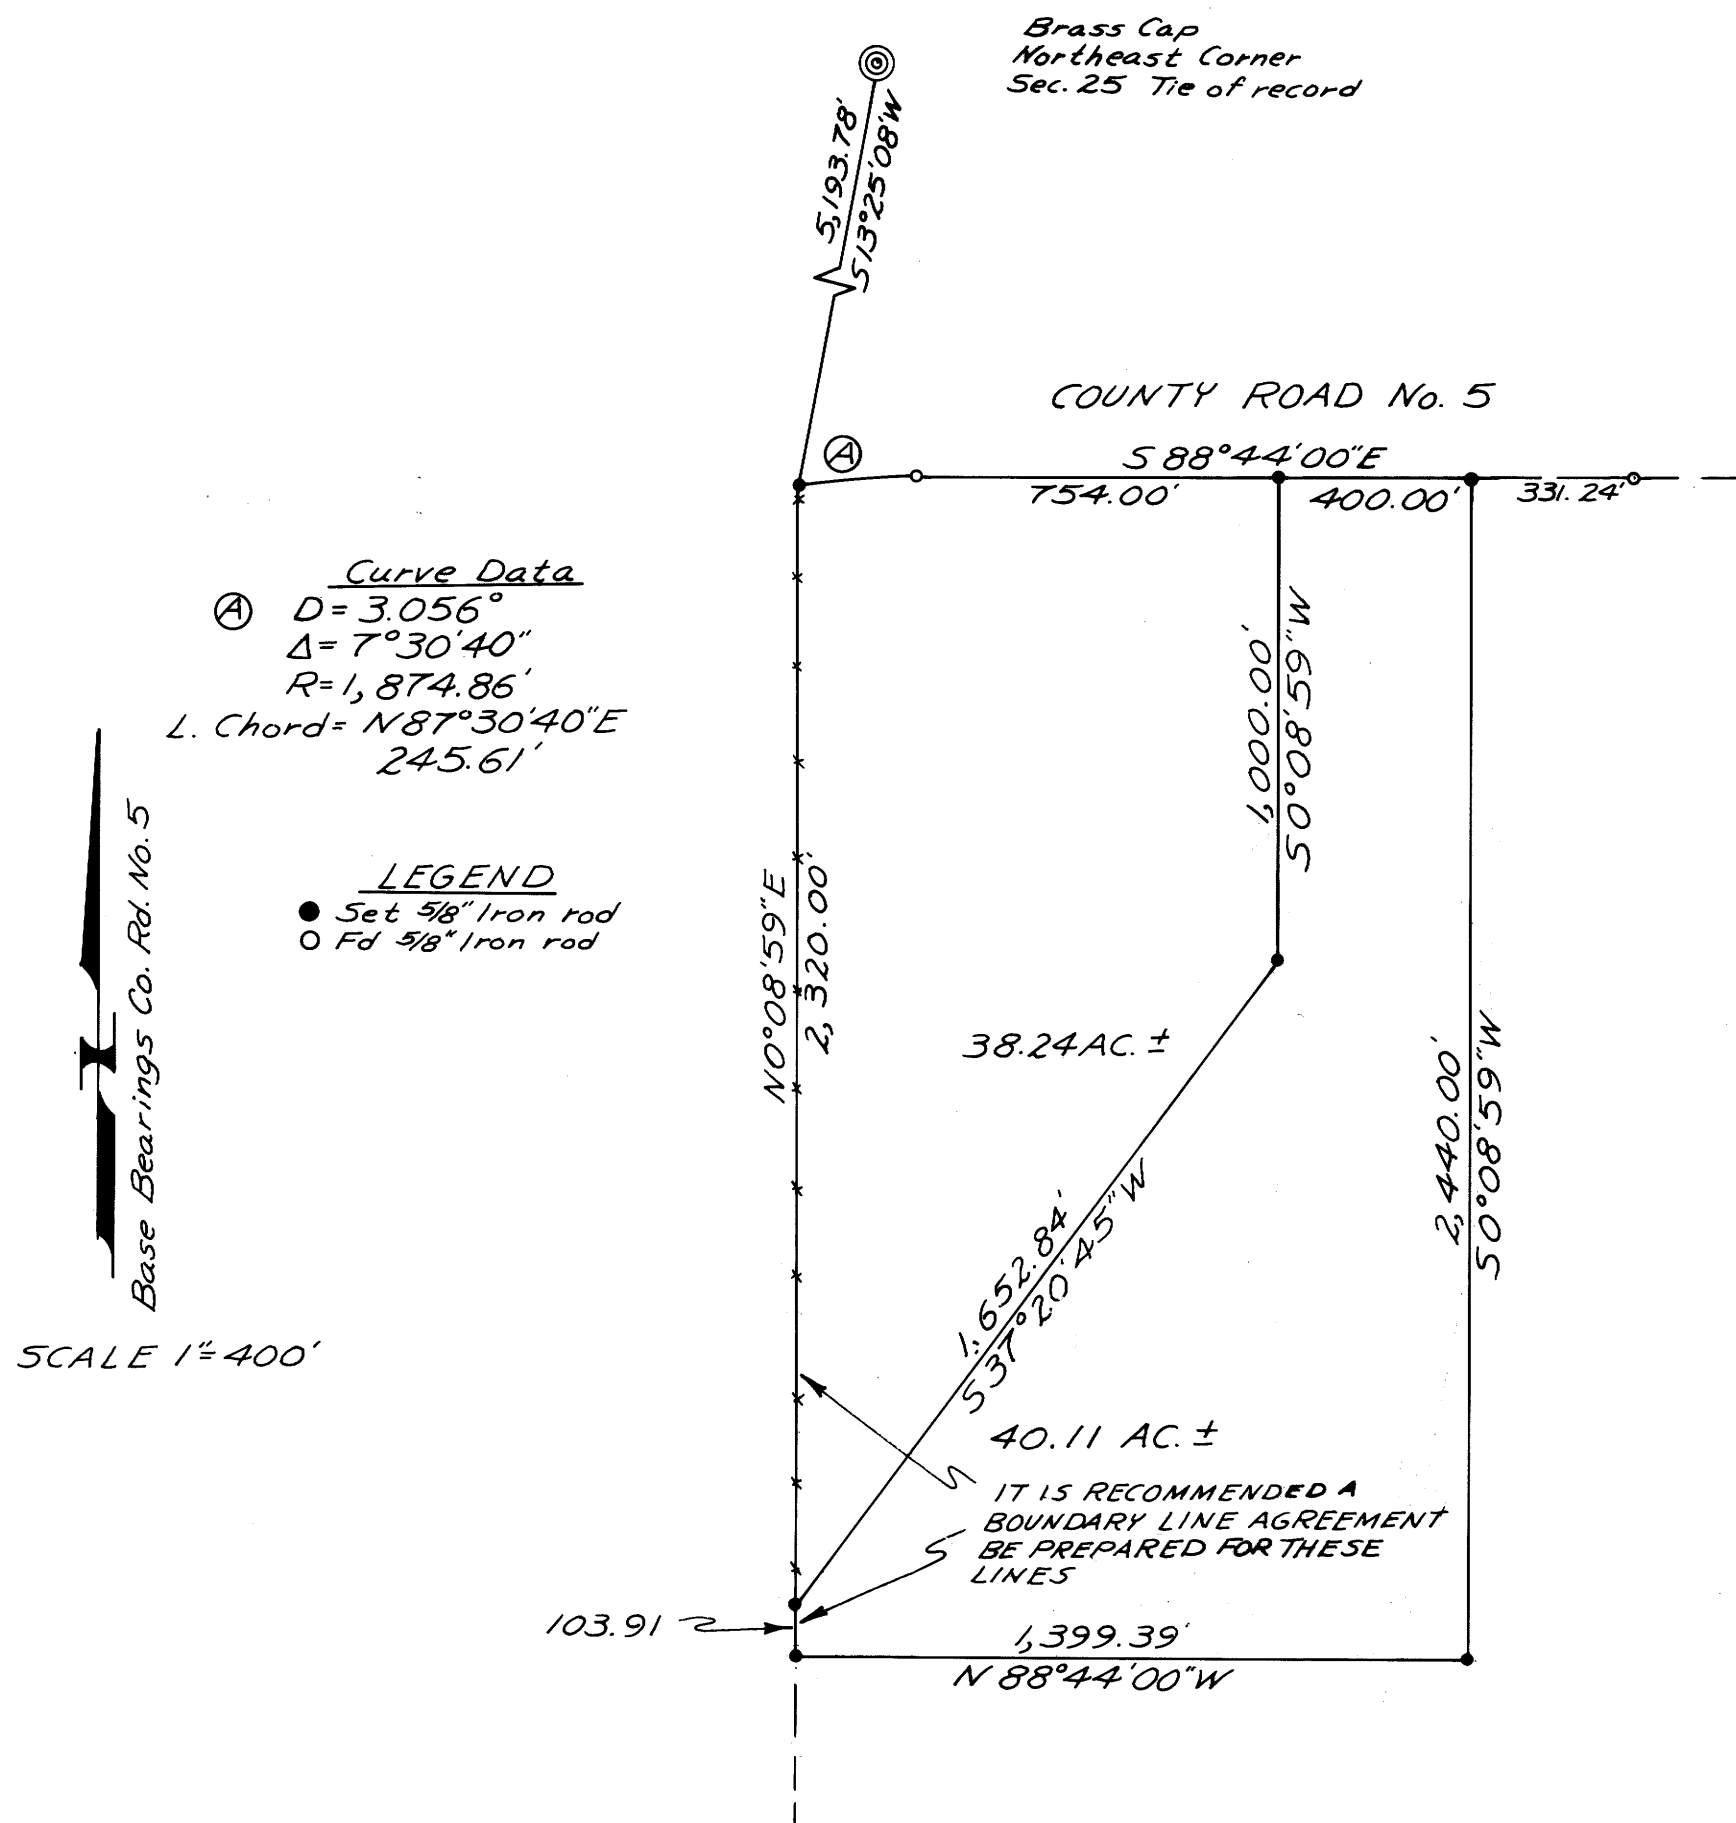

REGISTERED
PROFESSIONAL
LAND SURVEYOR

Robert L. Dolan

OREGON
JULY 30, 1976
ROBERT L. DOLAN
1076