


**COUNTY SURVEYORS FILE DATA**  
**DO NOT REMOVE FROM OFFICE**

SECT. 20, T.22S., R.8 W., W.M.  
for

RAY Monner  
MAY 1, 1979

EIKTON, ORC.  
1" = 50'

FILED *d*  
RECEIVED *TR*  
MAY 14 1979  
COUNTY SURVEYOR  
CLATSOP COUNTY, ORE.  
*TB*

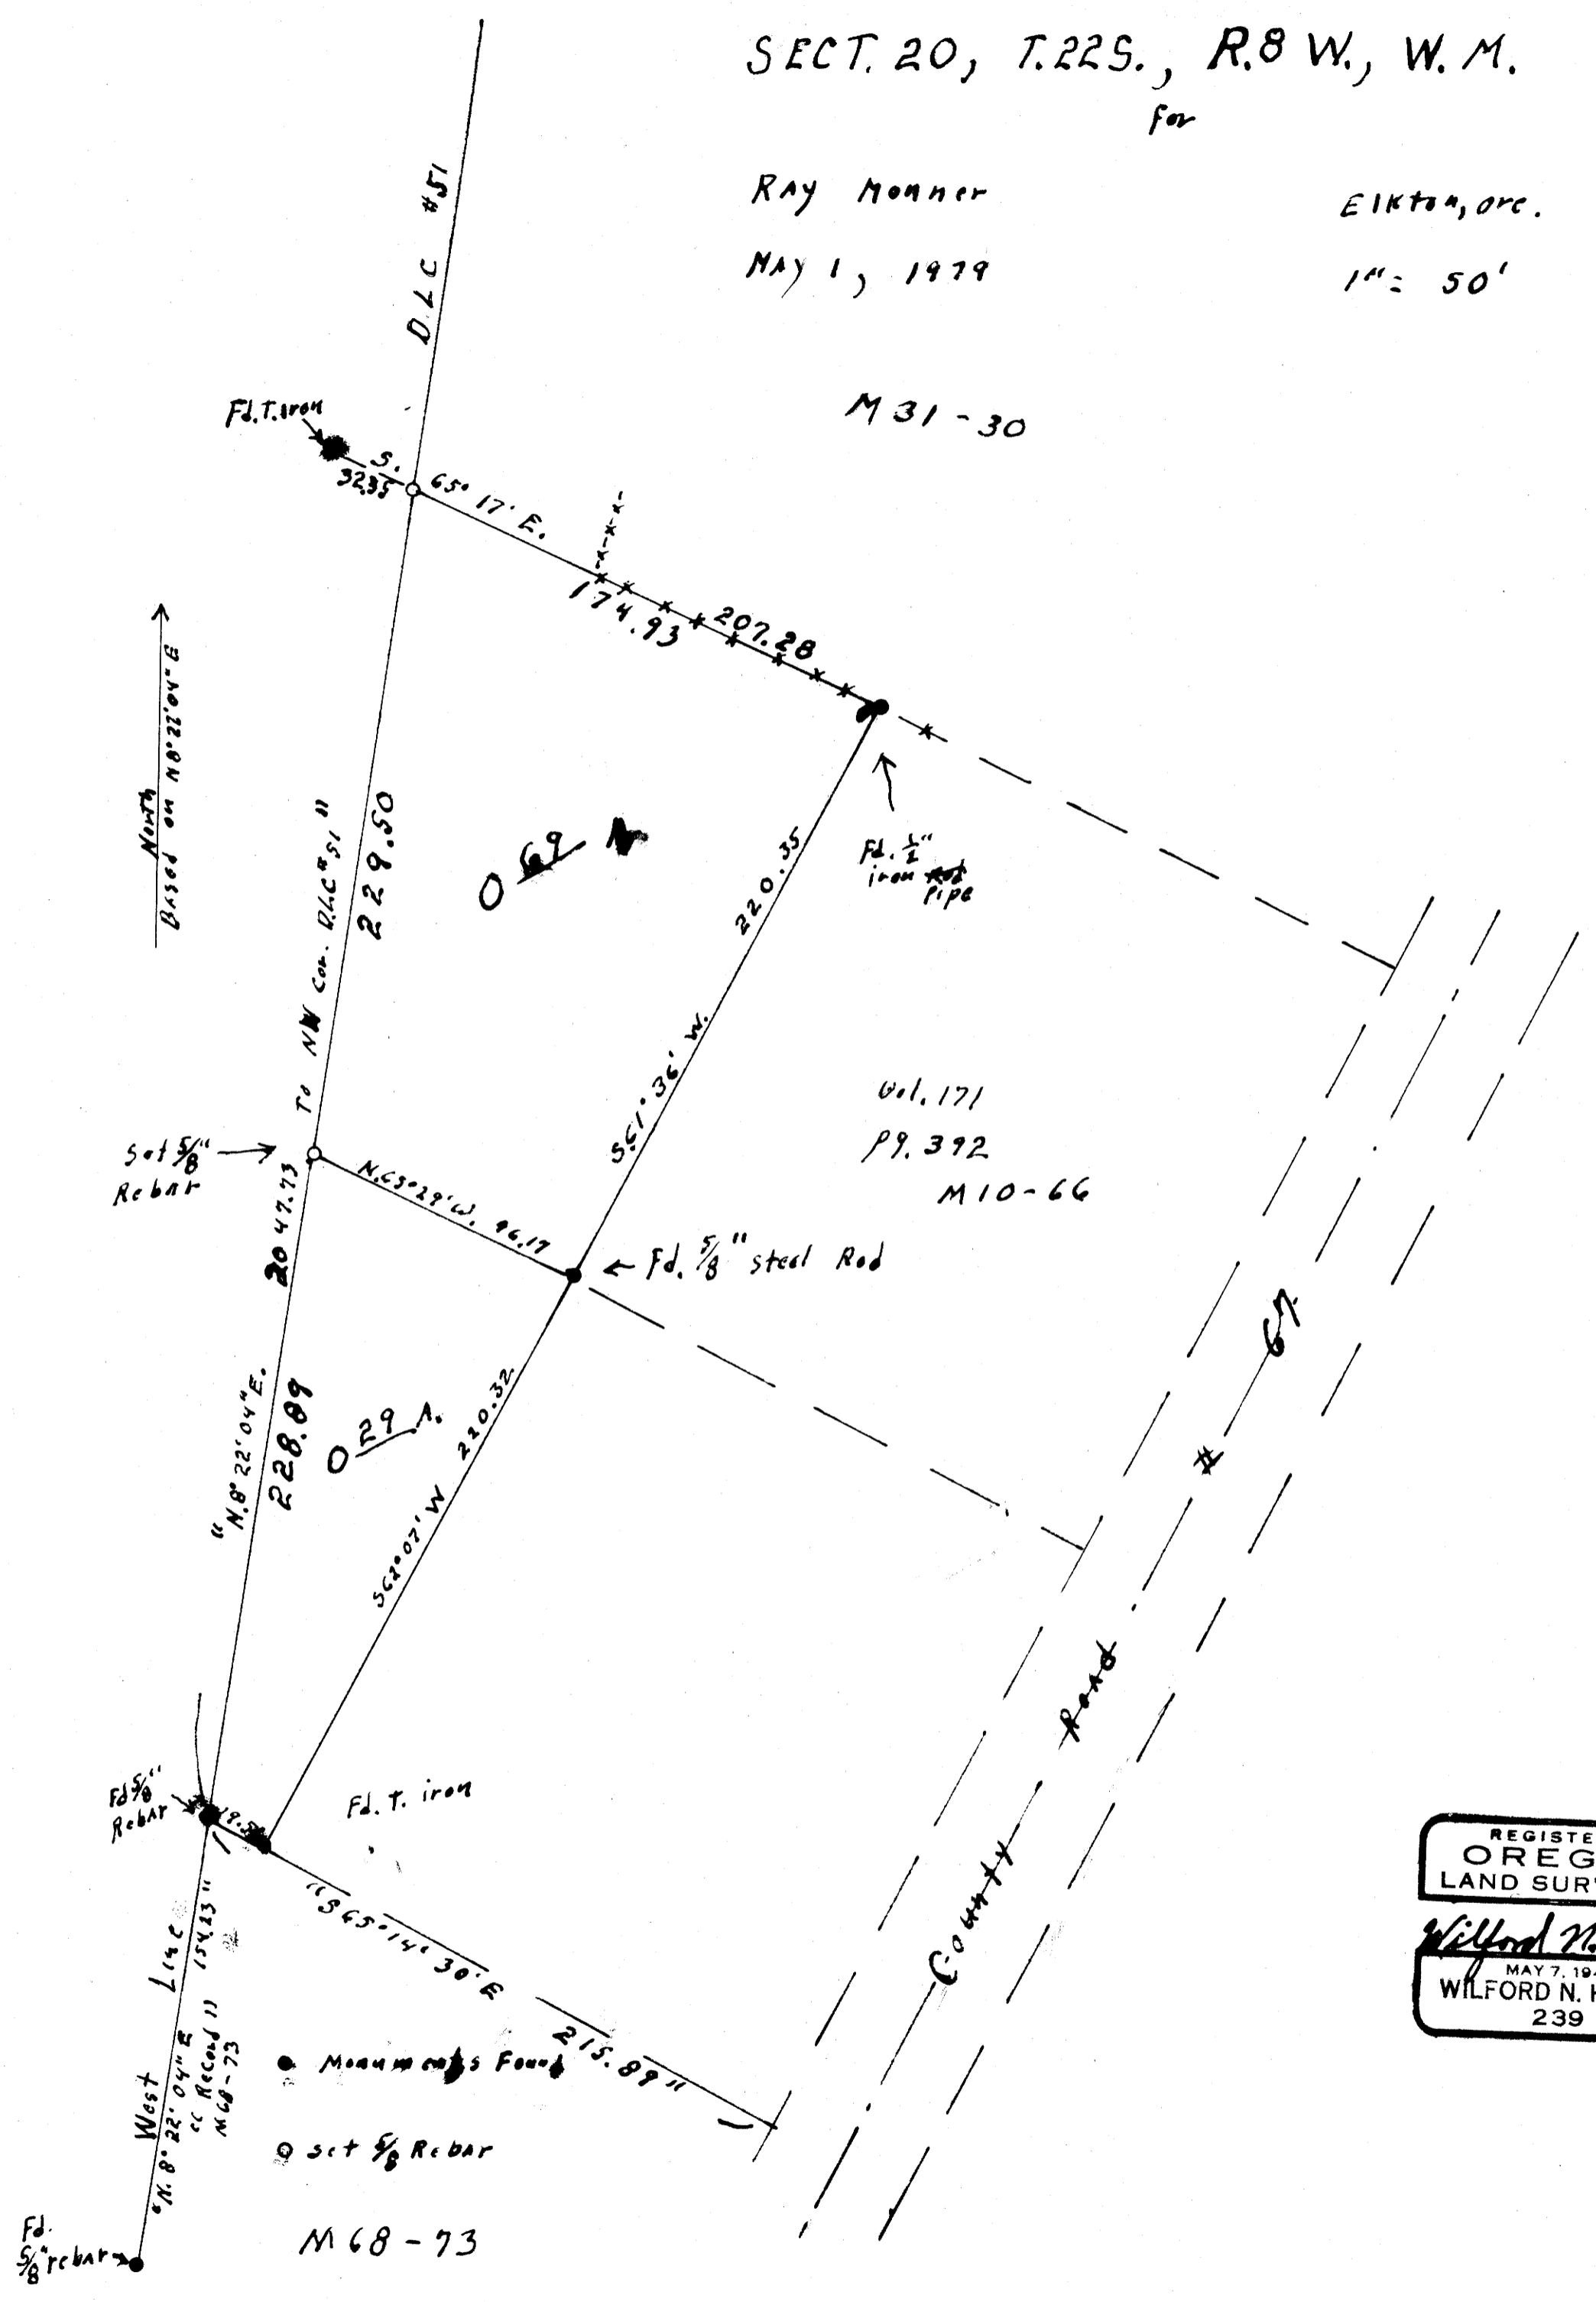

REGISTERED  
**OREGON**  
 LAND SURVEYOR  
*Wilford N. Haines*  
 MAY 7, 1948  
**WILFORD N. HAINES**  
 239