

COUNTY SURVEYORS FILE DATA  
DO NOT REMOVE FROM OFFICE

# SURVEY FOR DESCRIPTION

IN SECTION 17 T.26S.R.3W. W.M.

FOR: LONG & BROOKS

BY: BAUGHMAN TECHNICAL SERVICES INC.

MAY 1979

SCALE: 1"=50'

FILED *✓*  
RECEIVED *✓*


MAY 17 1979

COUNTY SURVEYOR  
WASCO COUNTY, ORE.

REGISTERED  
PROFESSIONAL  
LAND SURVEYOR

*Glenn S. Baughman*

OREGON  
GLENN S. BAUGHMAN  
536

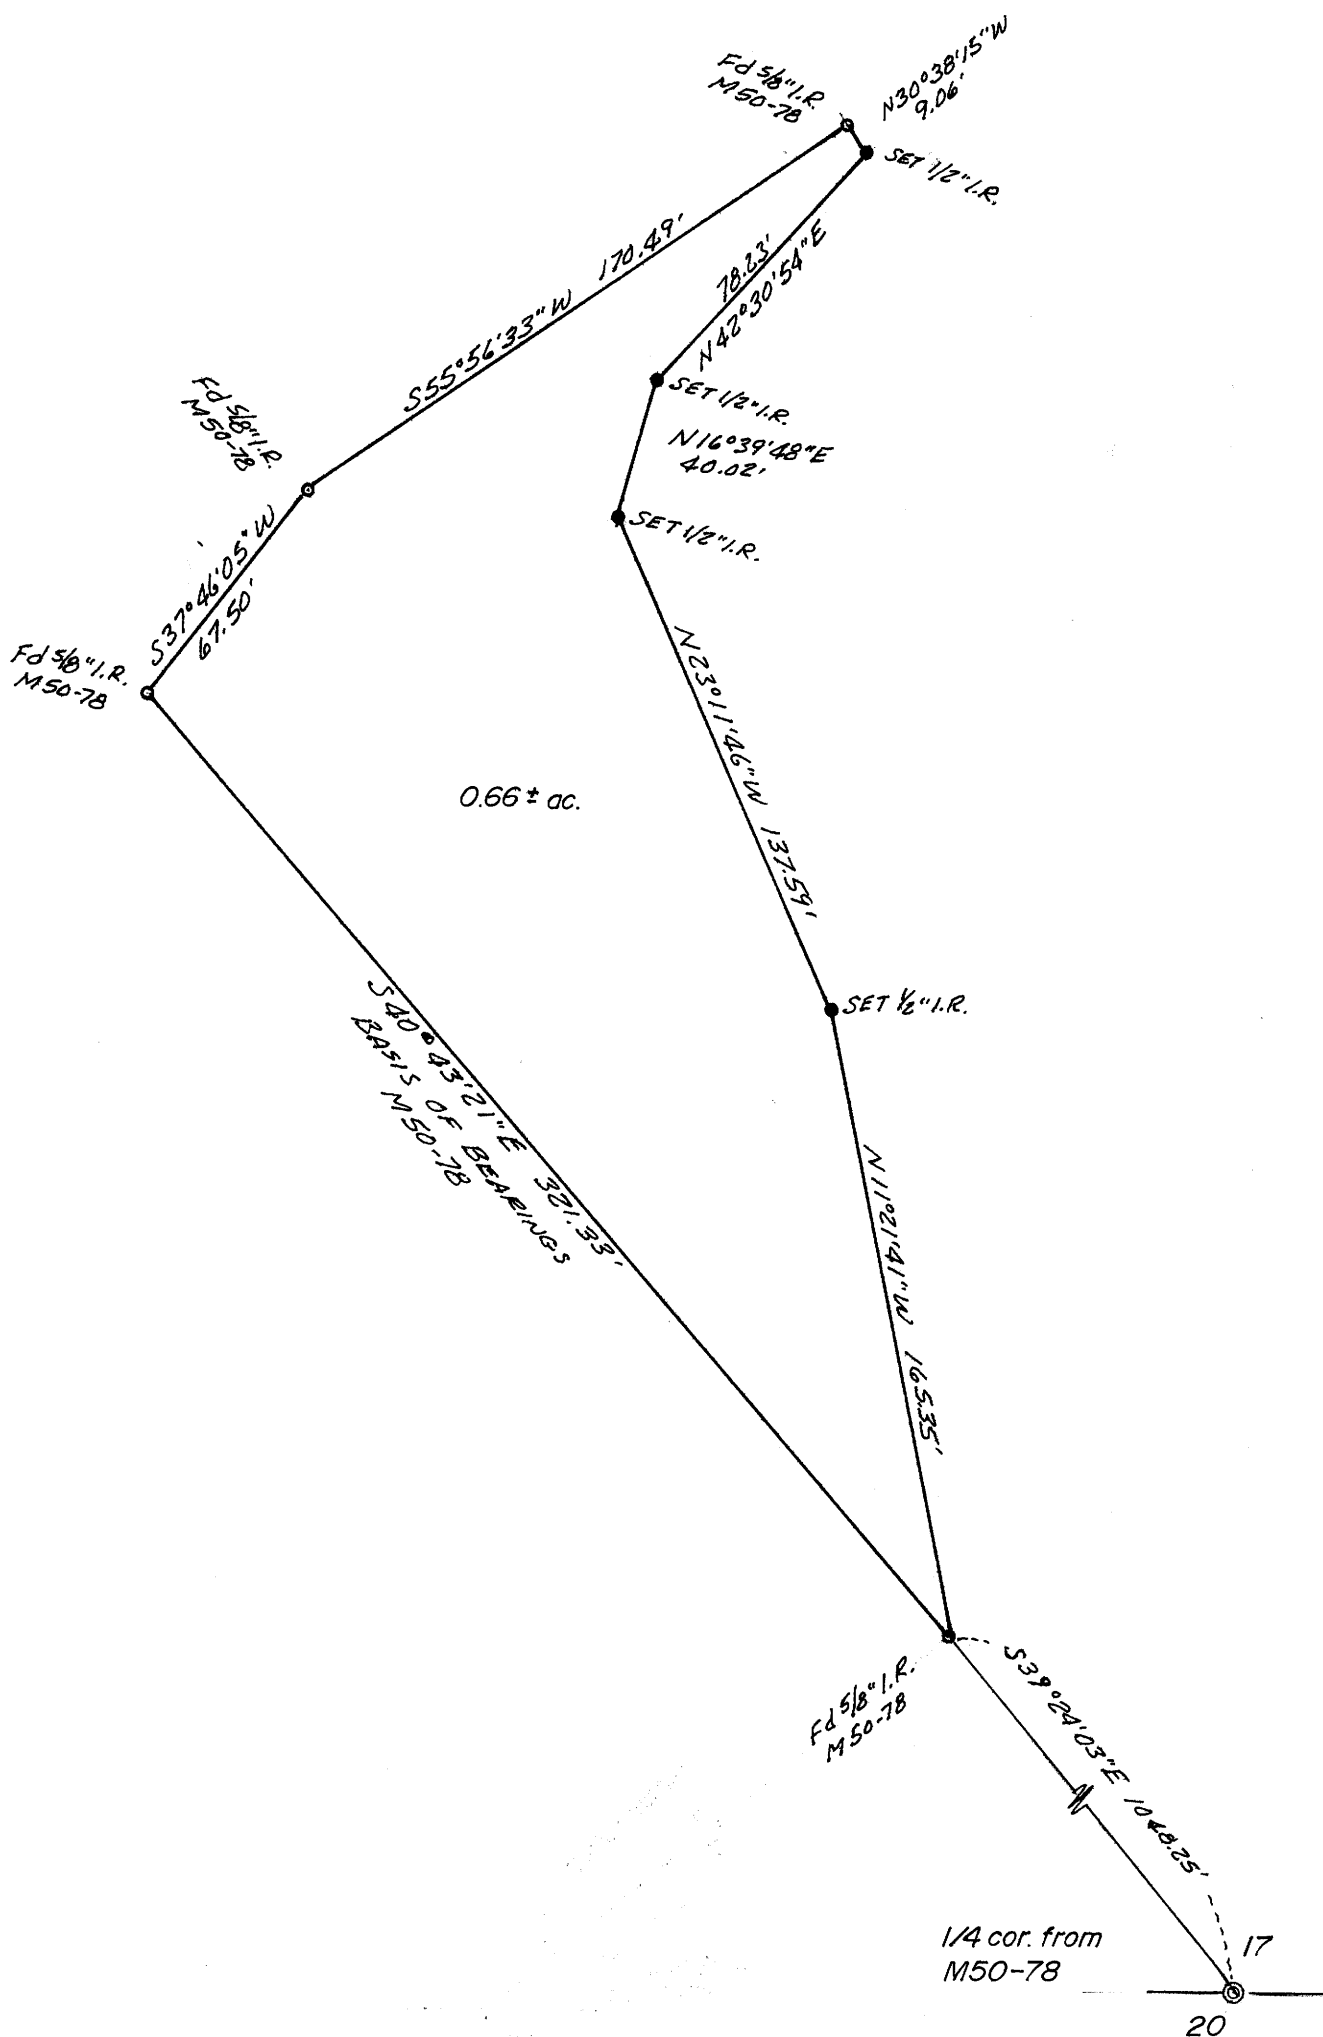

C Z Z I I C

FM 4-821